

Muskingum Co. Falls Twp.
4th 1/4 T.1 R.8 U.S.M.L.


CTR. RD. DIVISION	STATE	PROJECT
2	OHIO	

MUS-40-966
R/W PLAN
LIMITED ACCESS

3
5

The Ohio Power Co.

9
LA

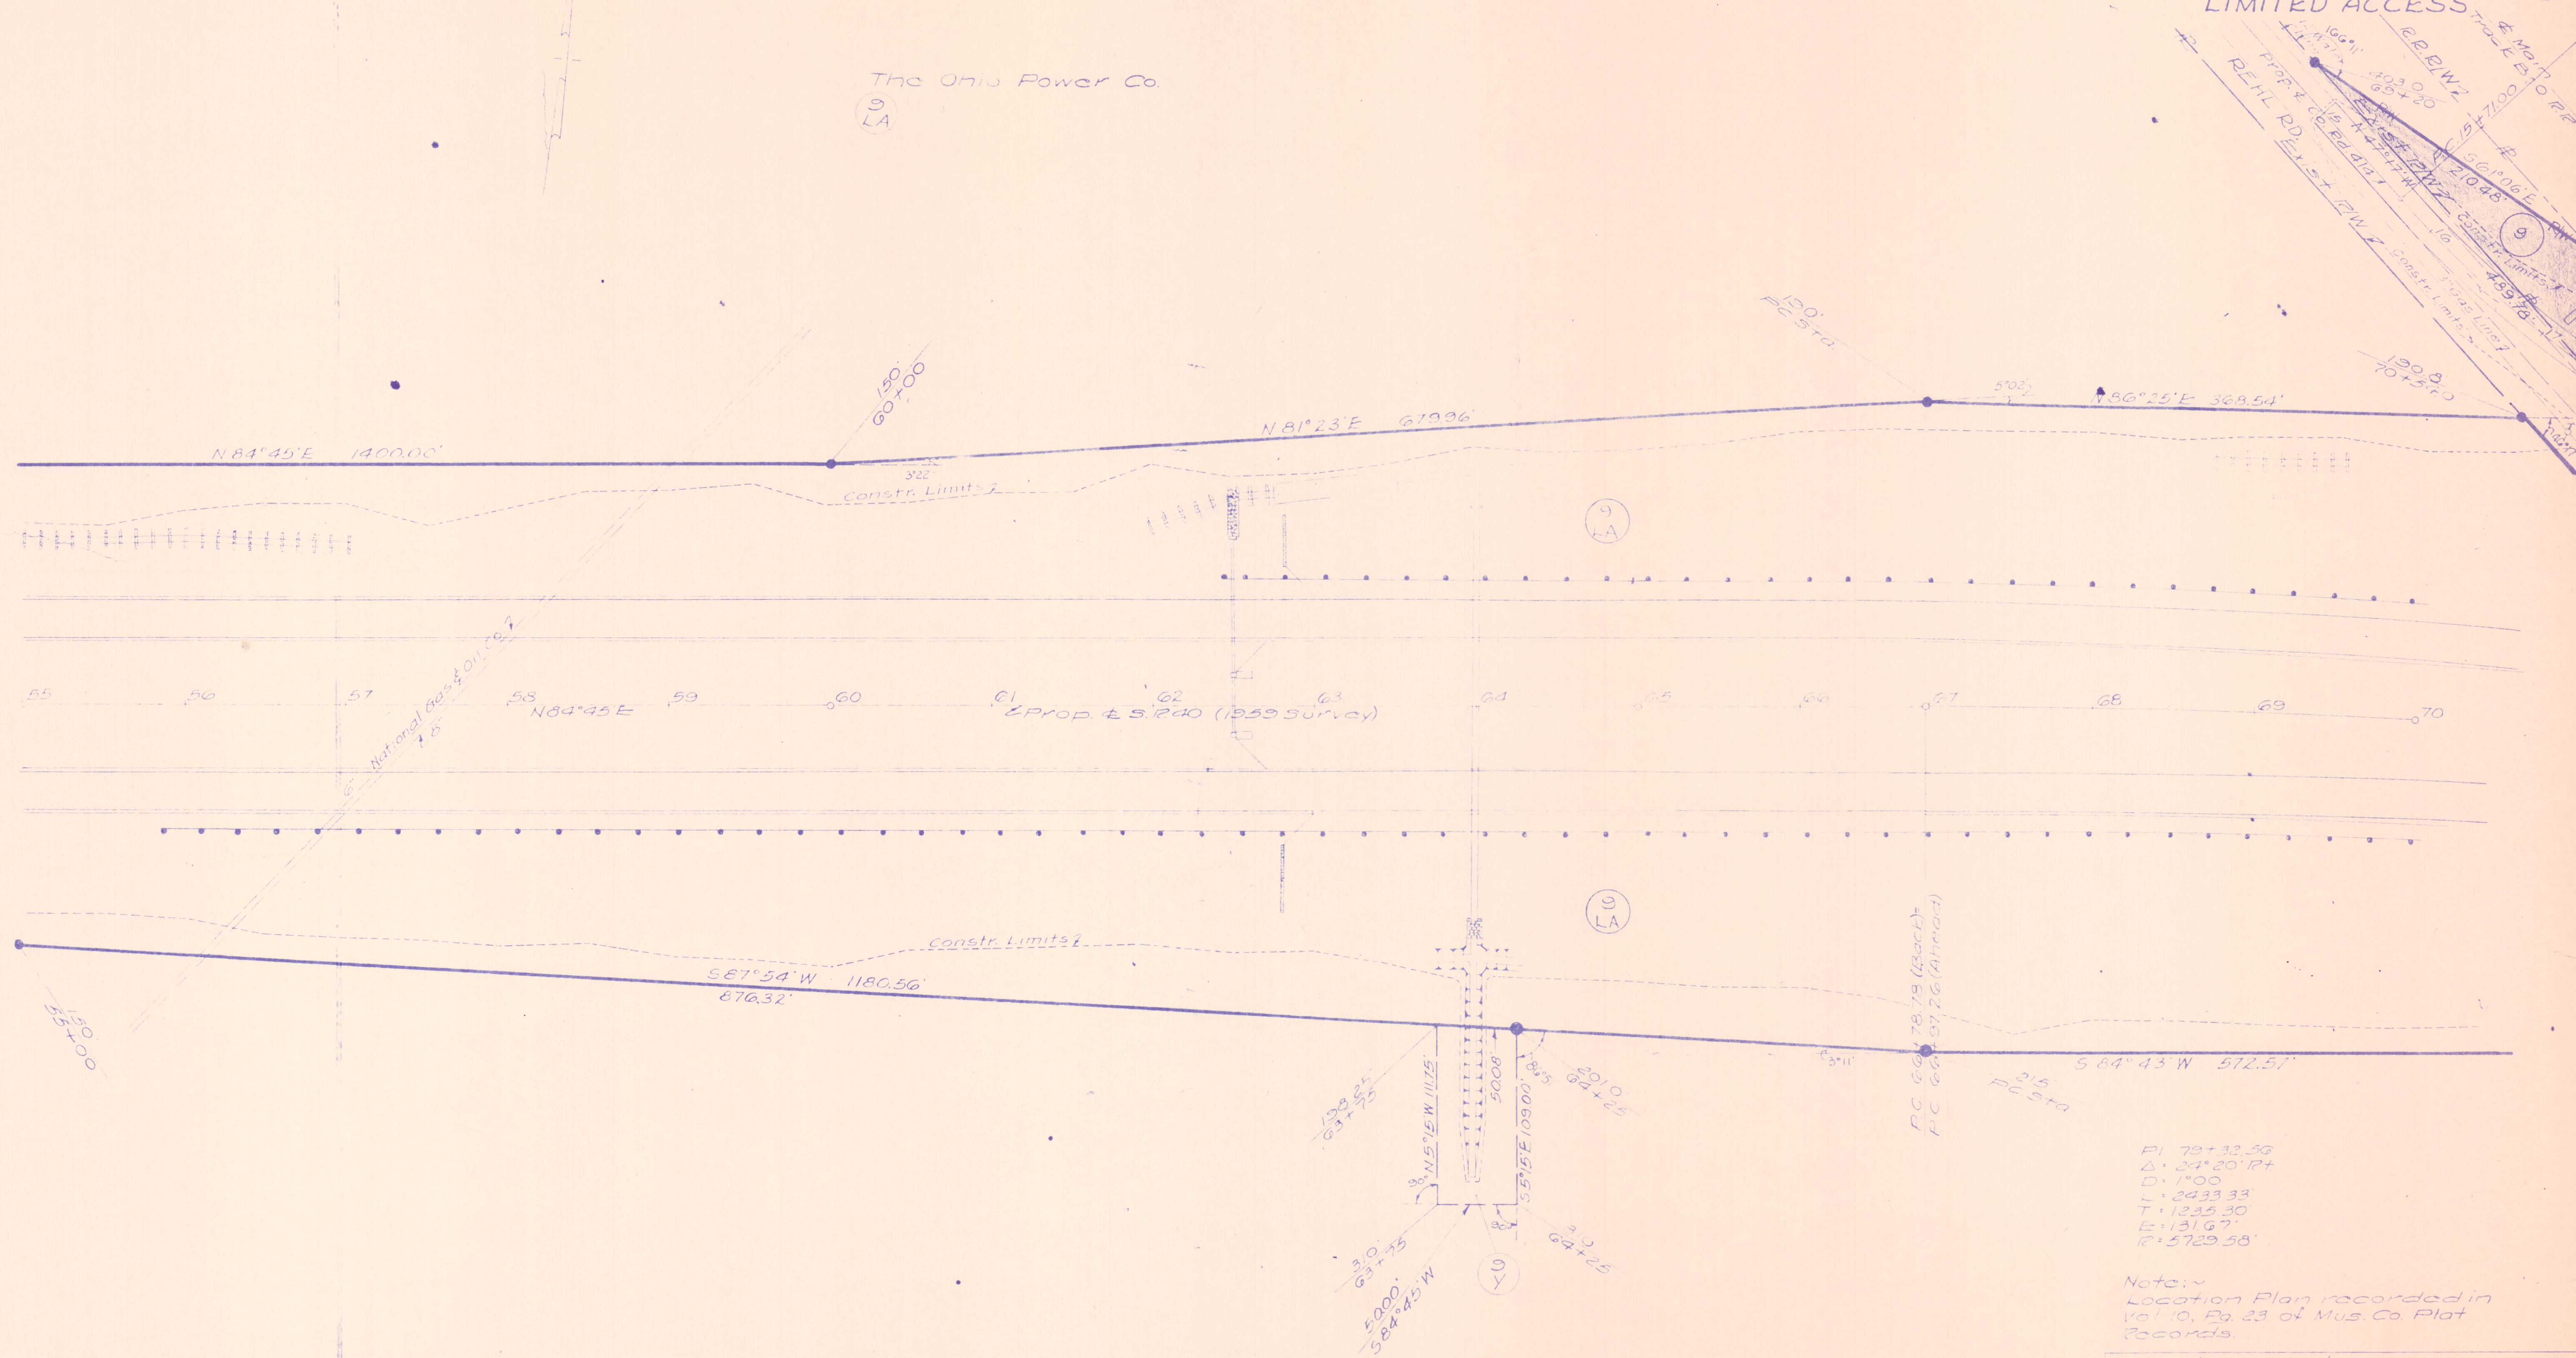

PI 79+32.56
Δ = 24° 20' 18"
D = 1° 00'
L = 2433.33
T = 1235.30
E = 131.67
R = 5723.58

Note:
Location Plan recorded in
Vol. 10, Pg. 23 of Mus. Co. Plat
Records.

Rev. Date	Description
1-23-60	Revised all Ohio Power Co. Parcels.
2-24-60	" " " " " "

The Ohio Power Co.
9 Cont. 22.29 Act
LA RPO 0.50 Act
9 Cont. 0.13 Act
Y