

Received _____ Time _____
 Recorded _____
 Plat Book _____ Page _____
 Signed _____ Recorder Mus. Co., Ohio
 Fee _____ Paid _____

Note: This instrument Prepared by the Ohio
 Dept. of Hwys. under the Supervision of
 F.B. Chappelcar P.E. No. 9347

Signed F. B. Chappelcar
 Registered Surveyor No. 1560
 Resident Division Deputy Director
 Date 1-13-58

LOCATION PLAN

MUS. ~ ~0.00~ MUSKINGUM COUNTY

NATIONAL ROAD (INTERSTATE HWY.)

LIMITED ACCESS



0' 300' 600' 900' 1200'
 Scale 1"=300'

GRATIOT

LICKING CO.
 MUSKINGUM CO.

774+30.63

LICKING CO.
 MUSKINGUM CO.
 RANGE 16 BOWLING GREEN TWP.
 RANGE 15 HOPEWELL TWP.

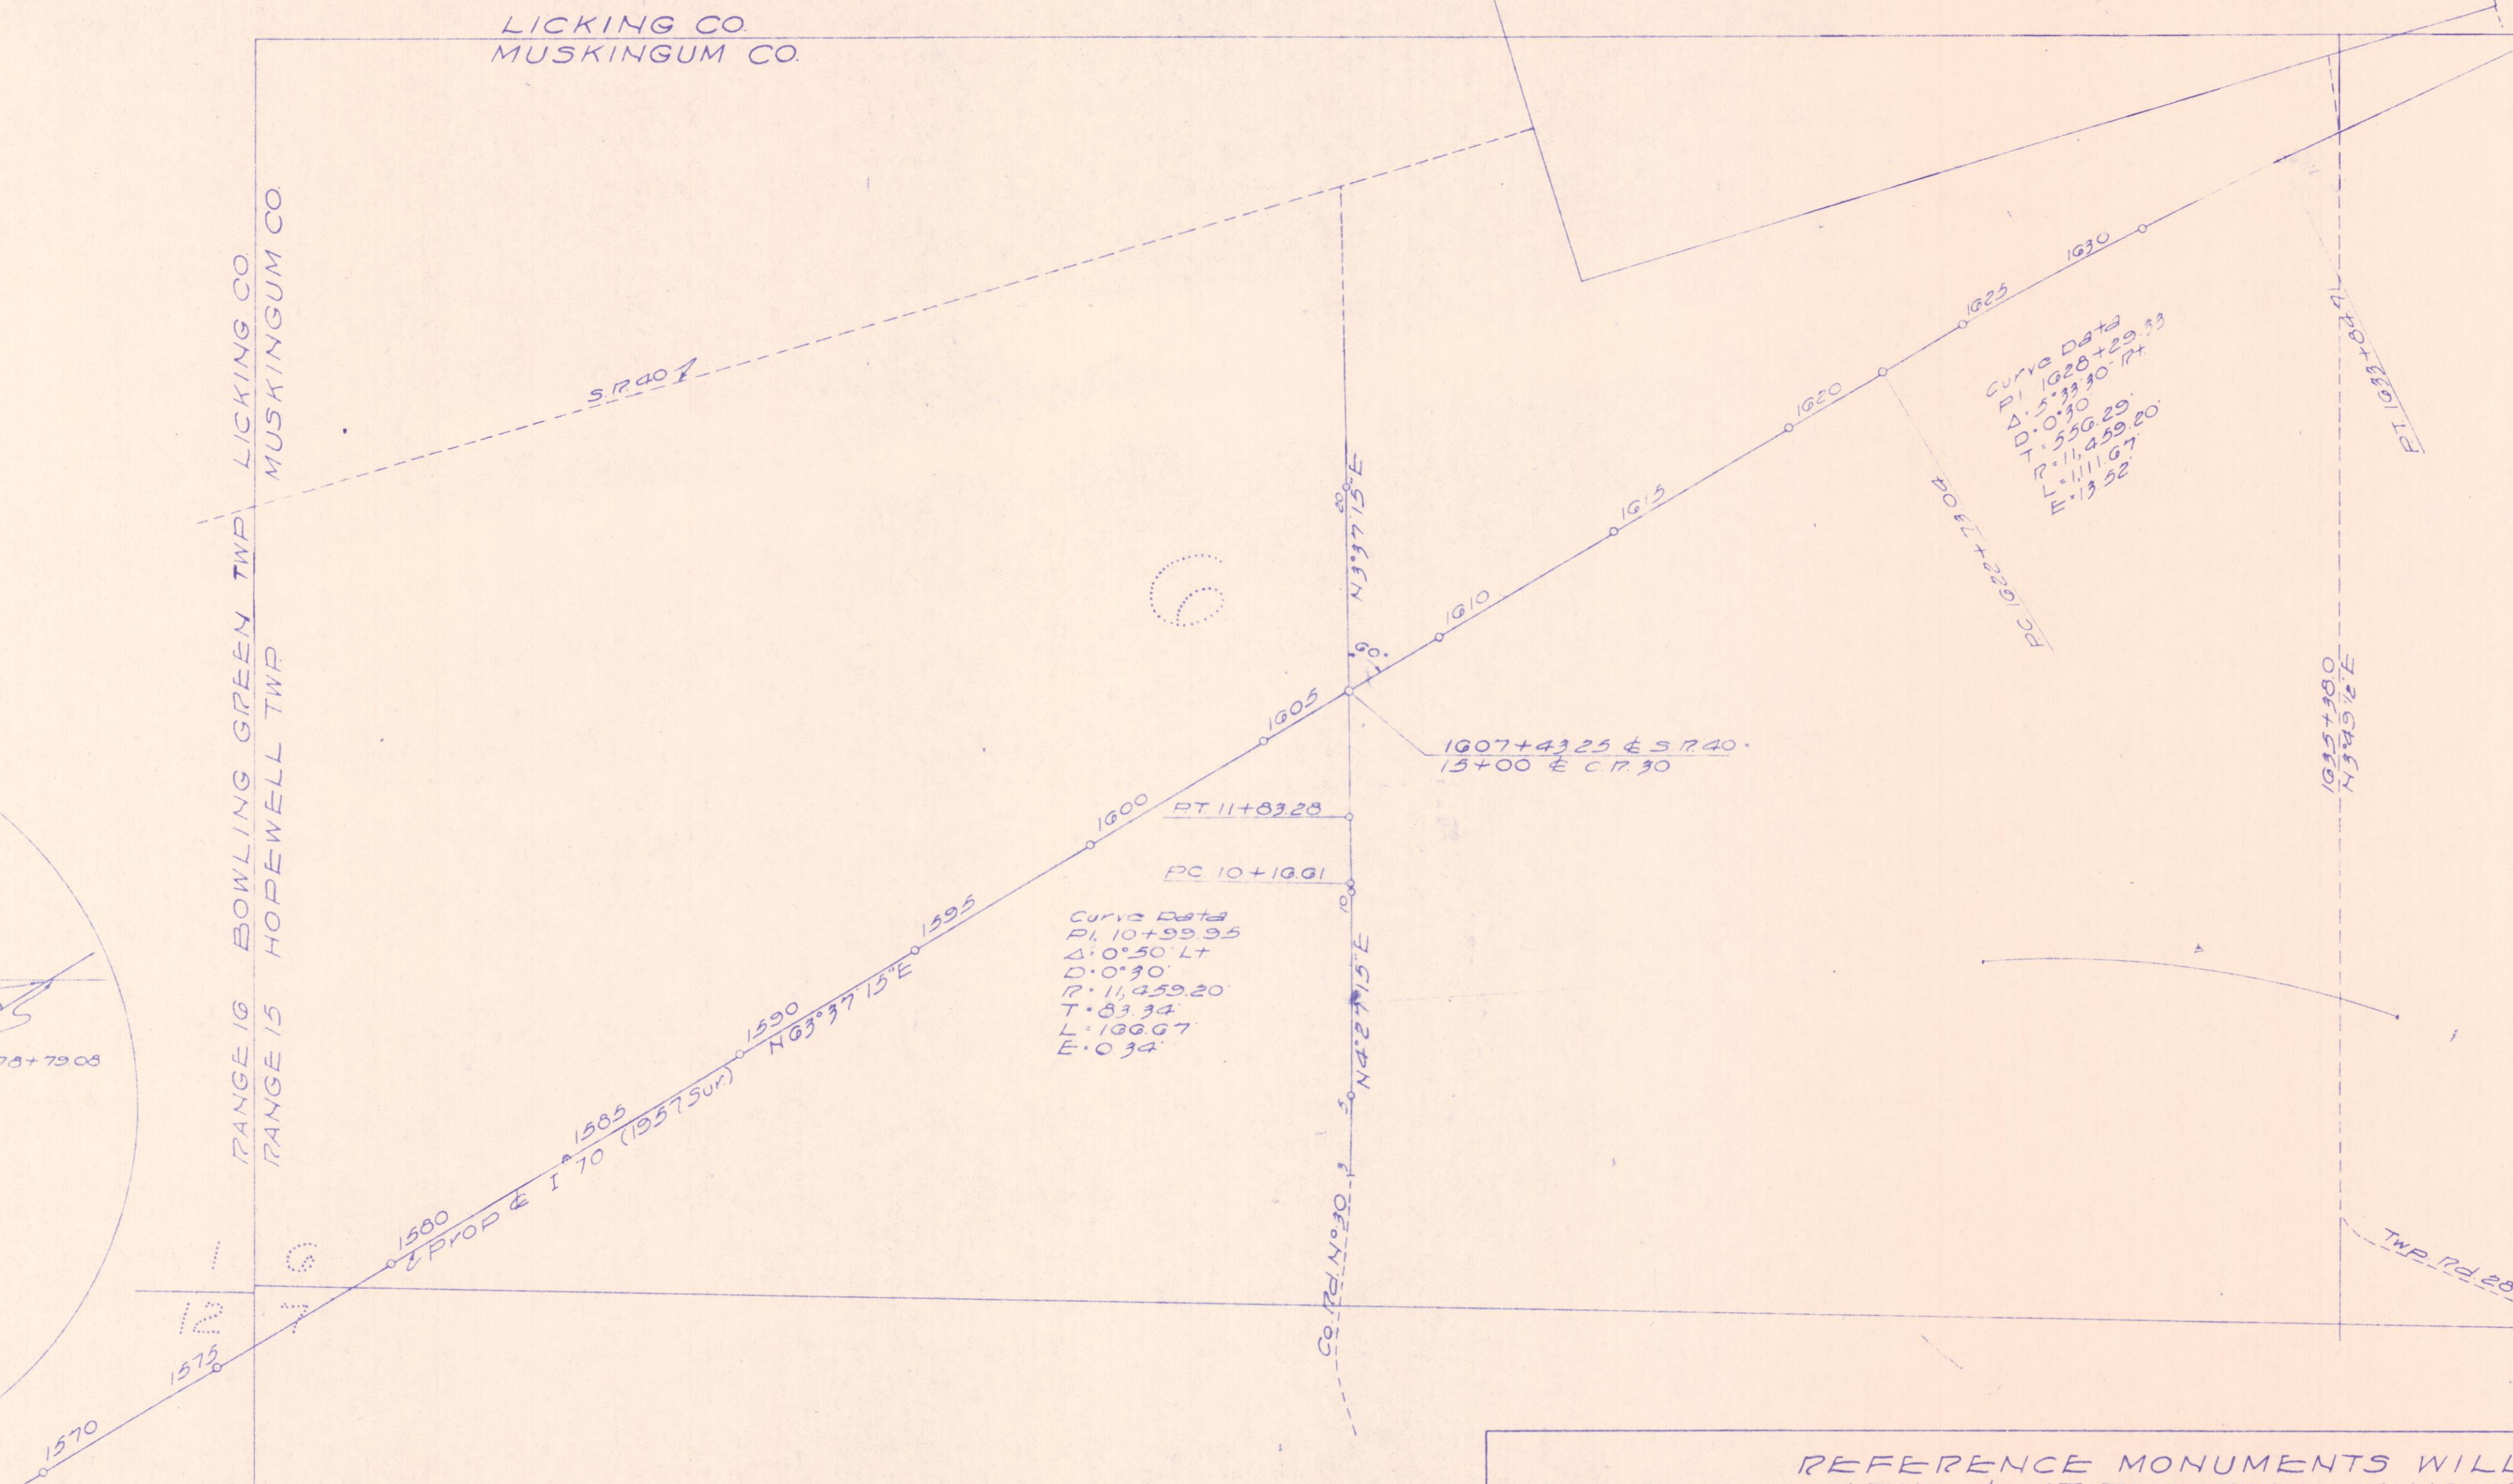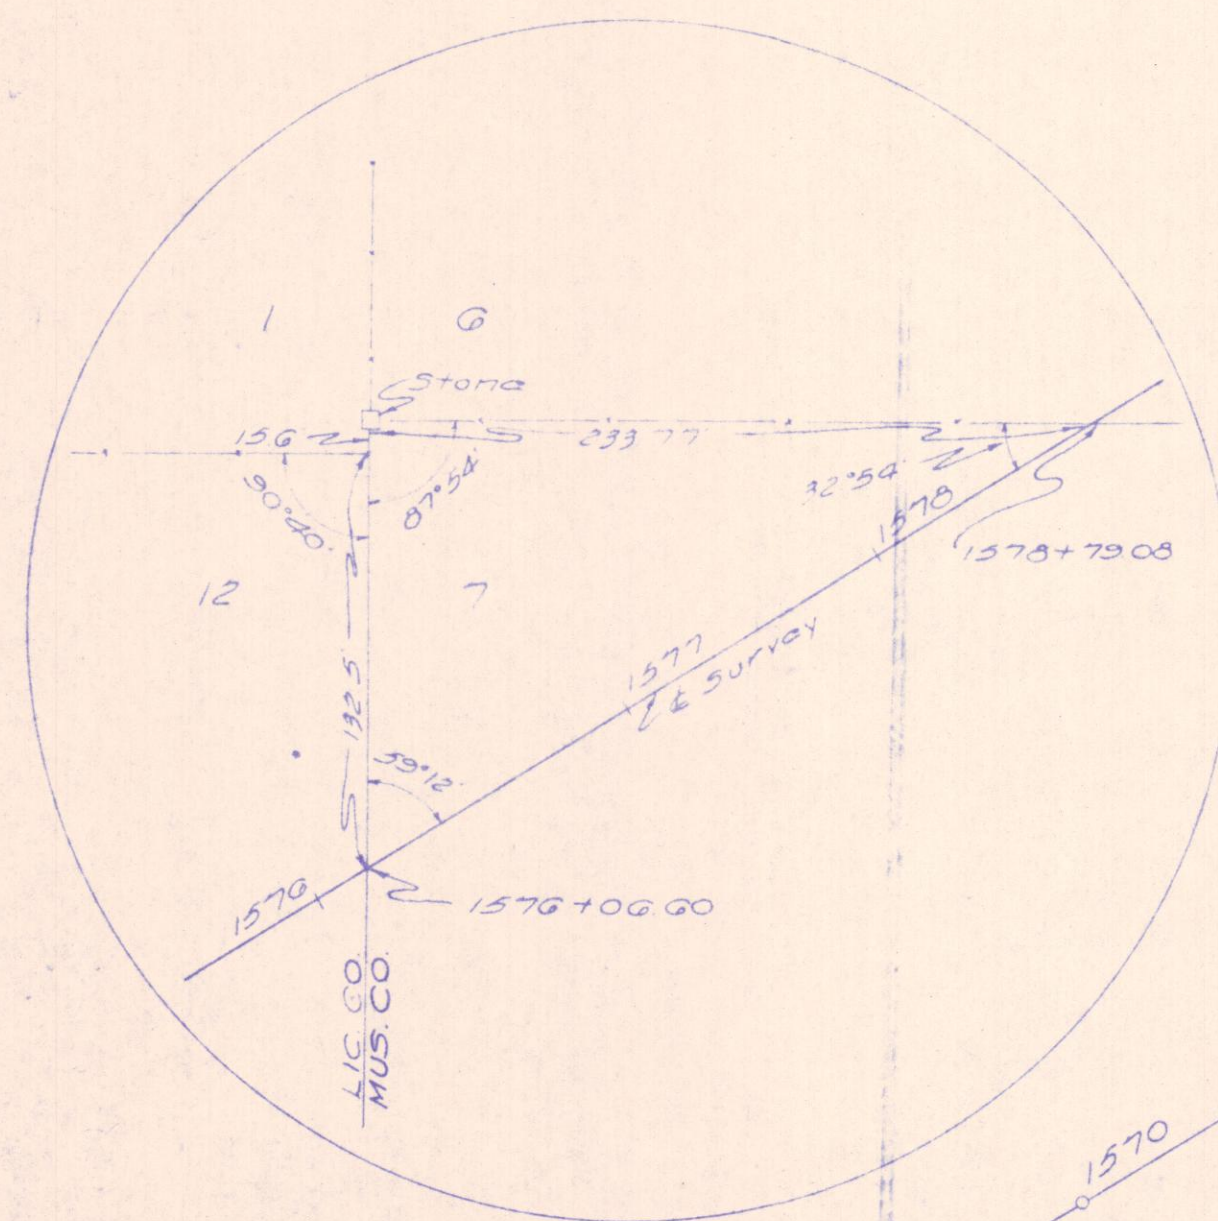

Note:
 & Reference Monuments
 consisting of iron pins set in
 concrete were placed by the
 Project Contractor in 1959.

REFERENCE MONUMENTS WILL BE SET
 ON THE & AT THE FOLLOWING STATIONS
 AFTER CONSTRUCTION

P.O.T. STA. 1580+00	P.O.T. STA. 1615+00	P.O.T. STA. 750+00
P.O.T. STA. 1585+00	P.O.T. STA. 1620+00	P.O.T. STA. 755+00
P.O.T. STA. 1590+00	P.C. STA. 1622+73.04	P.C. STA. 757+63.50
P.O.T. STA. 1595+00	P.O.C. STA. 1630+00	P.O.C. STA. 762+00
P.O.T. STA. 1600+00	P.T. STA. 1633+84.71	P.T. STA. 765+58.59
P.O.T. STA. 1605+00	P.O.T. STA. 1635+73.00	P.O.T. STA. 769+49.39
P.O.T. STA. 1610+00	P.O.T. STA. 745+00	P.O.T. STA. 773+00