


File A-14

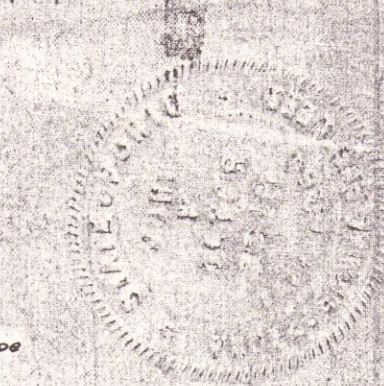

K/S with plate
OK

Project Completed Aug 1938

Book A-82
Line # Elevs.

