F.E.R.A. PROJECT No.

MUSKINGUM COUNTY

COUNTY ROAD NO. 72

WAYNE TOWNSHIP

SCALE: 1 IN. = 50 FT.

File A-14

Project Completed Aug 1938

Book A-82
Line & Elevs.

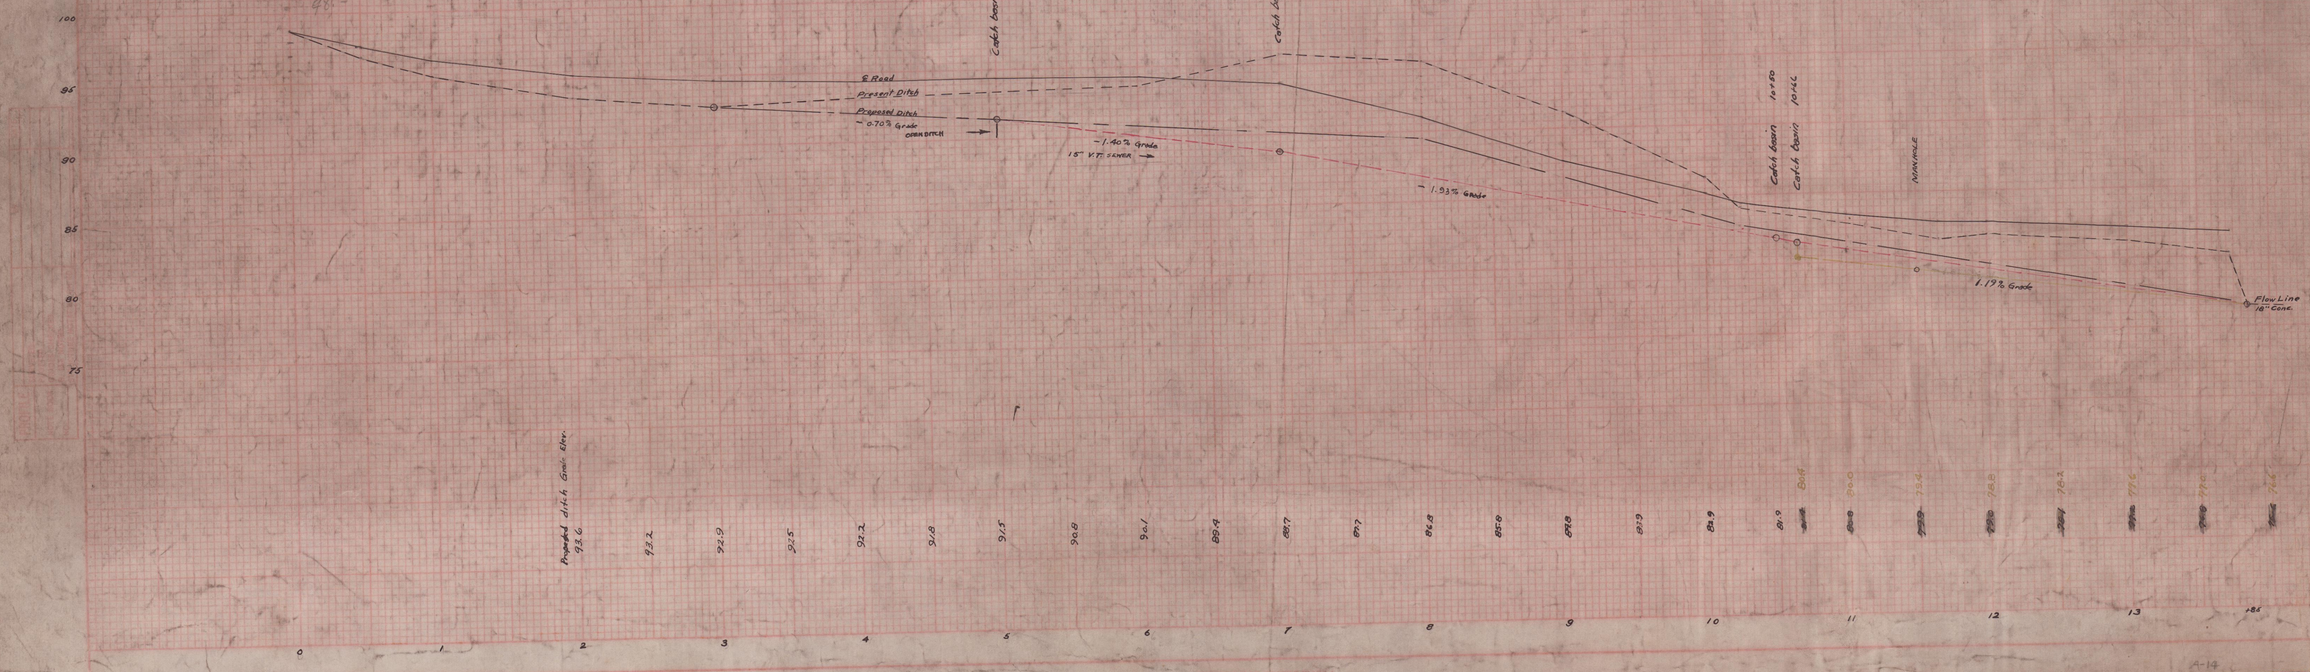

C-72

A-14