



STATION	AREAS		VOLUMES		CUMULATIVE VOLUMES	
	CUT	FILL	CUT	FILL	CUT	FILL
0+00	8.11	0.00	9.96	0.00	9.96	0.00
0+25	13.40	0.00	17.28	0.00	27.24	0.00
0+50	23.92	0.00	28.27	0.00	55.50	0.00
0+75	37.13	0.00	32.24	0.00	87.75	0.00
1+00	32.51	0.00	29.64	0.00	117.38	0.00
1+25	31.50	0.00	23.27	0.00	140.66	0.00
1+50	18.77	0.00	16.22	0.00	156.88	0.00
2+00	16.62	0.00	15.23	0.00	172.11	0.00
2+25	15.14	0.00	14.71	0.00	186.81	0.00
2+50	23.37	0.00	17.83	0.00	204.64	0.00
2+75	107.24	0.00	60.46	0.00	265.11	0.00
3+00	61.94	0.00	78.32	0.00	343.43	0.00
3+25	11.88	0.00	34.18	0.00	377.60	0.00
			0.00	0.00	377.60	0.00

STATION	AREAS		VOLUMES		CUMULATIVE VOLUMES	
	CUT	FILL	CUT	FILL	CUT	FILL
0+00	4.16	1.00	14.16	0.46	14.16	0.46
0+25	26.43	0.00	53.82	0.00	67.98	0.46
0+50	89.82	0.00	82.65	0.00	150.63	0.46
0+75	88.71	0.00	83.92	0.00	234.55	0.46
1+00	92.57	0.00	85.95	0.00	320.50	0.46
1+25	93.08	0.00	83.04	0.00	403.54	0.46
1+50	86.30	0.00	68.74	0.00	472.28	0.46
1+75	62.18	0.00	45.19	0.00	517.47	0.46
2+00	35.42	0.00	22.97	0.00	540.44	0.46
2+25	14.20	0.00	7.70	0.00	548.14	0.46
2+50	2.42	0.00	0.00	0.00	548.14	0.46

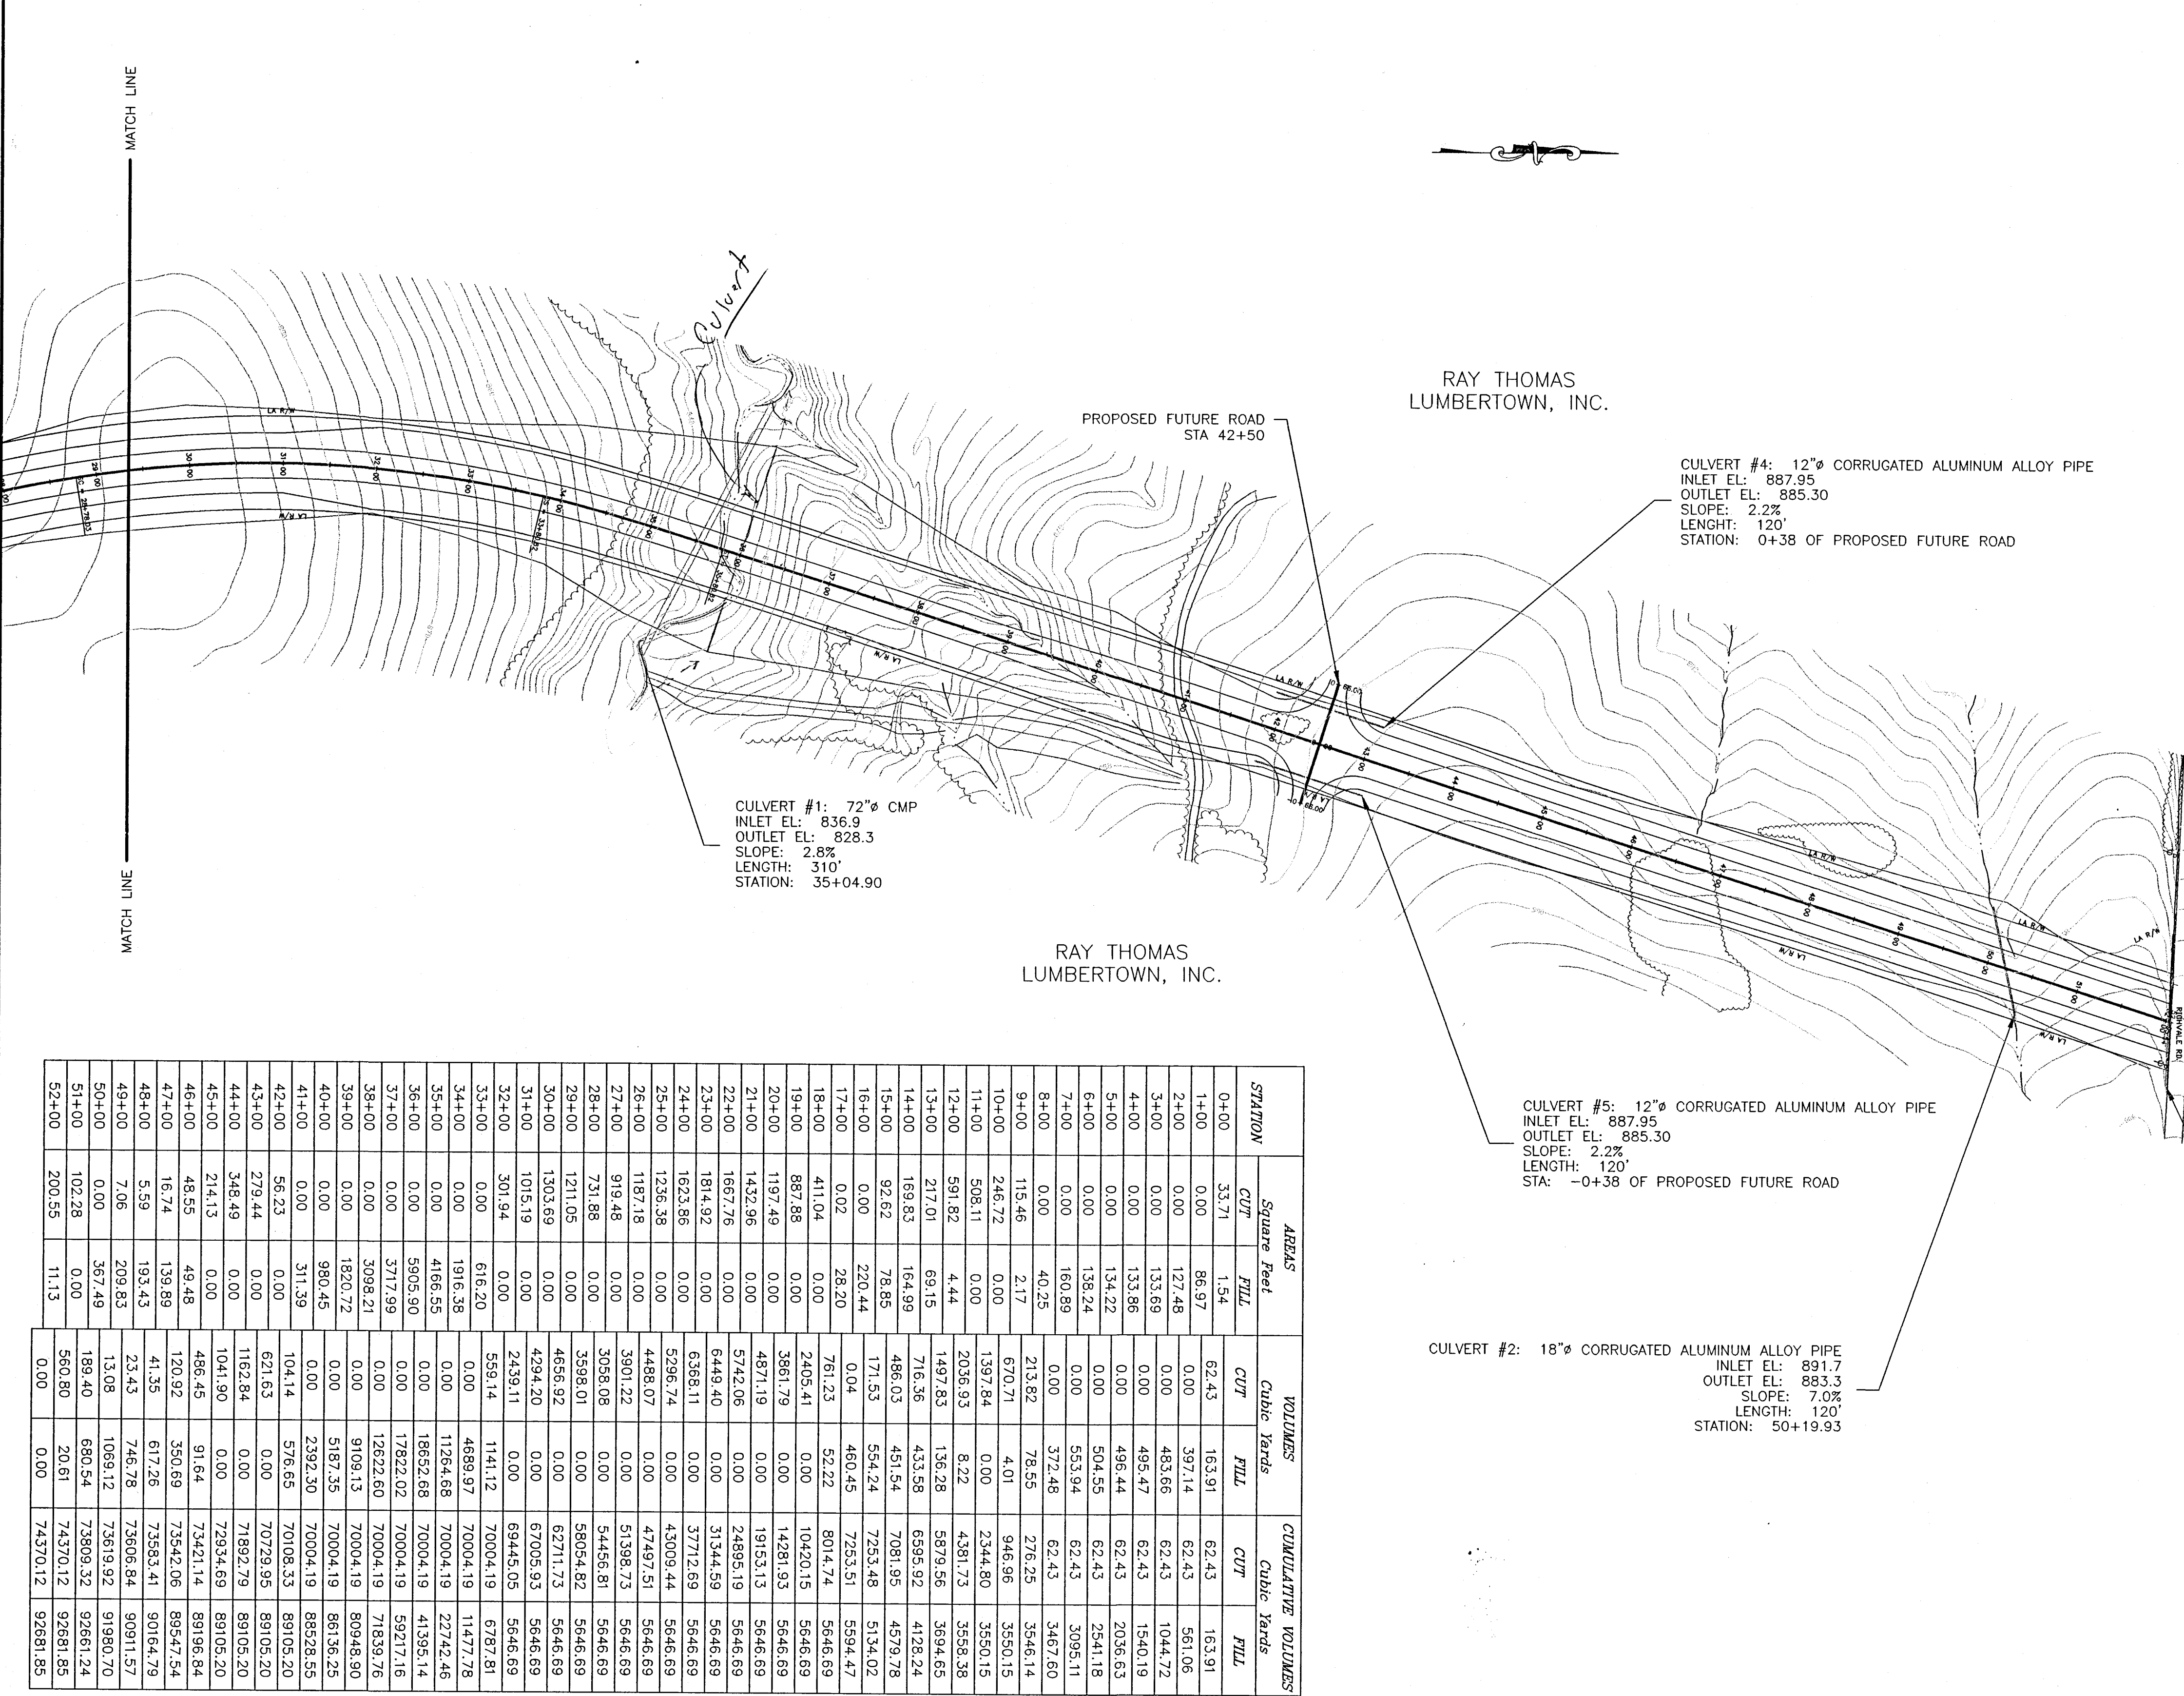

The JFW Company
1218 St. Rt. 93 NE
New Lexington, Ohio 43764 (614) 342-5131

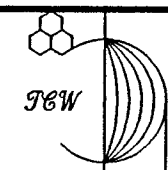

ENGINEERING
SURVEYING
RESOURCE DEVELOPMENT

MUSKINGUM COUNTY ENGINEERING OFFICE
155 REHL ROAD
ZANESVILLE, OHIO 43701

SCALE	1" = 100'	CHECKED	TCW
DATE	1/6/98	APPROVED	
REVISED	2/11/98	CERTIFIED	
DRAWN	VP Jr.		

MUSKINGUM COUNTY
COUNTY ROAD 723 PROJECT
PLANS
PLAN VIEW
EARTHWORK QUANTITIES