



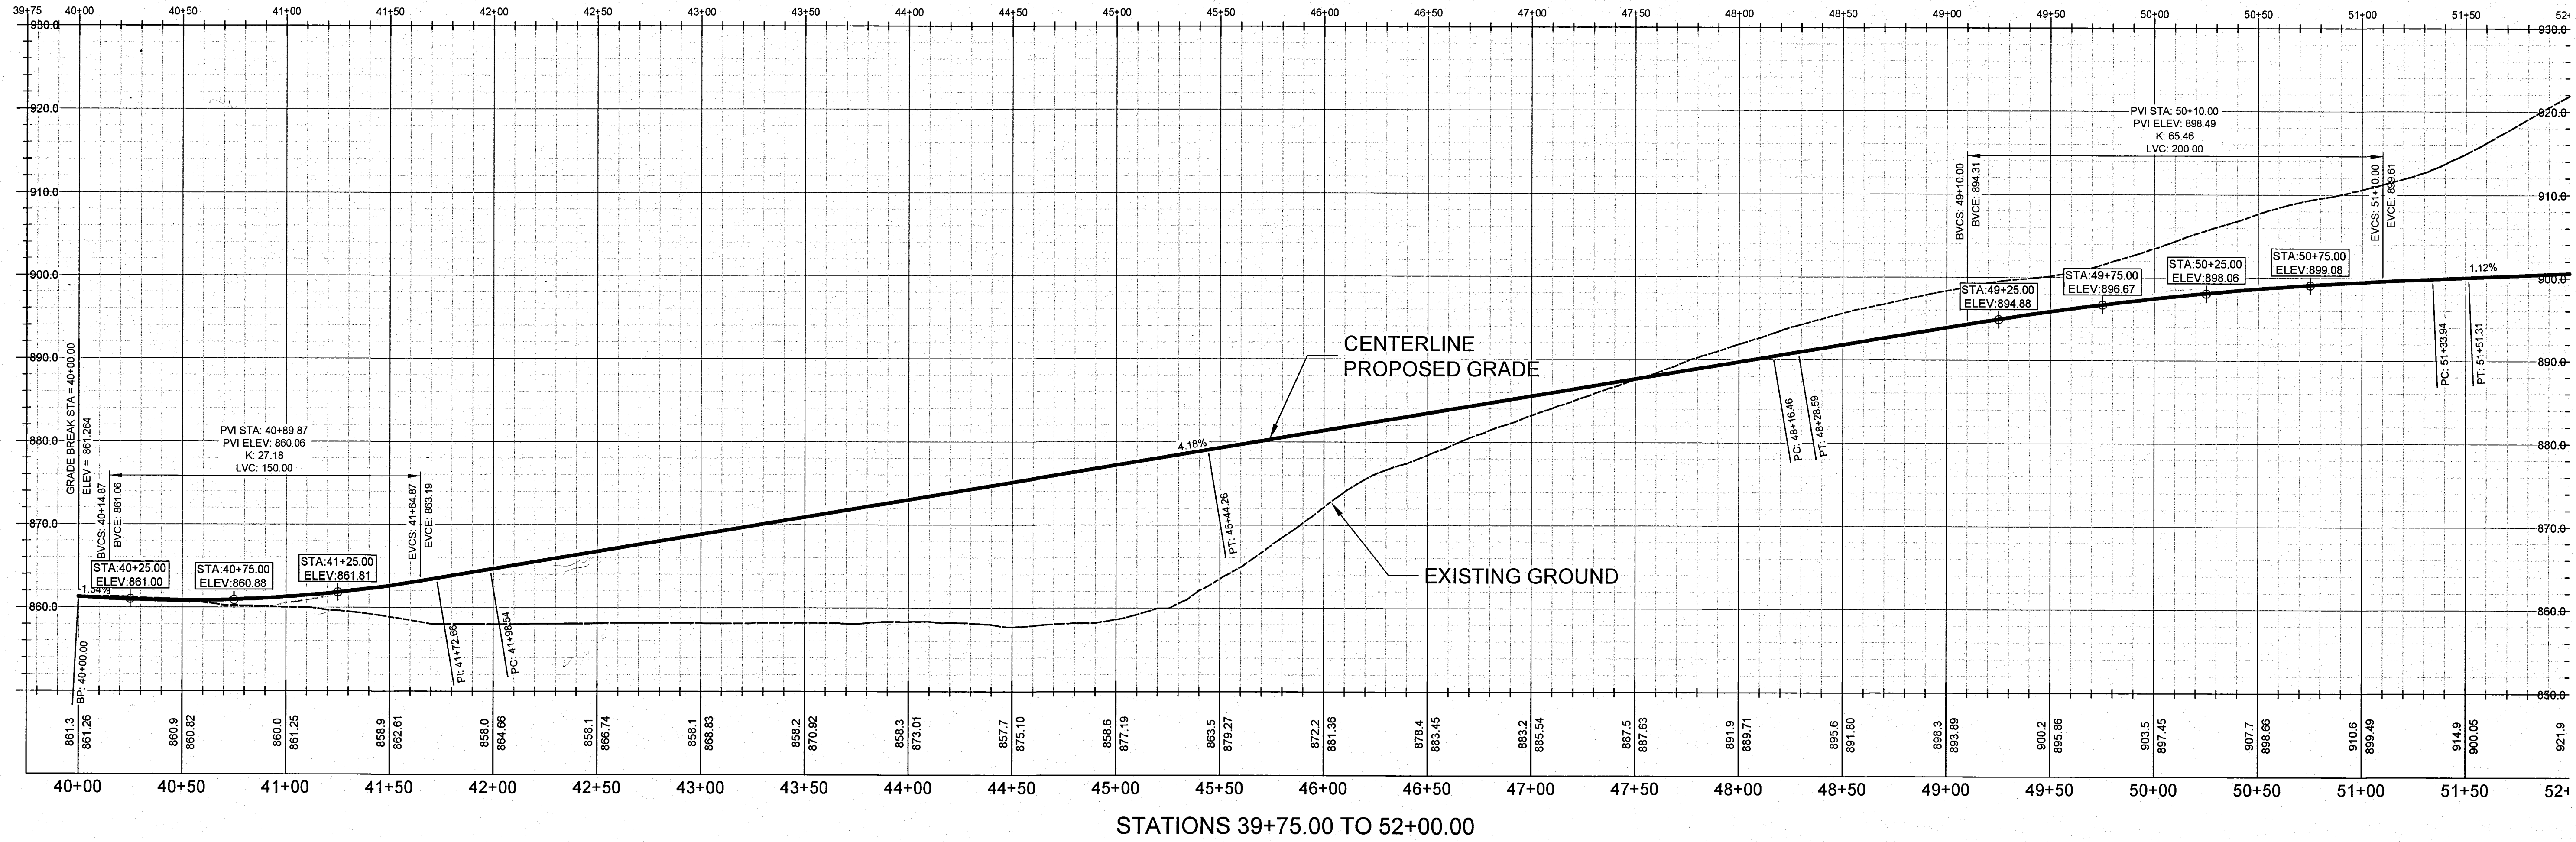

Adams Bros. Engineering
Civil Engineering
1501 Woodlawn Avenue
ZANESVILLE, OHIO 43701
VOICE (740) 452-7566 FAX (740) 452-7567

EASTPOINTE ROAD IMPROVEMENTS
BATEMAN ROAD & FUTURE DRIVE
PLAN & PROFILE
BATEMAN ROAD #1

Horiz: 1"=40'
Vert: 1"=10'
JOB #: C0714
SEP 10th, 2007
SHEET #:
C6

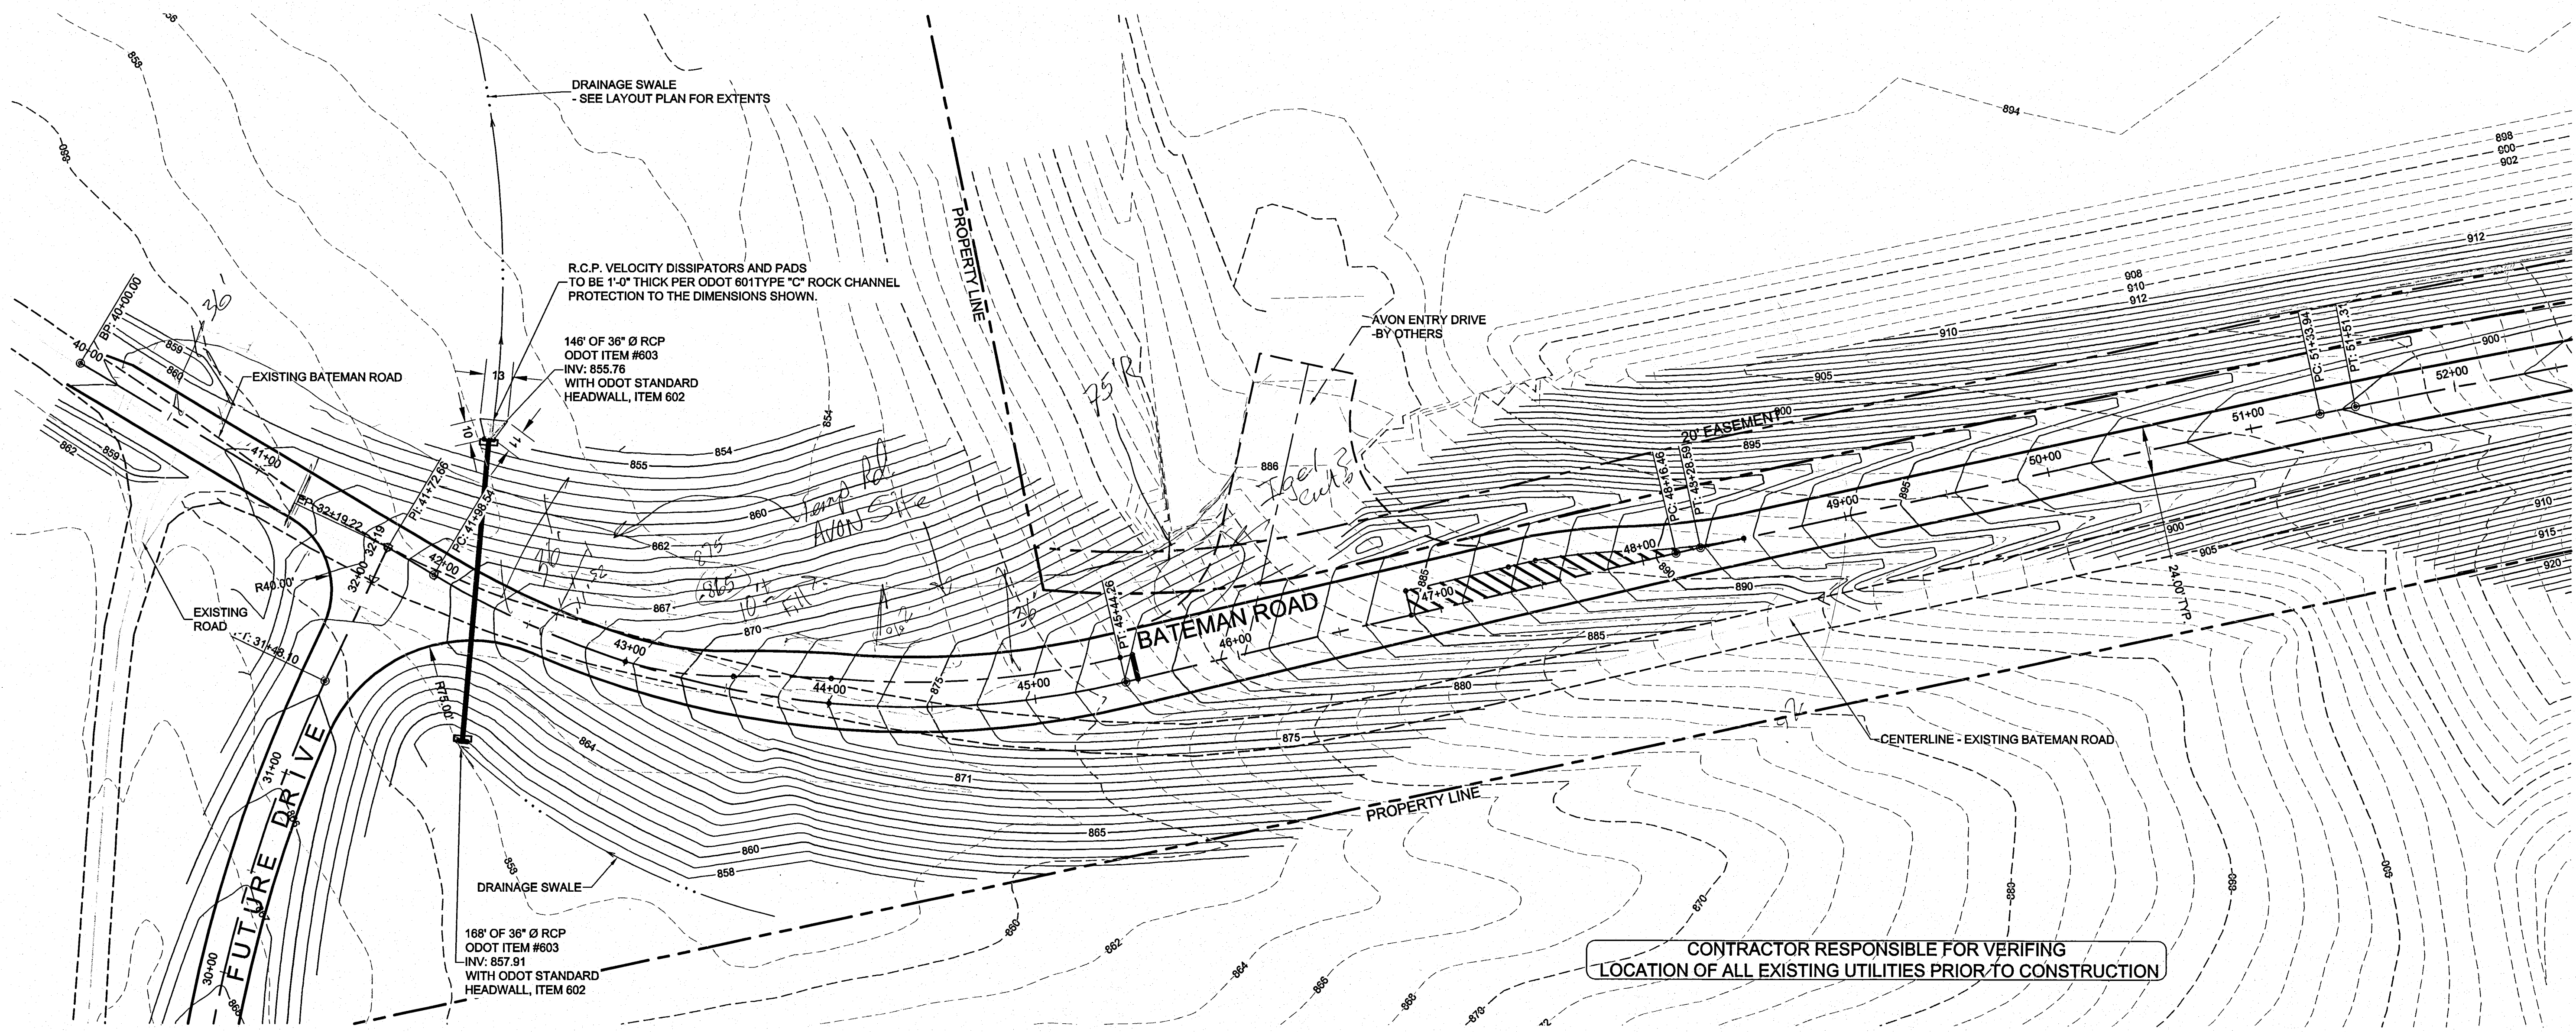

\\abelprojects\c0714_Bateman Extension\dwg\c0714-PRODUCTION-bateman.dwg, 9/11/2007 3:36:05 AM, HP Designjet 5500 24x36 fast.pc3, wph