

# CENTERLINE PLAT

## MUS-75-0.00 MUSKINGUM COUNTY

### ZANESVILLE-NEW LEXINGTON ROAD

| FED. RD. DIVISION | STATE | PROJECT |
|-------------------|-------|---------|
| 2                 | OHIO  |         |

PER-75-26.57  
MUS-75-0.00  
CONTROLLED ACCESS  
PER / MUS-93-


THIS IMPROVEMENT HAS BEEN DECLARED A CONTROLLED ACCESS HIGHWAY BY ACTION OF THE DIRECTOR OF HIGHWAYS AND RECORDED IN VOLUME 45, PAGE 345, OF THE DIRECTORS JOURNAL PURSUANT TO LAW.

RECEIVED August 15 1960  
RECORDED August 16 1960  
PLAT BOOK 10 PAGE 31  
Signed *[Signature]*  
MUSKINGUM COUNTY RECORDER

I HEREBY CERTIFY THAT THIS PLAT IS A TRUE DELINEATION OF A SURVEY MADE BY THE OHIO DEPARTMENT OF HIGHWAYS IN 1960.  
*[Signature]* DATE 7-25-60  
RESIDENT DIVISION DEPUTY DIRECTOR


TRANSFER NOT NECESSARY  
AUG 3 - 1960  
*[Signature]*  
Musk., Muskingum County

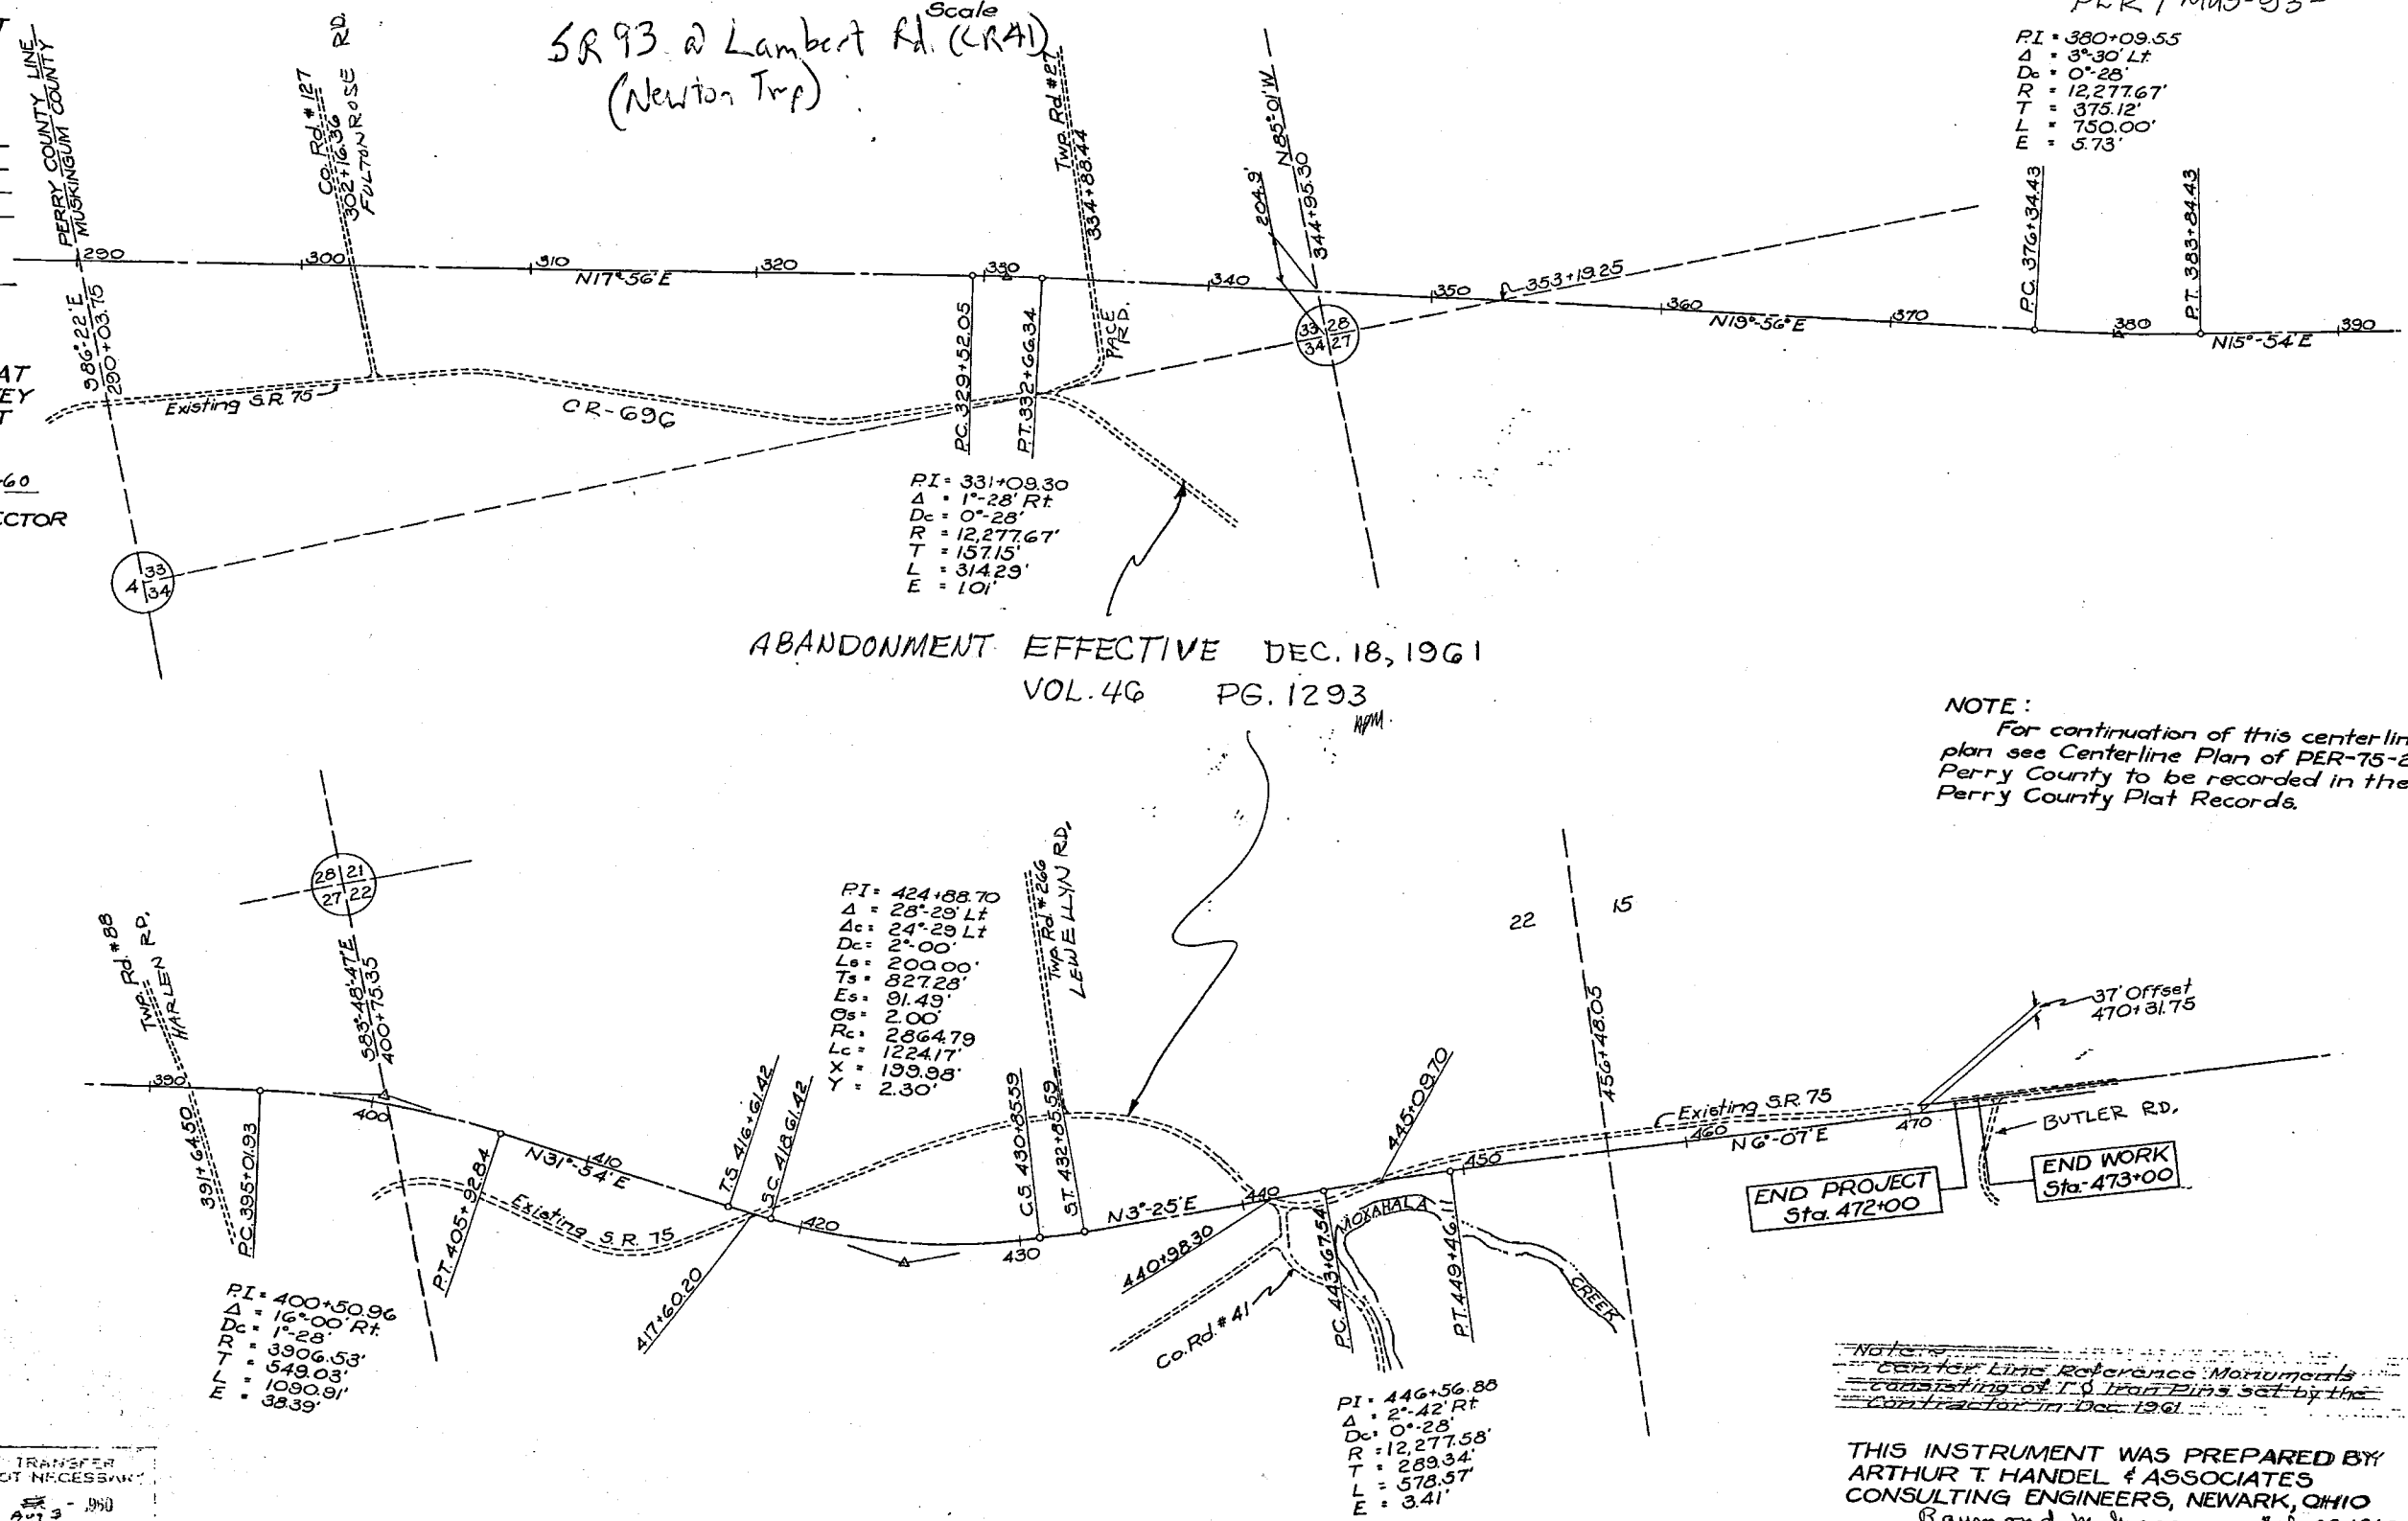

NOTICE: Center Line Reference Monuments consisting of 1" Iron Pins set by the Contractor in Dec. 1961.

THIS INSTRUMENT WAS PREPARED BY  
ARTHUR T. HANDEL & ASSOCIATES  
CONSULTING ENGINEERS, NEWARK, OHIO  
*[Signature]* July 29, 1960  
REG. SURV. N° 3949