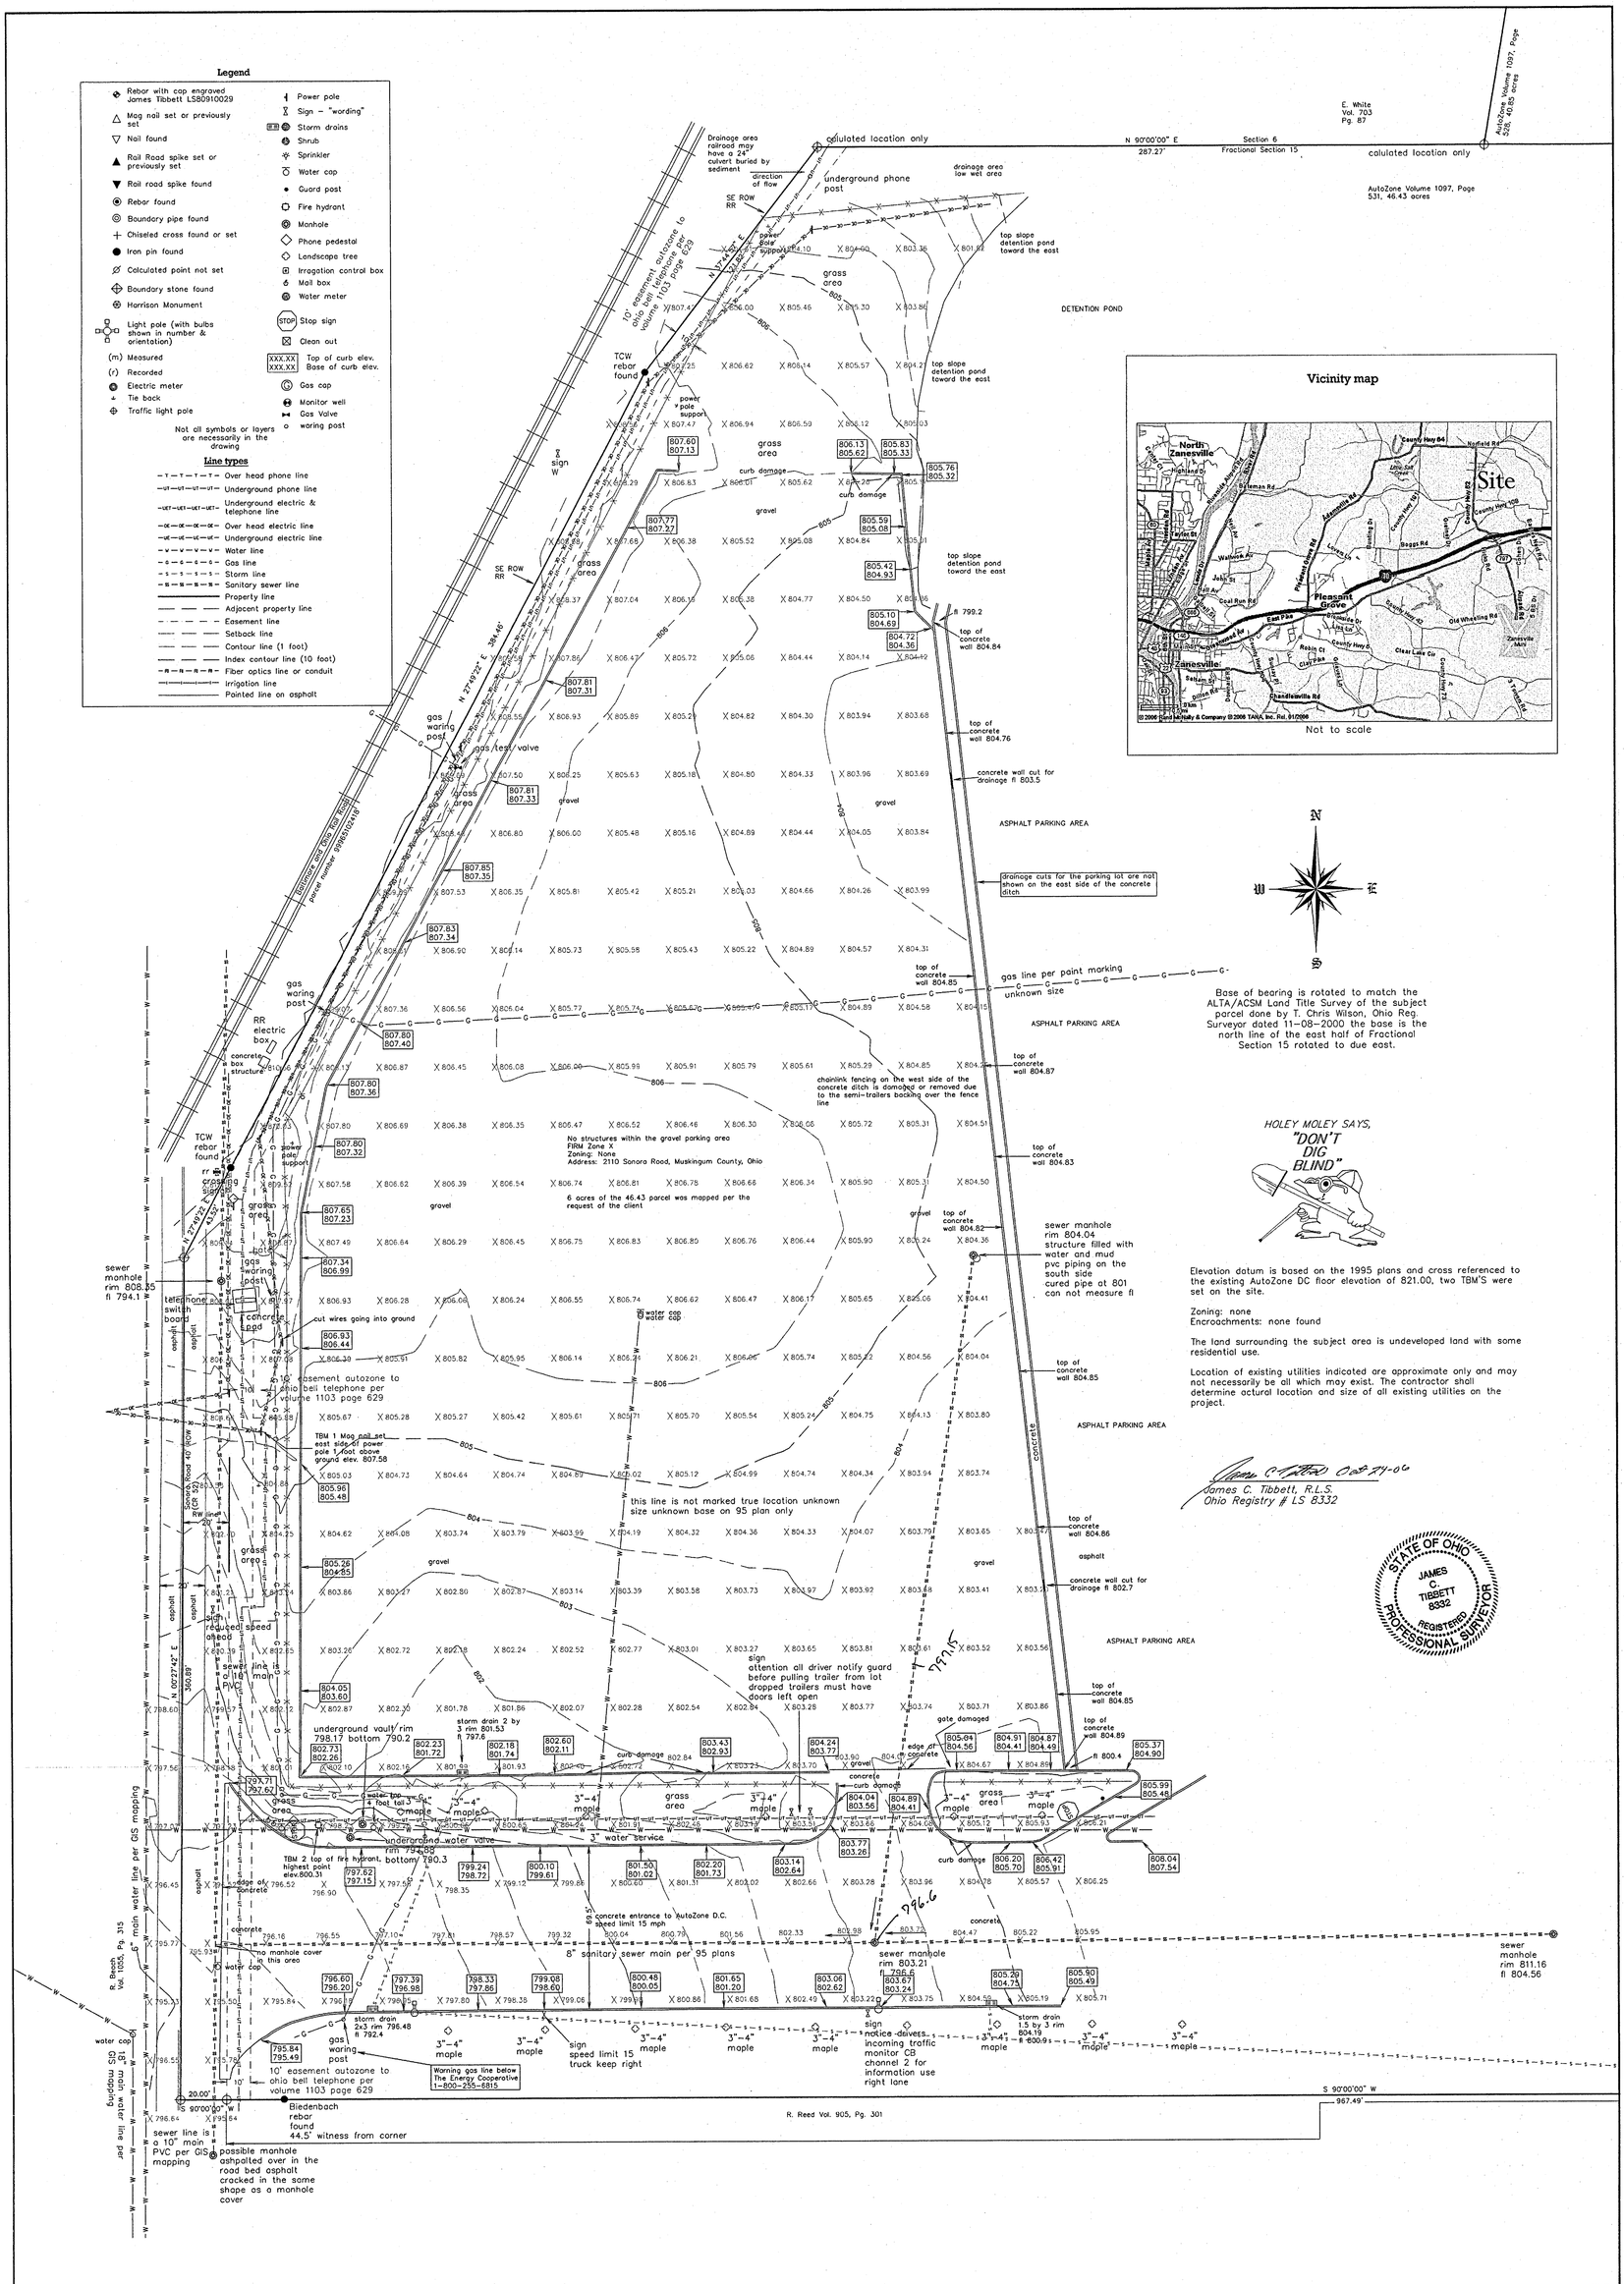

1 of 2 Sheets	Date Oct. 23, 2006	DWG File: CS1634	Scale 1" = 30' (0' 30' 60' 90')	CB&M Survey's, Inc. PO Box 487 429 NE A Street Linton, IN 47441 812-847-1952 www.cbmsurveys.com	AUTOZONE DISTRIBUTION CENTER 2110 Sonora Road Zanesville, Ohio
	Project No. CS 1634	Drawn By: James C. Tibbett			Truck Maintenance Facility Architectural survey Zanesville, Ohio Part of Fractional Section 15 and Section 6, T1N, R6W
		Checked & Approved BY: James C Tibbett			

Rev.No.	Date	Description
0	10/23/06	Drawing creation, field work done 10/18/2006