


Vicinity Map

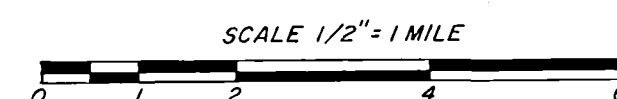

PRELIMINARY

Surveyor's Certificate

The undersigned Certifies that this Plat is Representative of a true and accurate Survey performed by The Ohio Department of Natural Resources under the supervision of undersigned in accordance with the "Minimum Standards for Boundary Surveys in the State of Ohio" O.R.C. 4733-37, and that all information shown is true and correct to the best of the knowledge and belief of the undersigned.


This plat is Certified to said Department, said Certificate does not extend to any unnamed persons without an expressed Recertification by the undersigned naming said persons.

Gilbert H. Smith Registered Surveyor No. 5888
January, 1986

LEGEND

- Stone found
- Iron pin found
- ⊙ Division of Forestry Conc. Mon. found
- ⊗ Railroad spike found

NOTE: All bearings are based upon a magnetic observation take at the site on August 23, 1983.

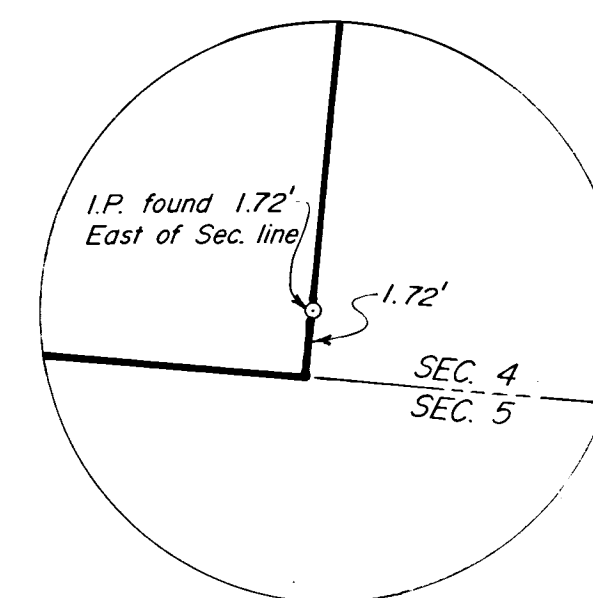

DETAIL
SCALE 1"=5'

STATE OF OHIO
DEPARTMENT OF NATURAL RESOURCES
OFFICE OF CHIEF ENGINEER

BOUNDARY LINE DISPUTE
DELMAR TYSINGER

| | |
|--------------|----------------|
| DESIGNED BY | JOB NUMBER |
| DRAWN BY DRA | SCALE As Shown |
| CHECKED BY | DATE |
| APPROVED BY | REVISED |

BLUE ROCK STATE FOREST
SECTION 4

