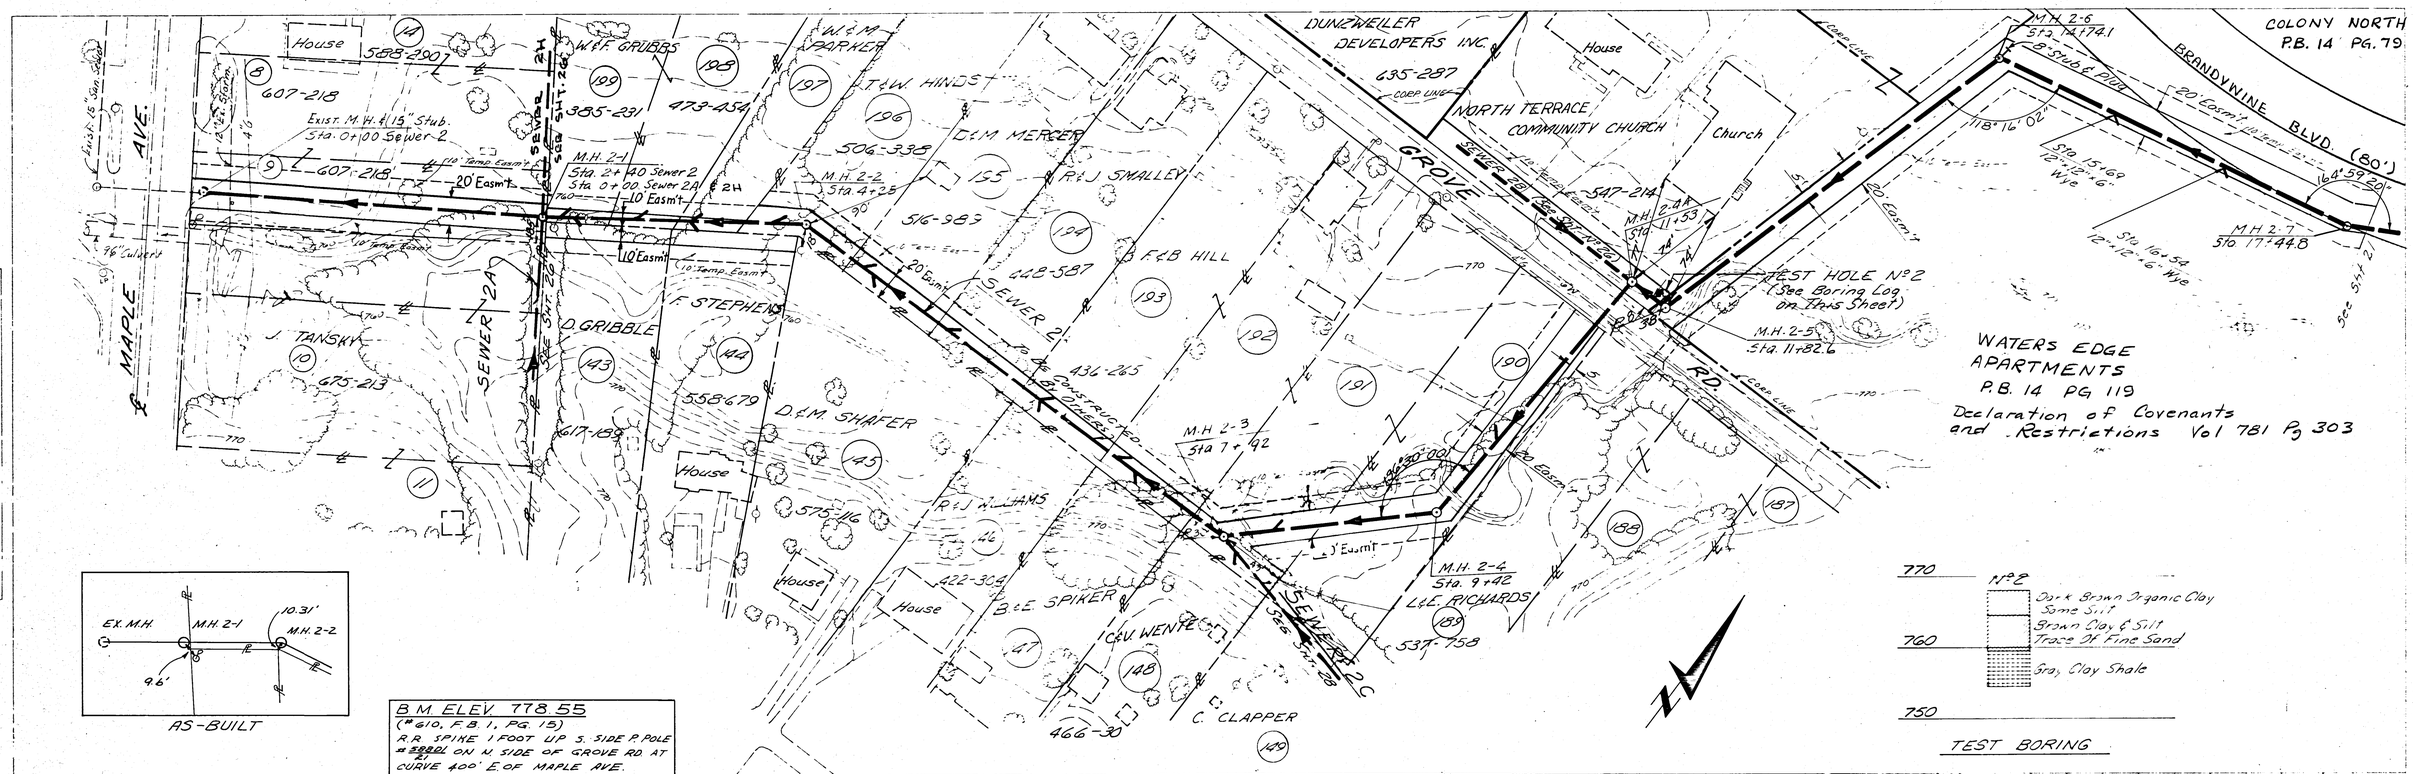
COLONY NORTH
P.B. 14 PG. 79
BRANDYWINE BLVD. (80')
DUNZWEILER DEVELOPERS INC.
NORTH TERRACE COMMUNITY CHURCH
GROVE RD.
MAPLE AVE.
SEWER 2A
SEWER 2
SEWER 2C
SEWER 2B
TO BE CONSTRUCTED BY OTHERS
TEST HOLE Nº2 (See Boring Log on This Sheet)
WATERS EDGE APARTMENTS
P.B. 14 PG 119
Declaration of Covenants and Restrictions Vol 781 Pg 303
M.H. 2-1 Sta. 2+40 Sewer 2 Sta. 0+00 Sewer 2A
M.H. 2-2 Sta. 4+25
M.H. 2-3 Sta. 7+92
M.H. 2-4 Sta. 9+42
M.H. 2-5 Sta. 11+82.6
M.H. 2-6 Sta. 14+74.1
M.H. 2-7 Sta. 17+44.8
Exist. M.H. & 15" Stub. Sta. 0+00 Sewer 2
Exist. 16" San. Sewer
Exist. 36" Culvert
20' Easm't
10' Easm't
10' Temp. Easm't
8" Stub & Plug
20' Corp. Easm't
118° 16' 02"
164° 59' 20"
Sta. 15+69 12"-12"-6" Wye
Sta. 16+54 12"-12"-6" Wye
See Sht. 21
House
Church
Corp. Line
AS-BUILT
EX. M.H.
M.H. 2-1
M.H. 2-2
10.31'
9.6'
B.M. ELEV. 778.55
(#610, F.B. 1, PG. 15)
R.R. SPIKE 1 FOOT UP S. SIDE P. POLE #2 ON N. SIDE OF GROVE RD. AT CURVE 400' E. OF MAPLE AVE.
B.M. ELEV. 770.86
(#609, F.B. 1, PG 15)
R.R. SPIKE 1 FOOT UP N. SIDE OF P. POLE # 40 FEET ± WEST OF STREAM CROSSING ON SOUTH SIDE OF GROVE ROAD.
NOTE: THIS SHEET IS NOT PART OF CONTRACT I, FOR INFORMATION ONLY. (TO BE CONSTRUCTED BY OTHERS PRIOR TO THIS CONTRACT.)
Nº2
Dark Brown Organic Clay Some Silt
Brown Clay & Silt Trace Of Fine Sand
Gray Clay Shale
TEST BORING
PLAN
PROFILE
NOTE BOOK
No.
SURVEYED
PLOTTED
CROSS CHECKED
H.M. NOTED
STRUCTURE NOTE CHECKED
BY
DATE
Exist. M.H. Sta. 0+00 Sewer 2
℄ Maple Avenue
M.H. 2-1 Sta. 2+40 Sewer 2 = Sta. 0+00 Sewer 2A
M.H. 2-2 Sta. 4+25
M.H. 2-3 Sta. 7+92 Sewer 2 = Sta. 0+00 Sewer 2C
M.H. 2-4 Sta. 9+42
M.H. 2-5 Sta. 11+82.6
M.H. 2-6 Sta. 14+74.1
M.H. 2-7 Sta. 17+44.8
Exist. 15" @ 0.50%
Exist. 60' Casing
240' OF 15" @ 0.75%
185' OF 15" @ 0.75%
367' OF 15" @ 0.75
150' OF 12" @ 0.8%
211' OF 12" @ 0.8%
291.58' OF 12" @ 0.75%
29.56' OF 12" @ 1.79%
270.67' OF 12" @ 0.32%
15" Stub Inv. 751.75 & CONTRACTOR, EXPOSE AND CONFIRM
Sewer 2A (8") Inv. 753.88 (S)
Sewer 2H (8") Inv. 753.88 (N)
Sewer 2C (8") Inv. 759.70
20' Concrete Encasement
Sewer 2B Inv. 761.36
8" Stub & Plug Inv. 763.75
0+00
1+00
2+00
3+00
4+00
5+00
6+00
7+00
8+00
9+00
10+00
11+00
12+00
13+00
14+00
770
760
750
780
REVISED 4/9/76 S.K.B
CONTRACT ID
LINE 2
CK'D 9/02/75 HGM
22
51