


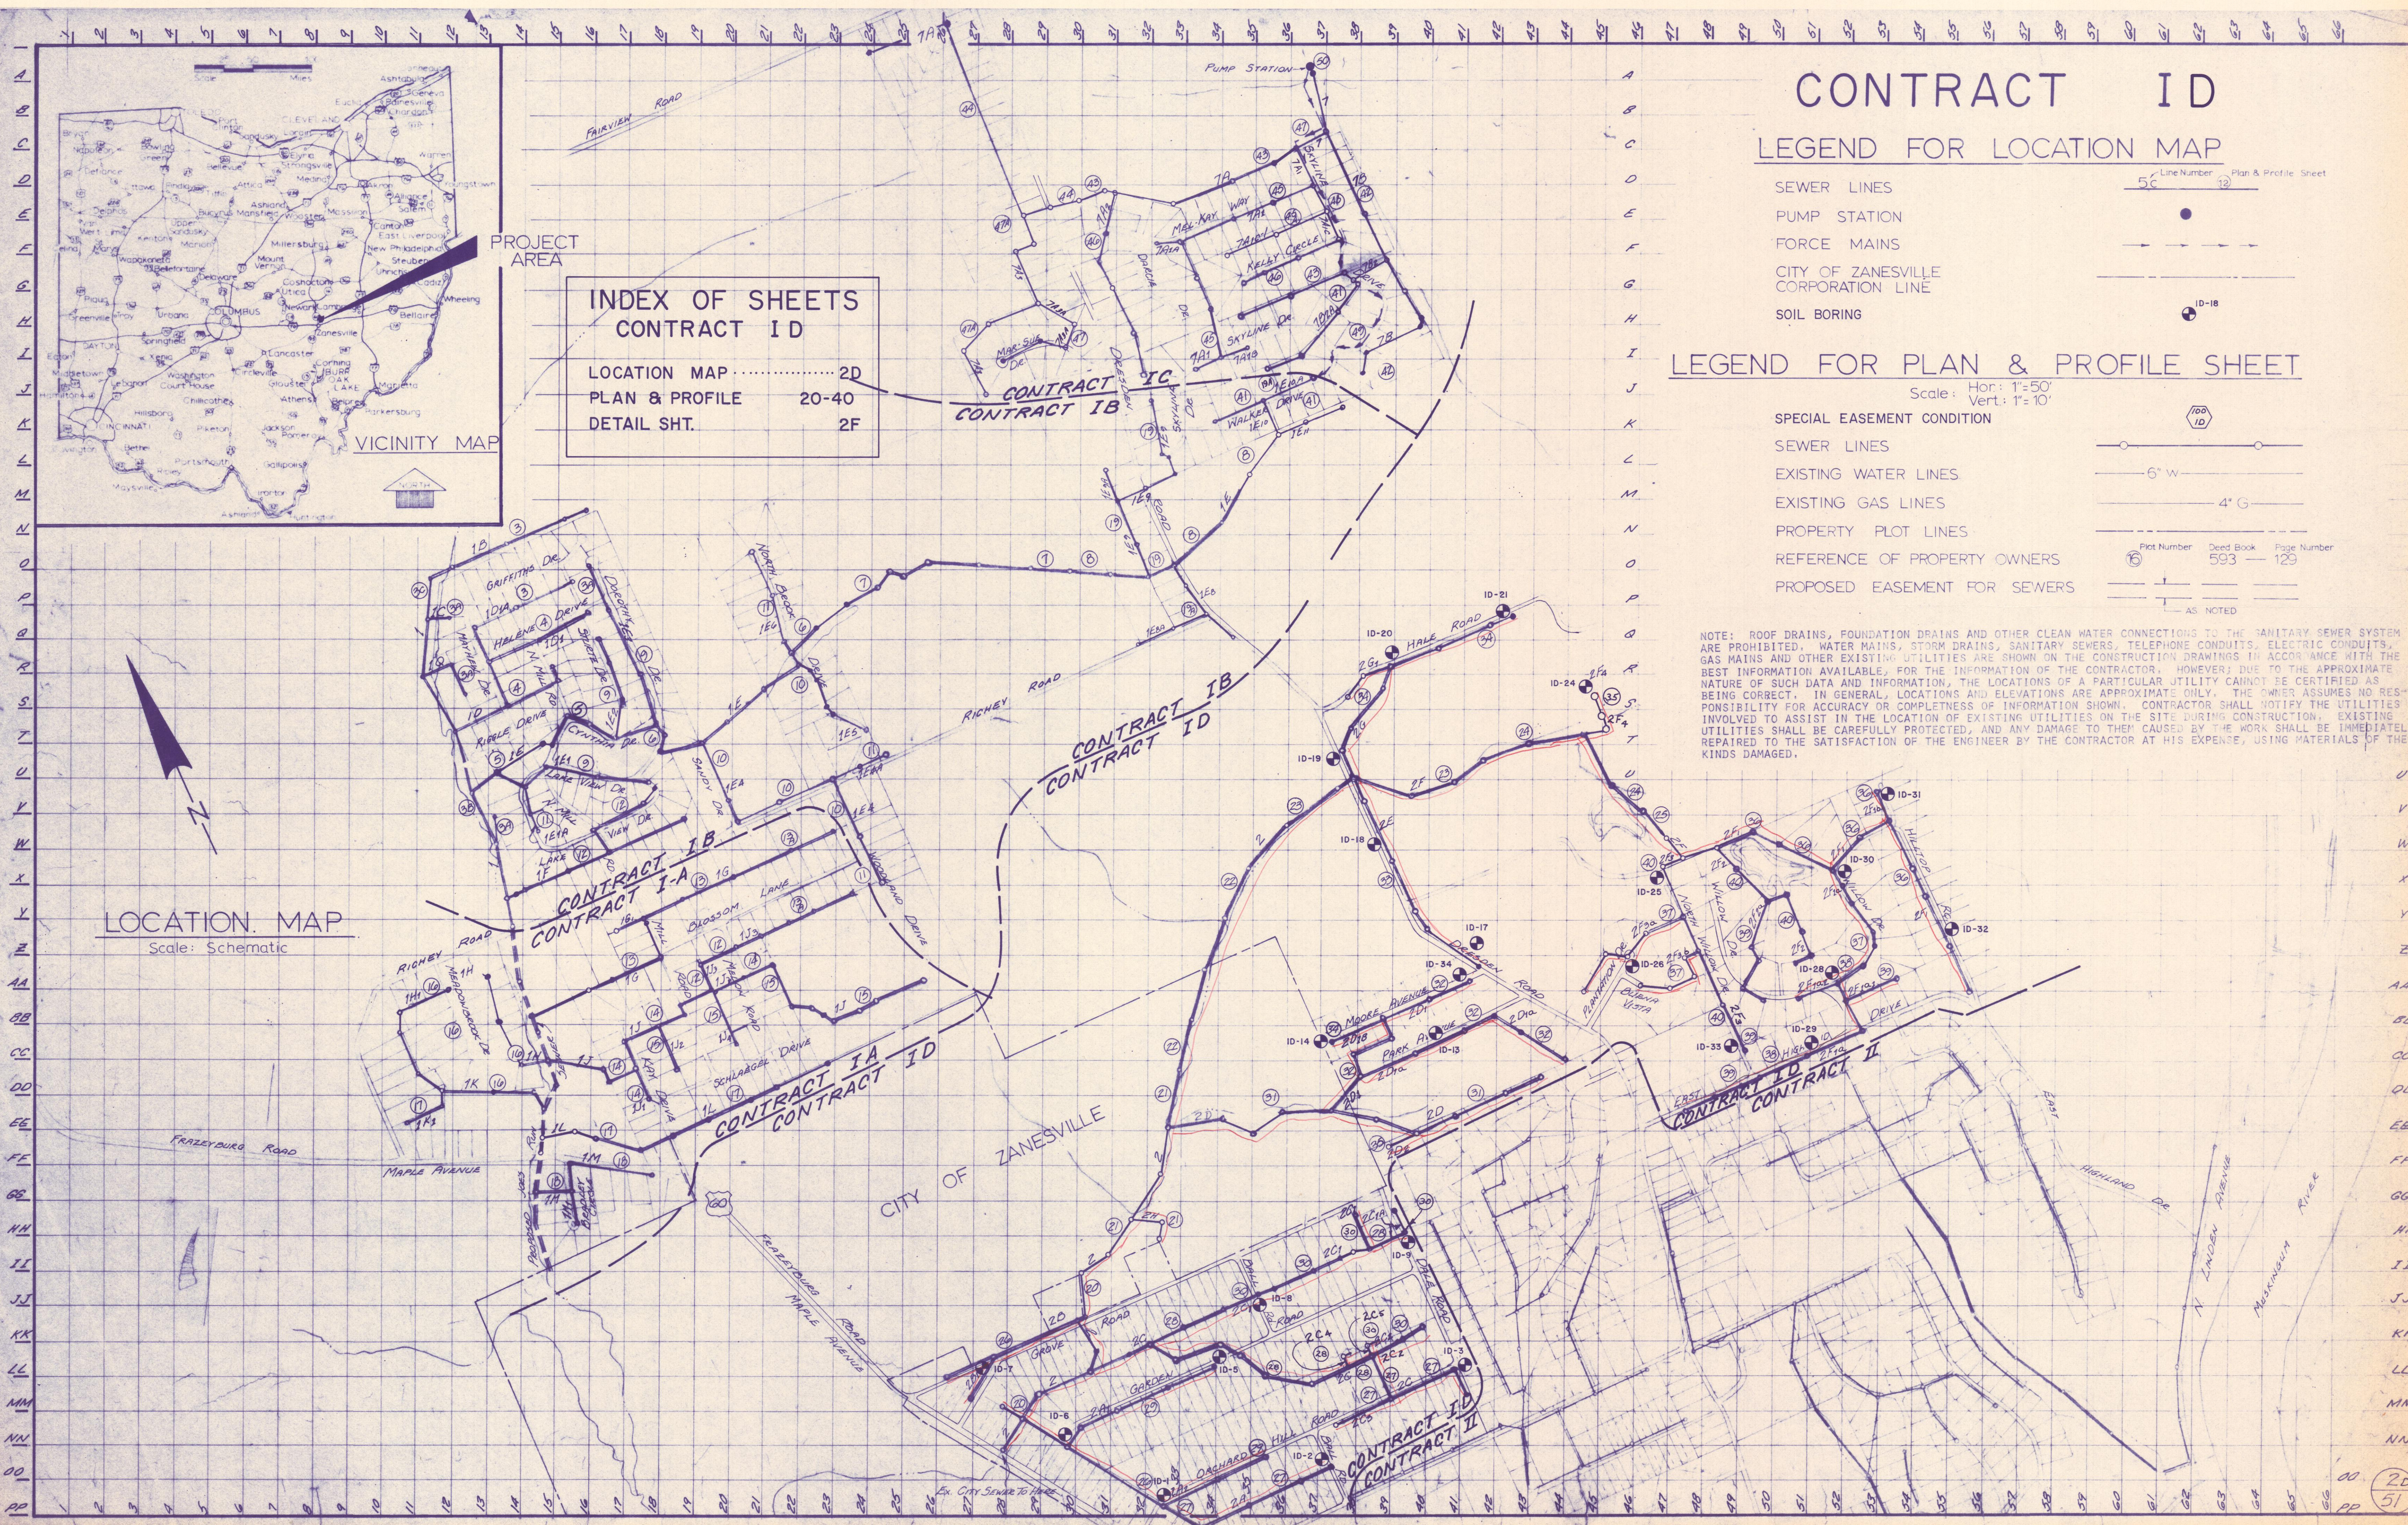

CONTRACT 1D

LEGEND FOR LOCATION MAP

- SEWER LINES
- PUMP STATION
- FORCE MAINS
- CITY OF ZANESVILLE CORPORATION LINE
- SOIL BORING

LEGEND FOR PLAN & PROFILE SHEET

- SPECIAL EASEMENT CONDITION
- SEWER LINES
- EXISTING WATER LINES
- EXISTING GAS LINES
- PROPERTY PLOT LINES
- REFERENCE OF PROPERTY OWNERS
- PROPOSED EASEMENT FOR SEWERS

NOTE: ROOF DRAINS, FOUNDATION DRAINS AND OTHER CLEAN WATER CONNECTIONS TO THE SANITARY SEWER SYSTEM ARE PROHIBITED. WATER MAINS, STORM DRAINS, SANITARY SEWERS, TELEPHONE CONDUITS, ELECTRIC CONDUITS, GAS MAINS AND OTHER EXISTING UTILITIES ARE SHOWN ON THE CONSTRUCTION DRAWINGS IN ACCORDANCE WITH THE BEST INFORMATION AVAILABLE, FOR THE INFORMATION OF THE CONTRACTOR. HOWEVER, DUE TO THE APPROXIMATE NATURE OF SUCH DATA AND INFORMATION, THE LOCATIONS OF A PARTICULAR UTILITY CANNOT BE CERTIFIED AS BEING CORRECT. IN GENERAL, LOCATIONS AND ELEVATIONS ARE APPROXIMATE ONLY. THE OWNER ASSUMES NO RESPONSIBILITY FOR ACCURACY OR COMPLETENESS OF INFORMATION SHOWN. CONTRACTOR SHALL NOTIFY THE UTILITIES INVOLVED TO ASSIST IN THE LOCATION OF EXISTING UTILITIES ON THE SITE DURING CONSTRUCTION. EXISTING UTILITIES SHALL BE CAREFULLY PROTECTED, AND ANY DAMAGE TO THEM CAUSED BY THE WORK SHALL BE IMMEDIATELY REPAIRED TO THE SATISFACTION OF THE ENGINEER BY THE CONTRACTOR AT HIS EXPENSE, USING MATERIALS OF THE KINDS DAMAGED.

INDEX OF SHEETS CONTRACT 1D

LOCATION MAP	2D
PLAN & PROFILE	20-40
DETAIL SHT.	2F

LOCATION MAP Scale: Schematic

