
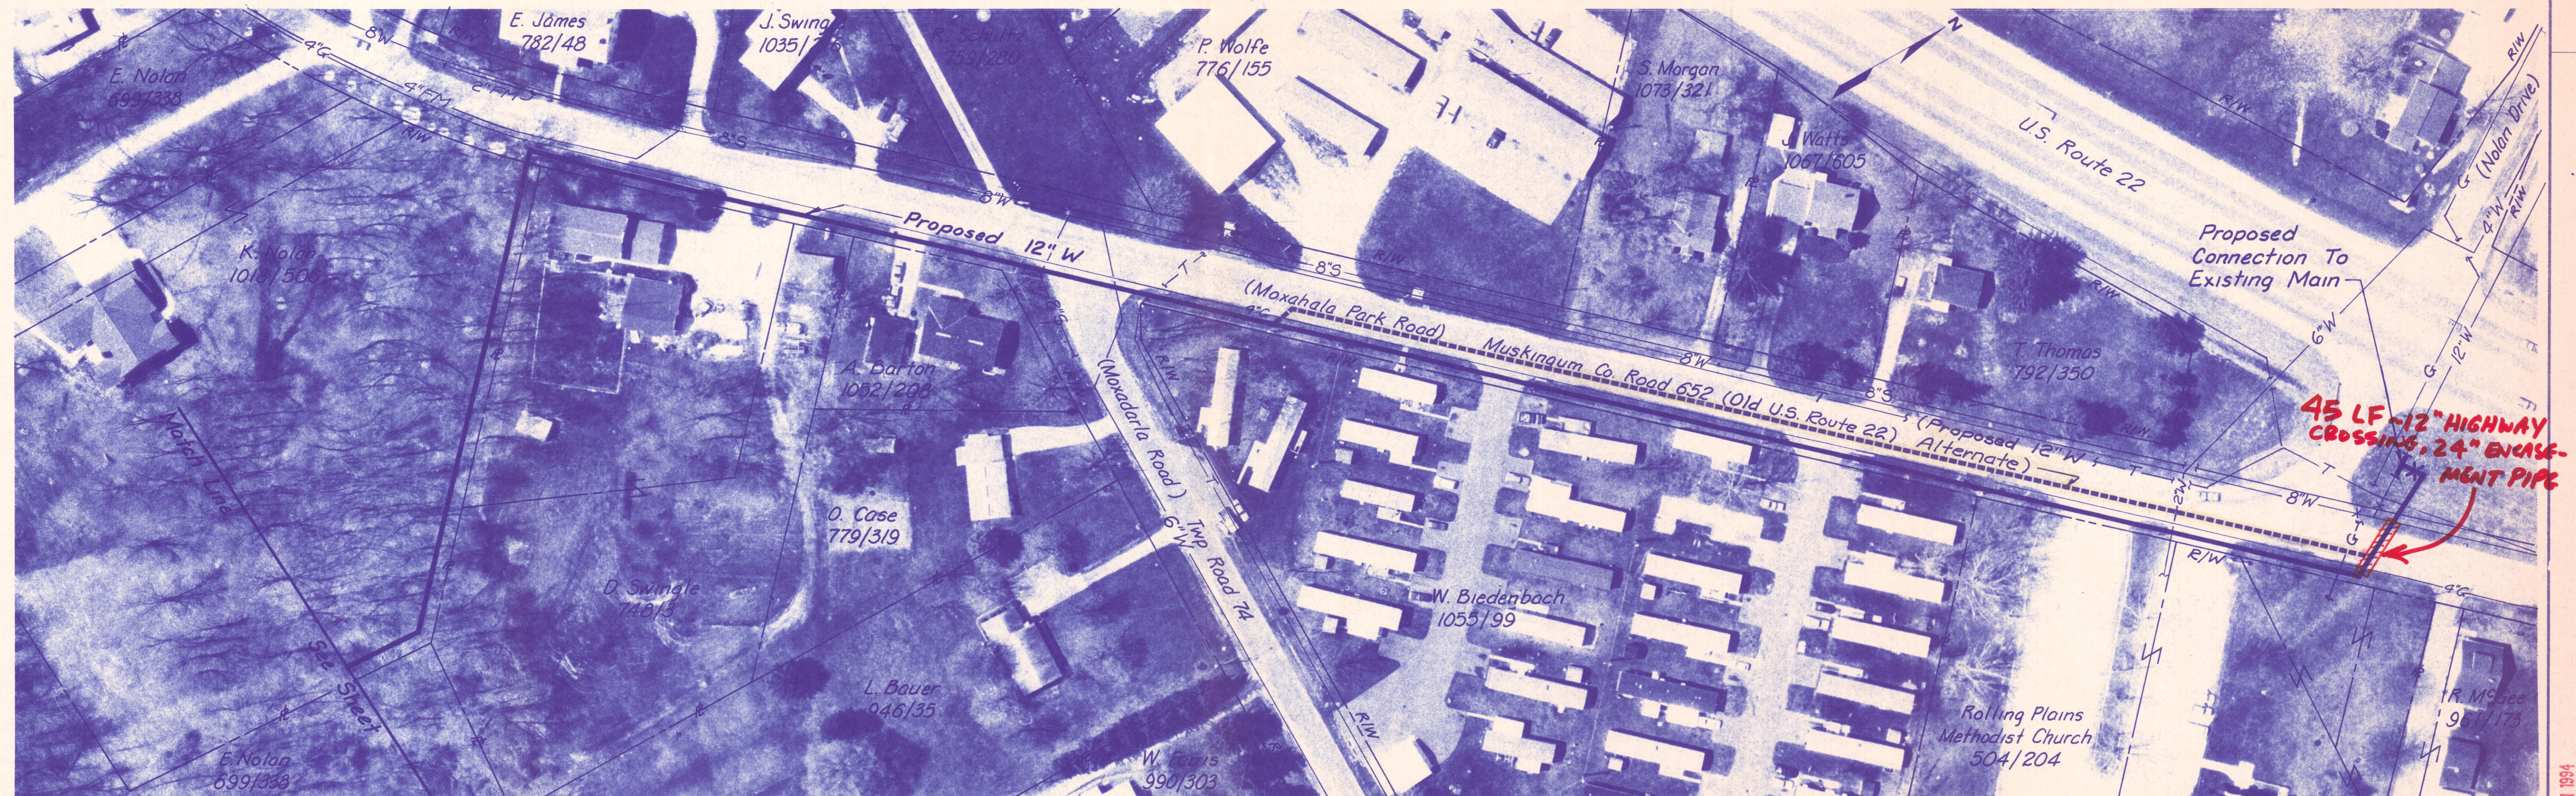


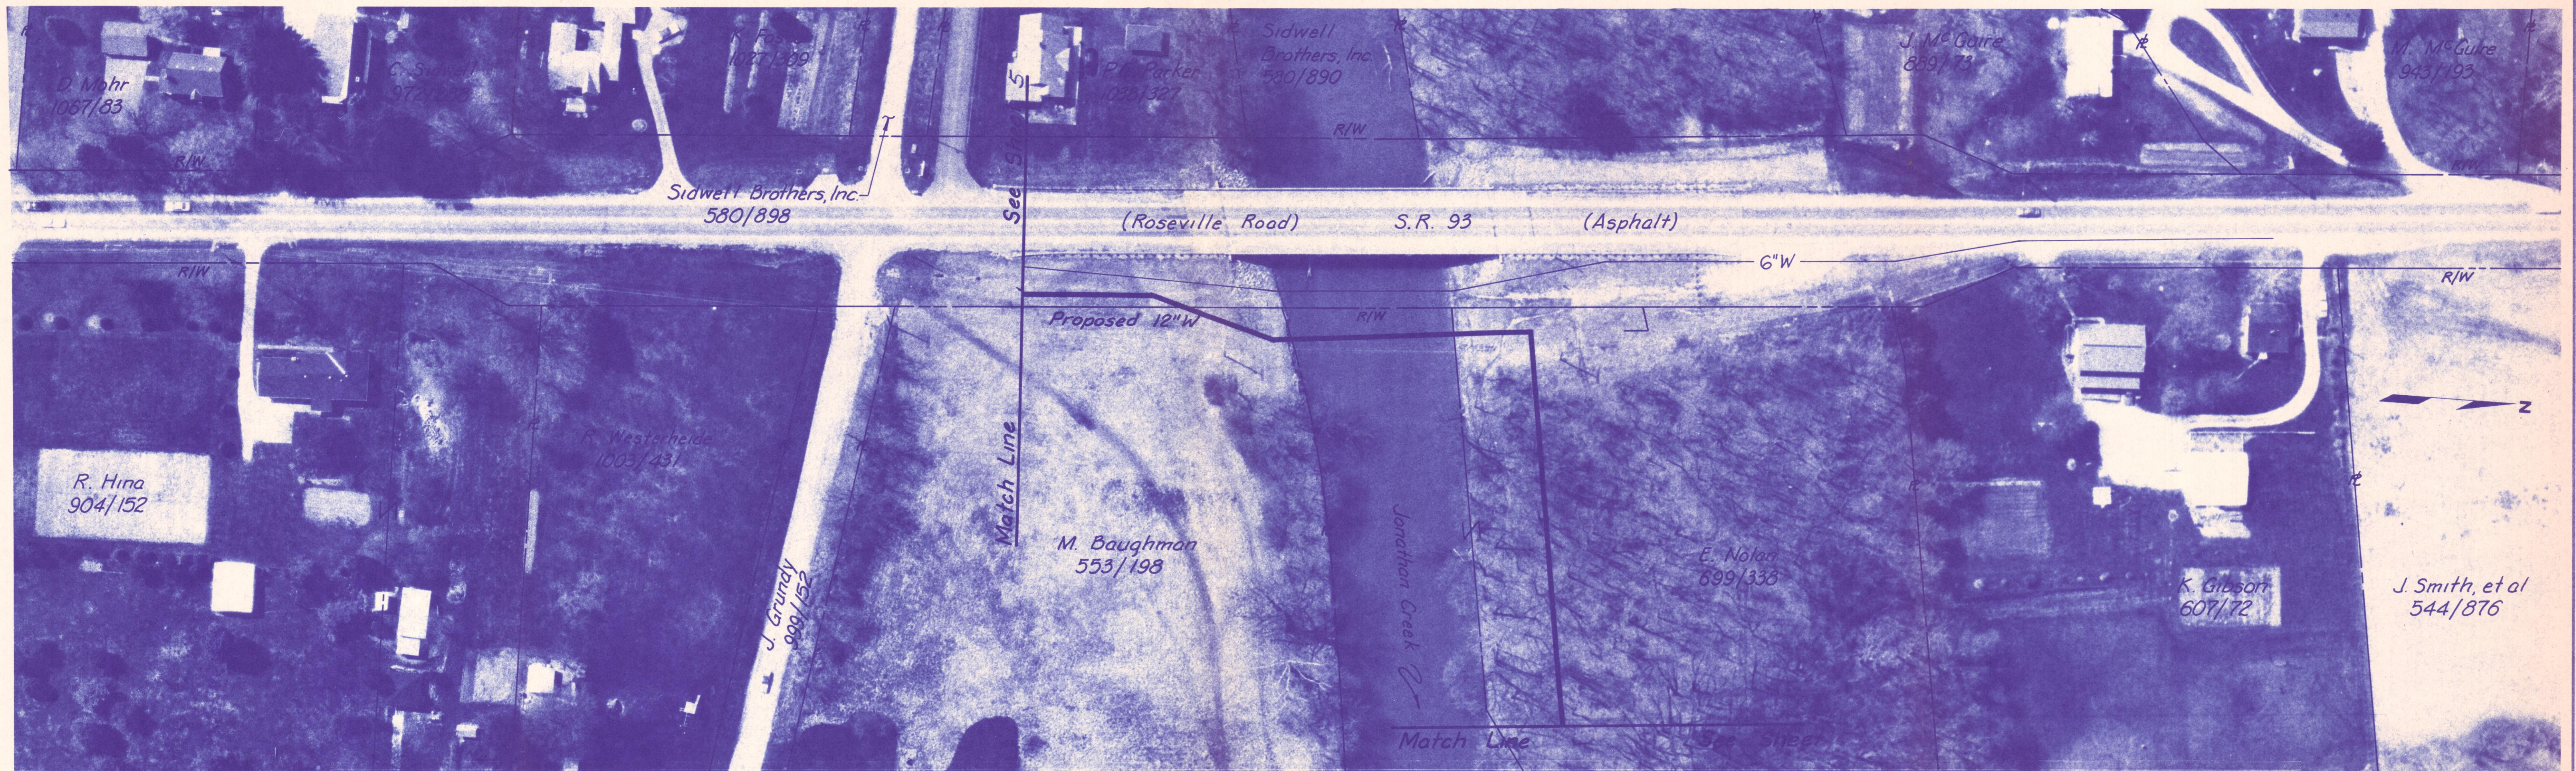

| NO. | REVISIONS | DATE | BY | CHK. |
|-----|-----------|------|----|------|
|     |           |      |    |      |
|     |           |      |    |      |
|     |           |      |    |      |

Burgess & Niple, Limited PARKERSBURG, WV

**BURGESS  
& NIPLE**  
ENGINEERS  
ARCHITECTS

MAYSVILLE REGIONAL WATER DISTRICT  
**WATER SYSTEM IMPROVEMENTS**  
CONTRACT 94-2

|          |           |
|----------|-----------|
| DESIGNED | 15669     |
| DRAWN    | CMS       |
| CHECKED  | CMS/LP    |
| APPROVED | LES       |
| DATE     | LES       |
|          | OCT, 1994 |

**PRELIMINARY**  
NOT FOR CONSTRUCTION

|           |        |
|-----------|--------|
| SCALE:    | 1"=50' |
| SHEET NO. | 8      |
| OF        | 9      |