



TYPICAL SECTIONS TYPE 404 ON 301

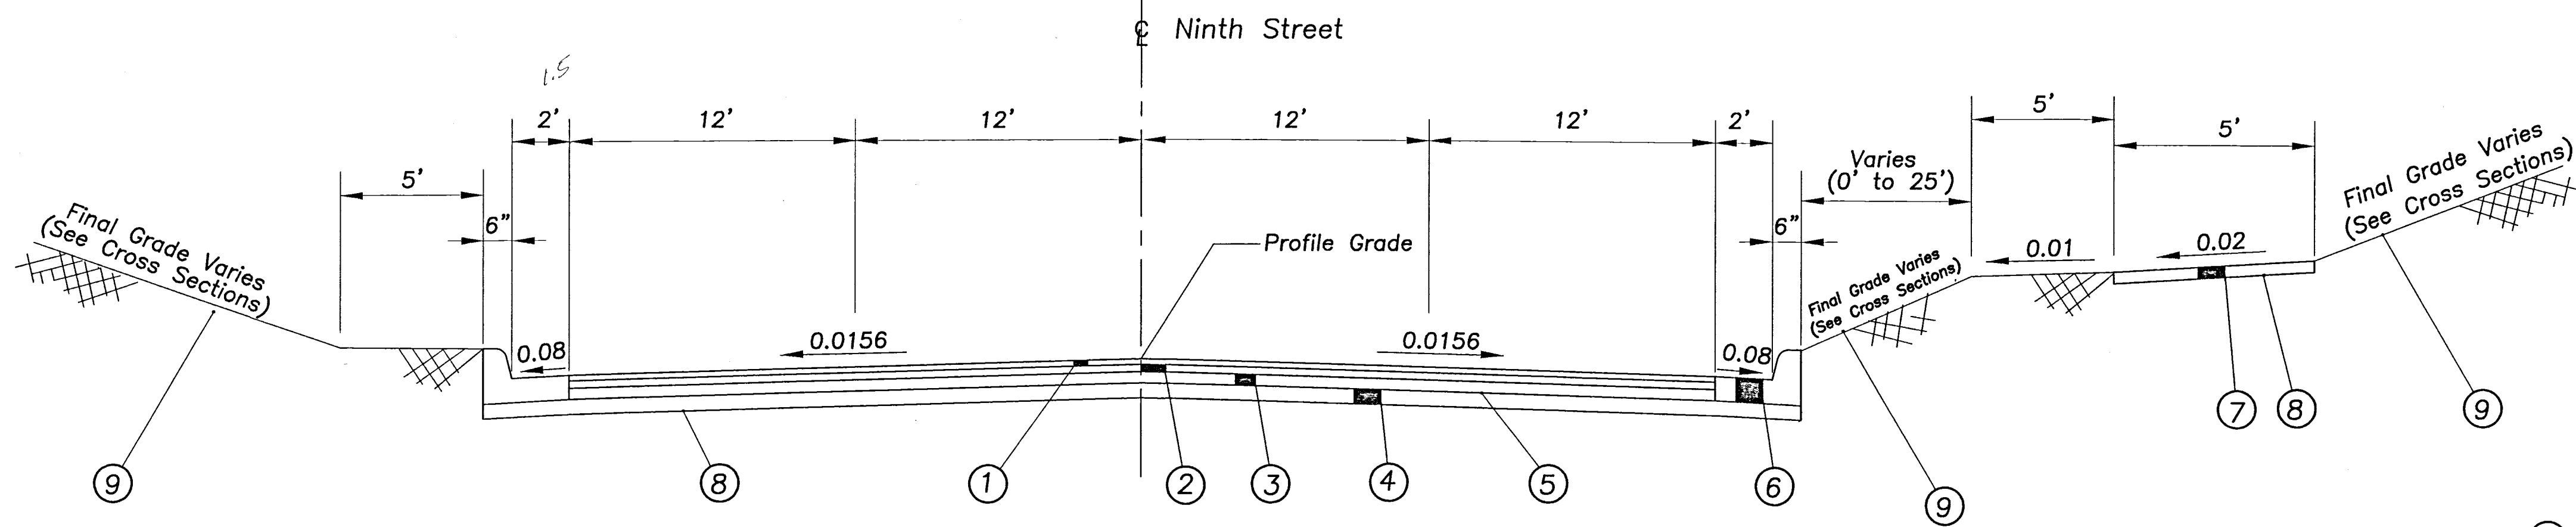

LIMITING STATIONS
STA. 0+16.45 to 9+45.87 = 929.42 LF.

LEGEND

- ① Item 404 1-1/4" Asphalt Concrete, AC-20
- ② Item 402 1-3/4" Asphalt Concrete, AC-20
- ③ Item 301 5" Bituminous Aggregate Base, AC-20
- ④ Item 304 6" Aggregate Base
- ⑤ Item 408 Bituminous Prime Coat, @0.4 Gal./S.Y.
- ⑥ Item 609 Concrete Curb, Type 2 (Thickness = 8")
- ⑦ Item 608 Concrete Walk (Thickness = 4")
- ⑧ Item 203 Subgrade Compaction
- ⑨ Item 659 Seeding and Mulching

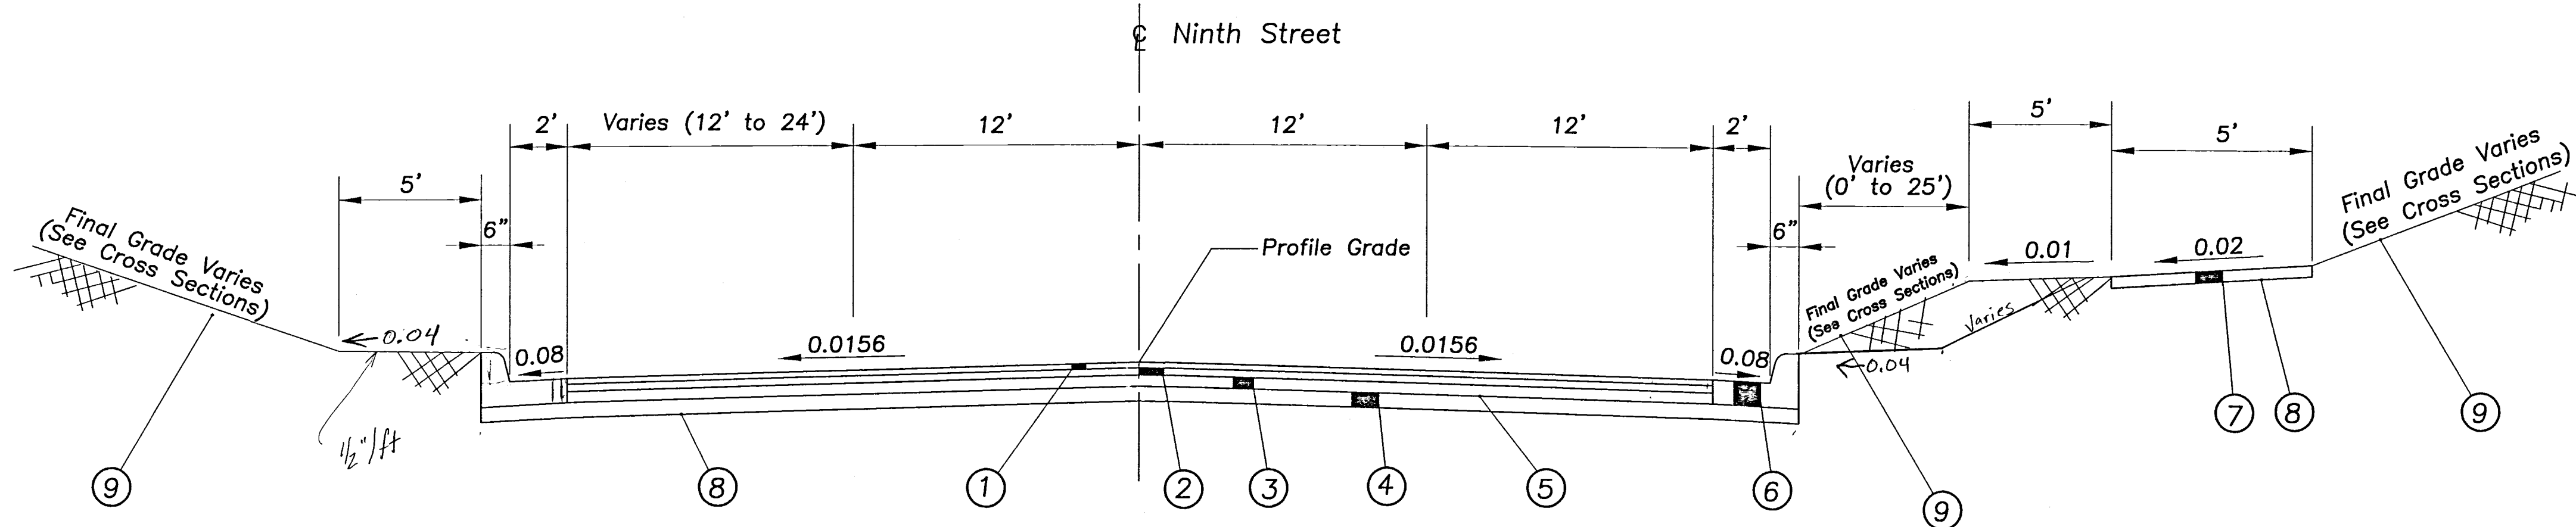

LIMITING STATIONS
STA. 9+45.87 to 13+15.86 = 369.99 LF.

CALCULATED	CHECKED
FEDERAL PROJ. NO.	
PID NO.	
COUNTY PROJ. NO.	
TYPICAL SECTIONS (NINTH STREET)	
STA. 0+16.45 TO 13+15.86	
NINTH STREET	
6	
29	