


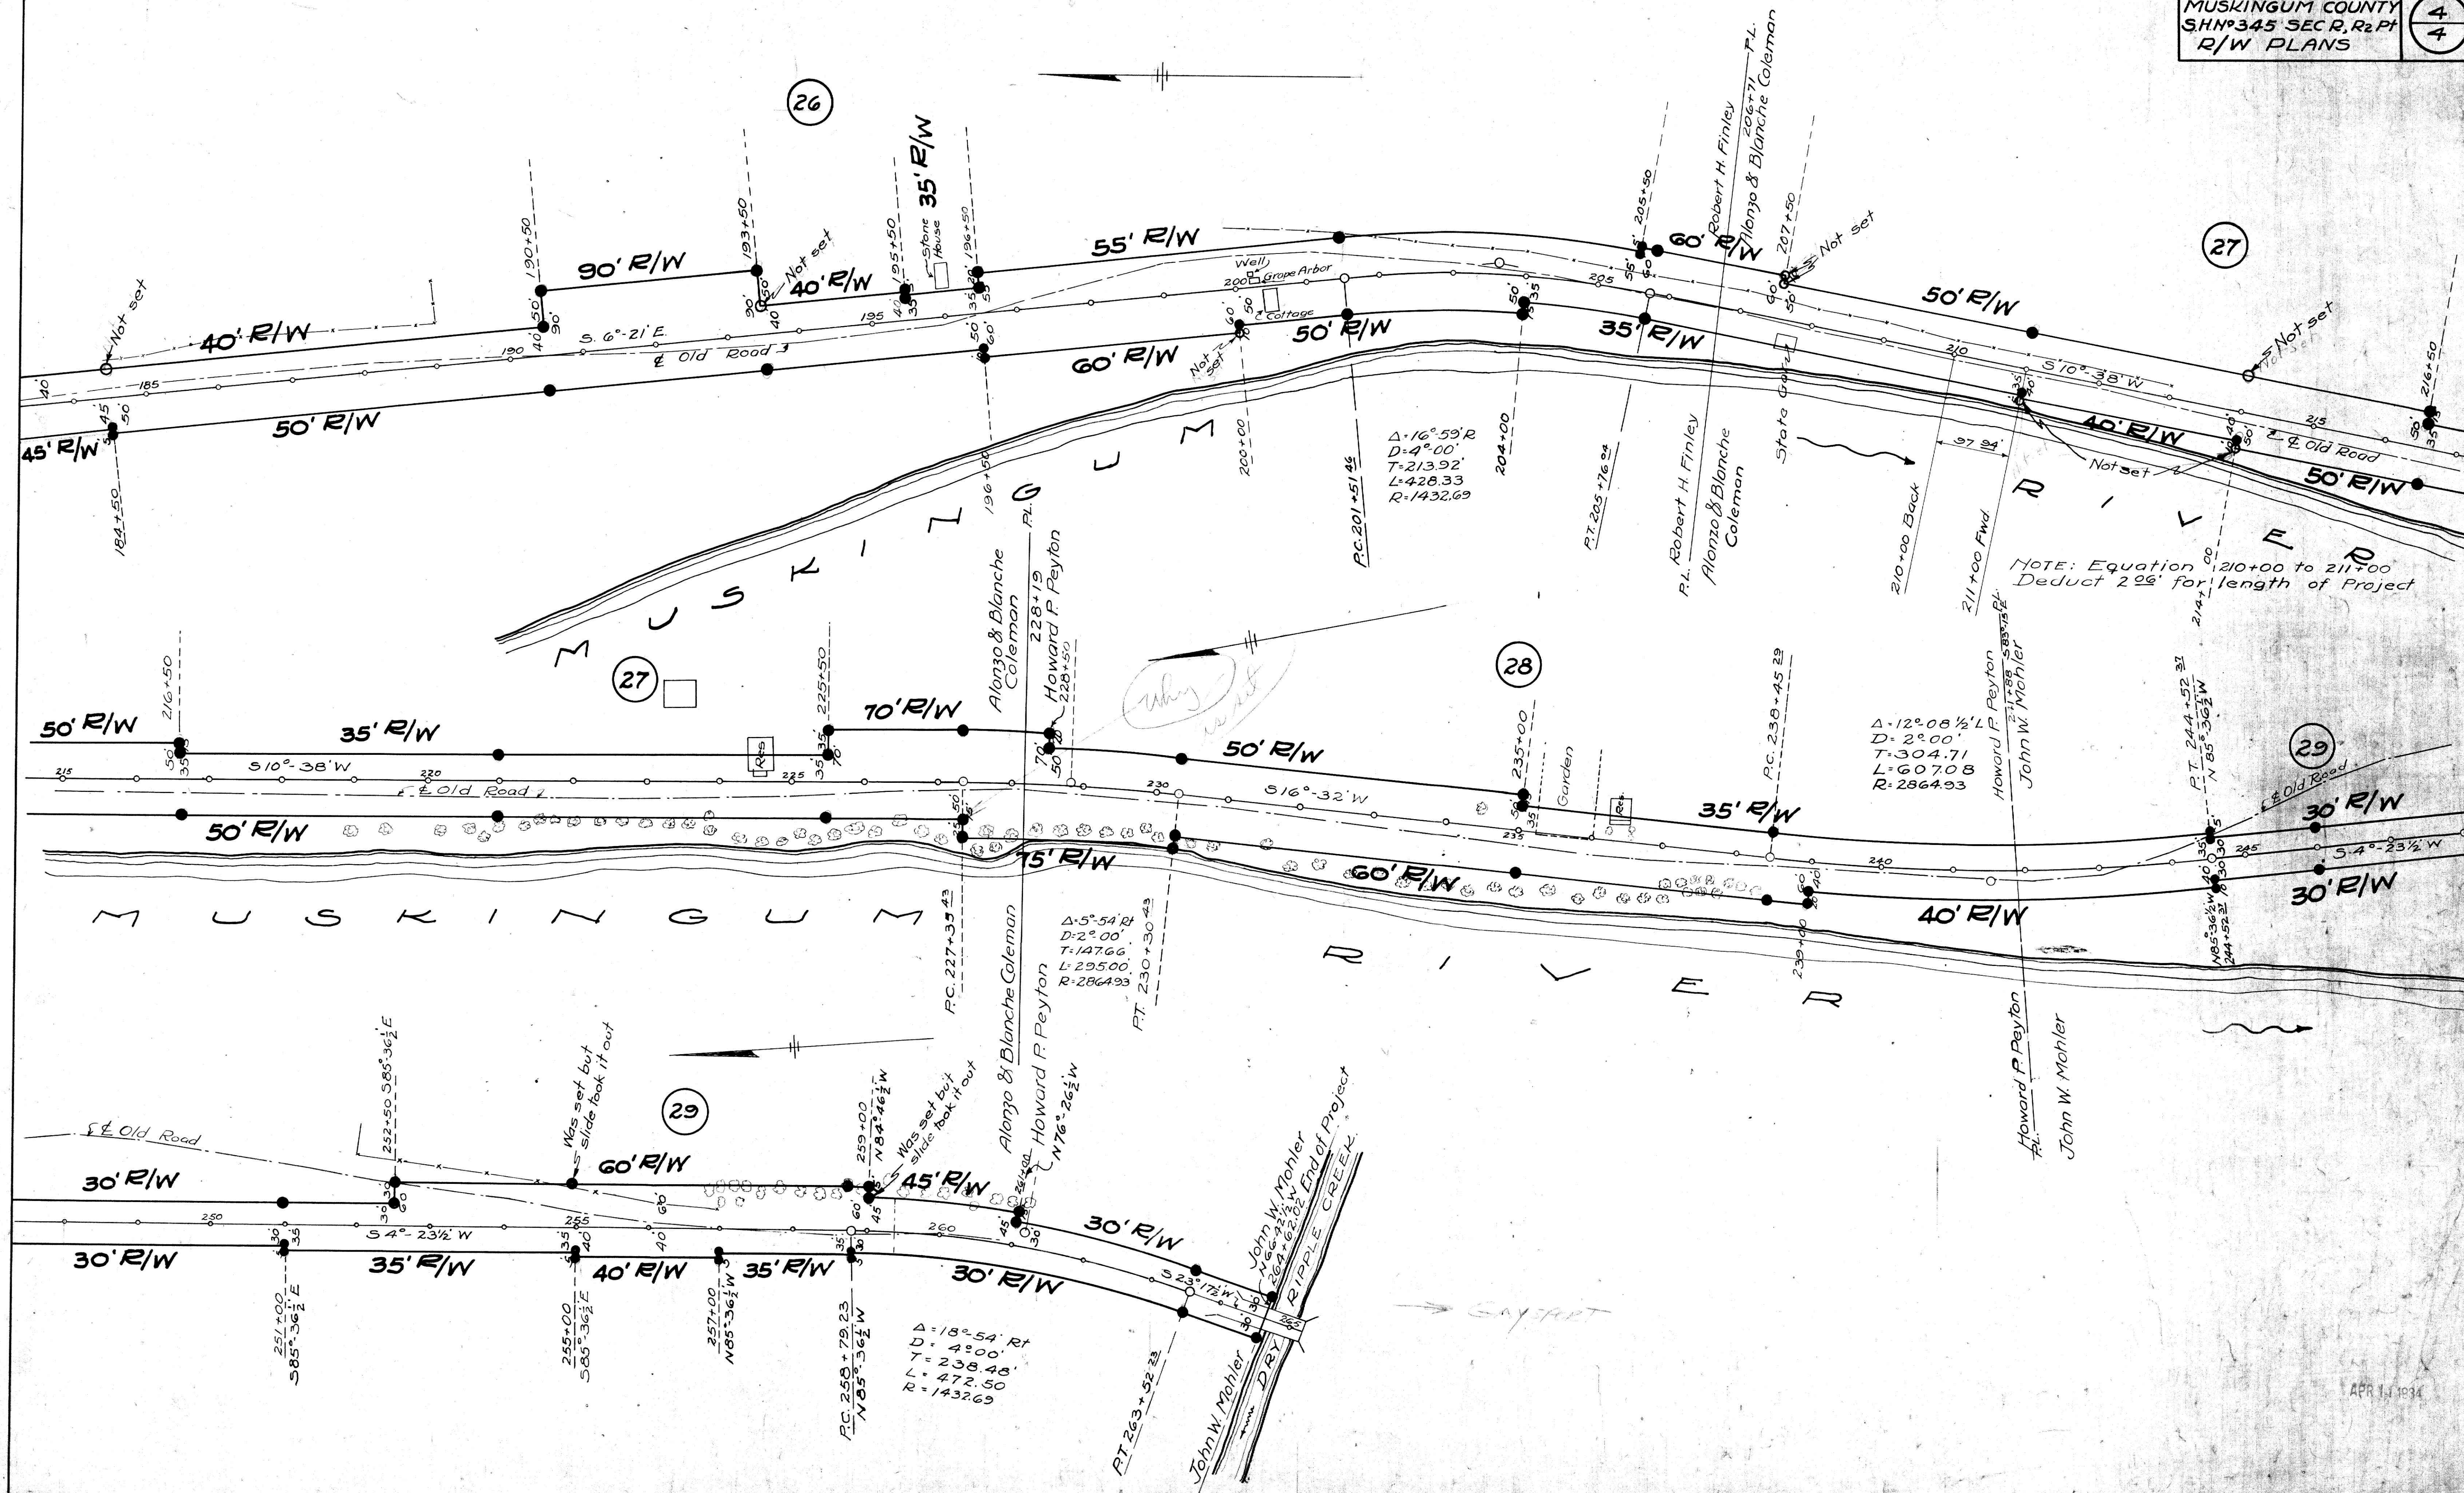

APR 14 1934