
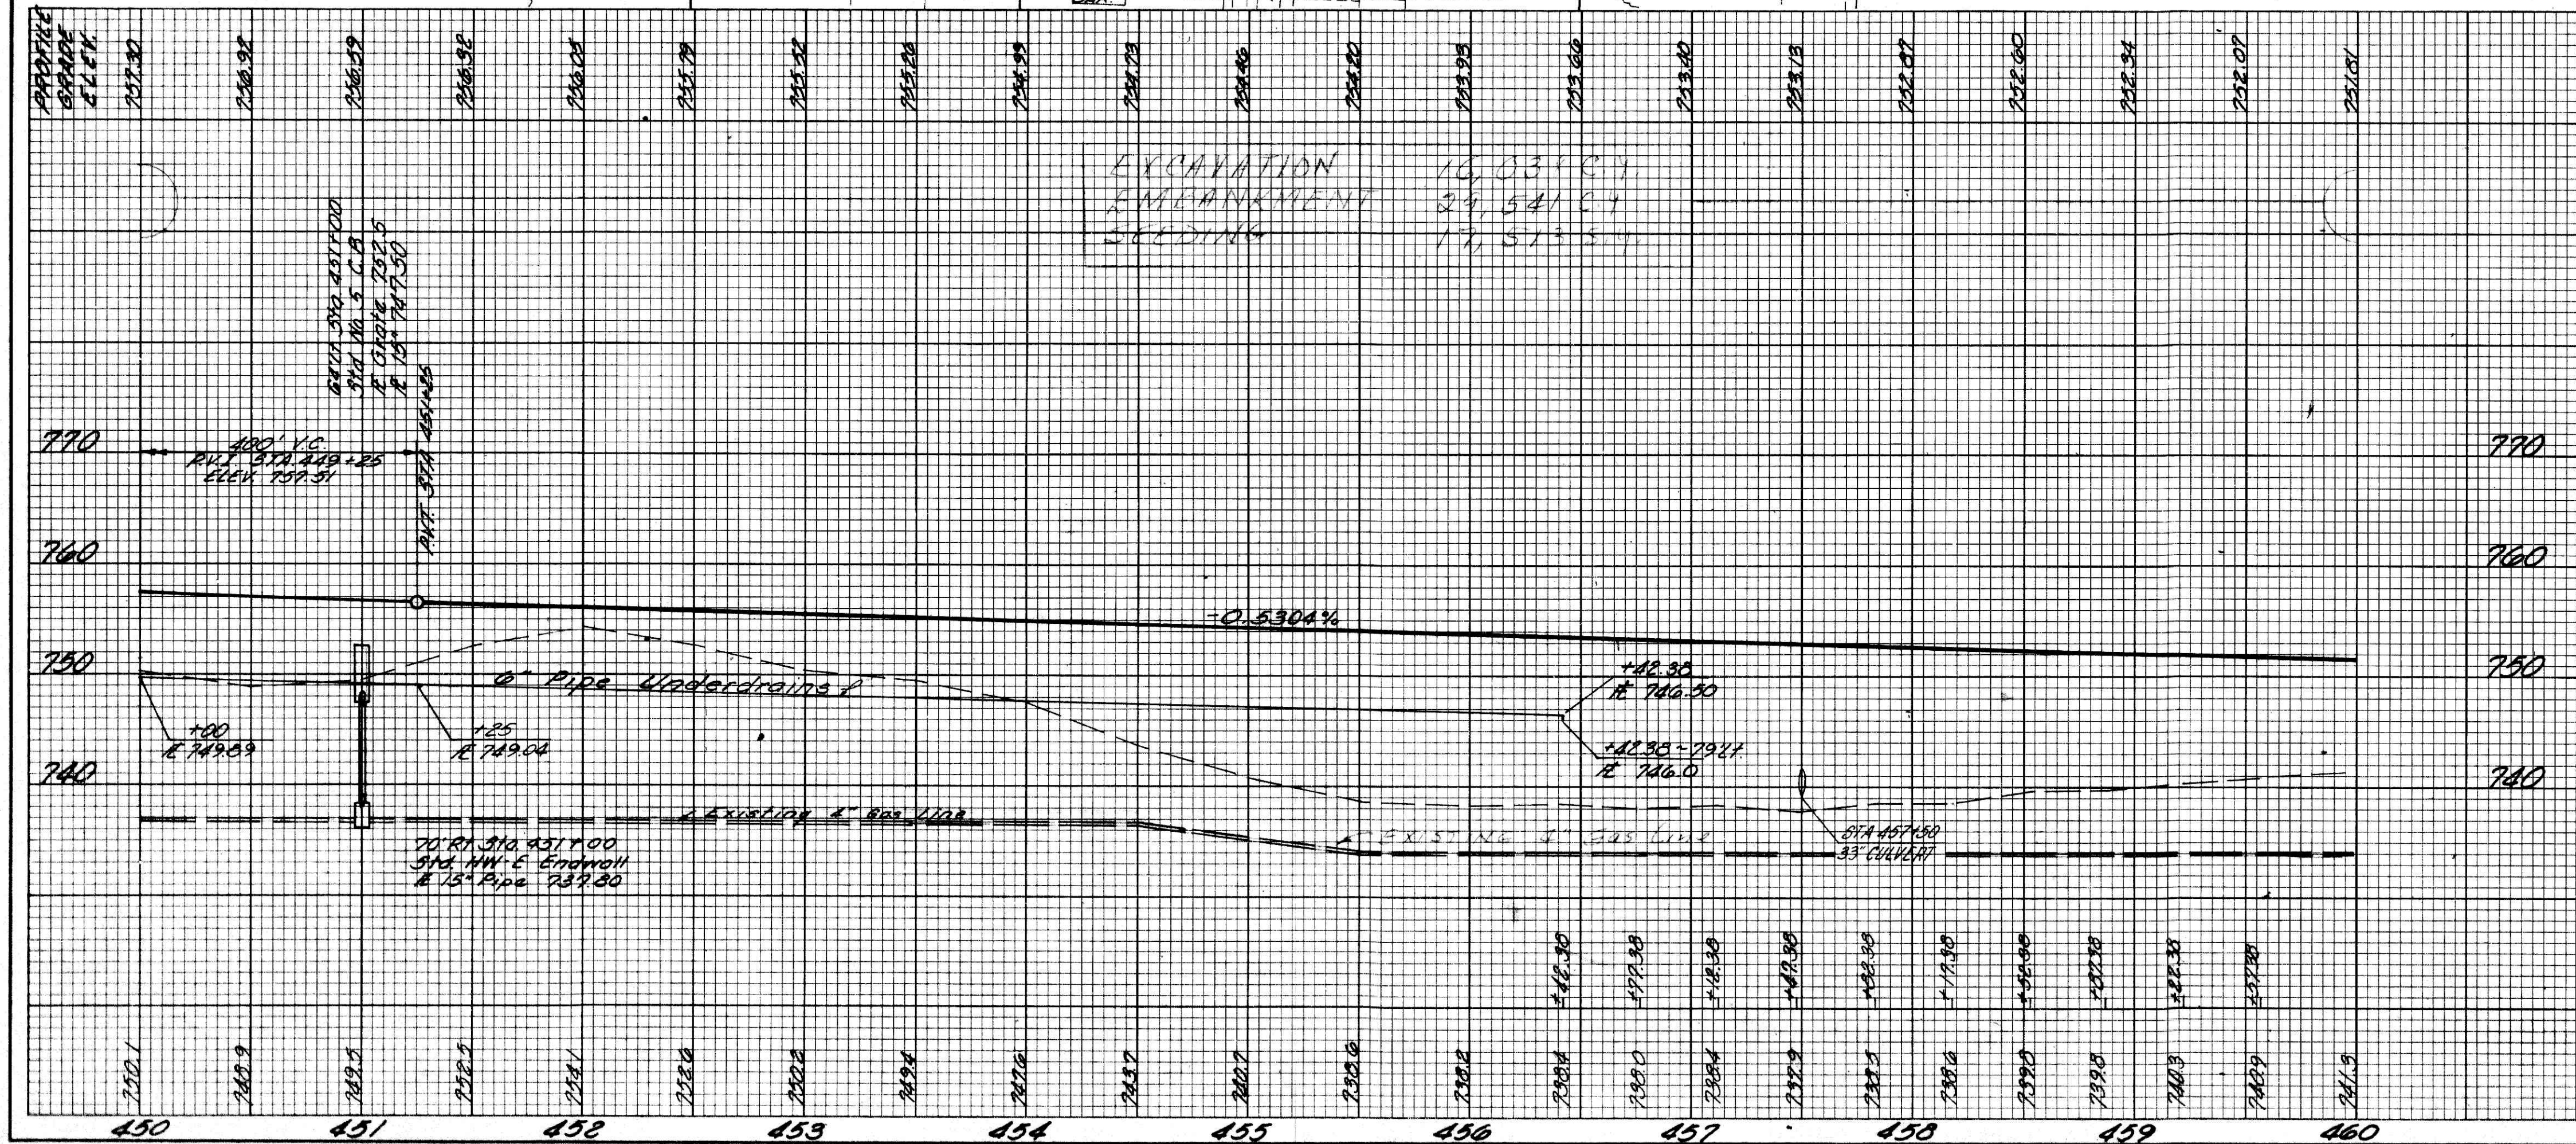


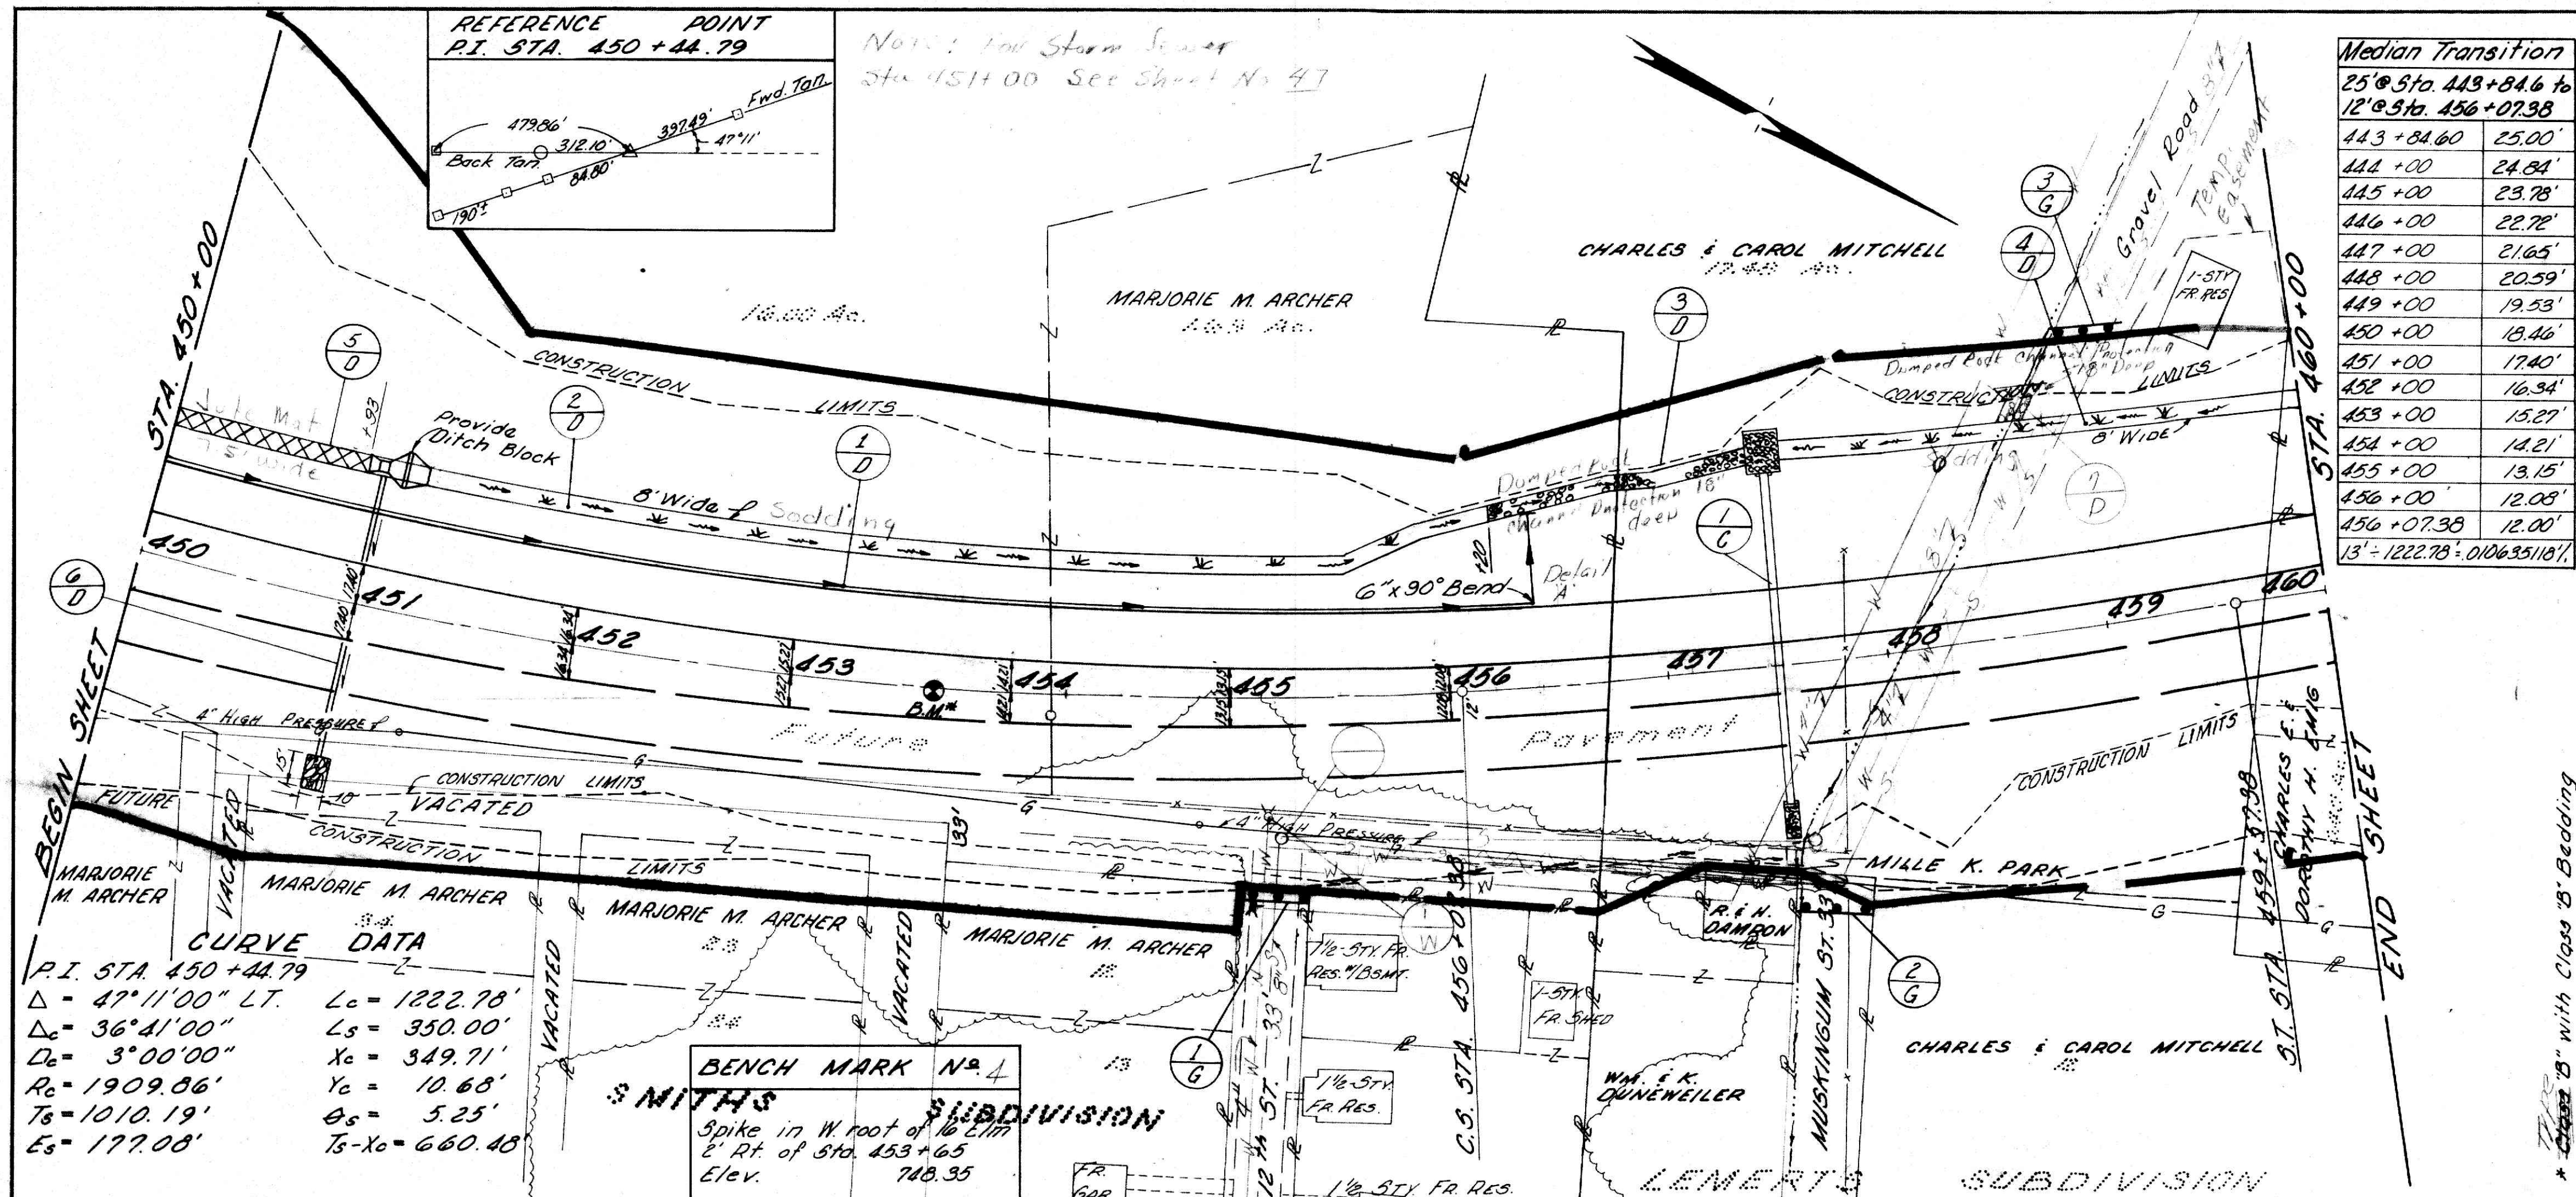

MUSKINGUM COUNTY				FED. RD. DIVISION		STATE		PROJECT		15	
MUS-60-31.70				2		OHIO					

REF. NO.	STATION TO STATION	SIDE	607	600	602	601	606	605	603	604	604	814	814	SEE SHEET NO.
1-D	450+00 - 456+42.35	Lt				DRUMPAH ROCK EXPOSED PROTECT	GUARD RAIL TYPE 4	6" PIPE UNDER DRAIN	* 15"	5	5	Value		
2-D	451+20 - 456+20	Lt		444		53		672	10			Each		
3-D	456+20 - 457+50	Lt												
4-D	457+50 - 460+00	Lt		222										
5-D	450+00 - 450+53	Lt	72											
6-D	451+00 - 451+53	Lt			0.26	14			134	1				
7-D	458+53	Lt				10								
8-D	455+20	Rt								1				
1-C	510 457+50	Lt												152
1-G	455+07 - 455+32	Rt					25							
2-G	457+53 - 457+78	Rt					25							
3-G	458+86 - 459+11	Lt												
1-V	455+12	Rt									1		1	
TOTALS			72	666	0.26	32	75	672	10	1				