
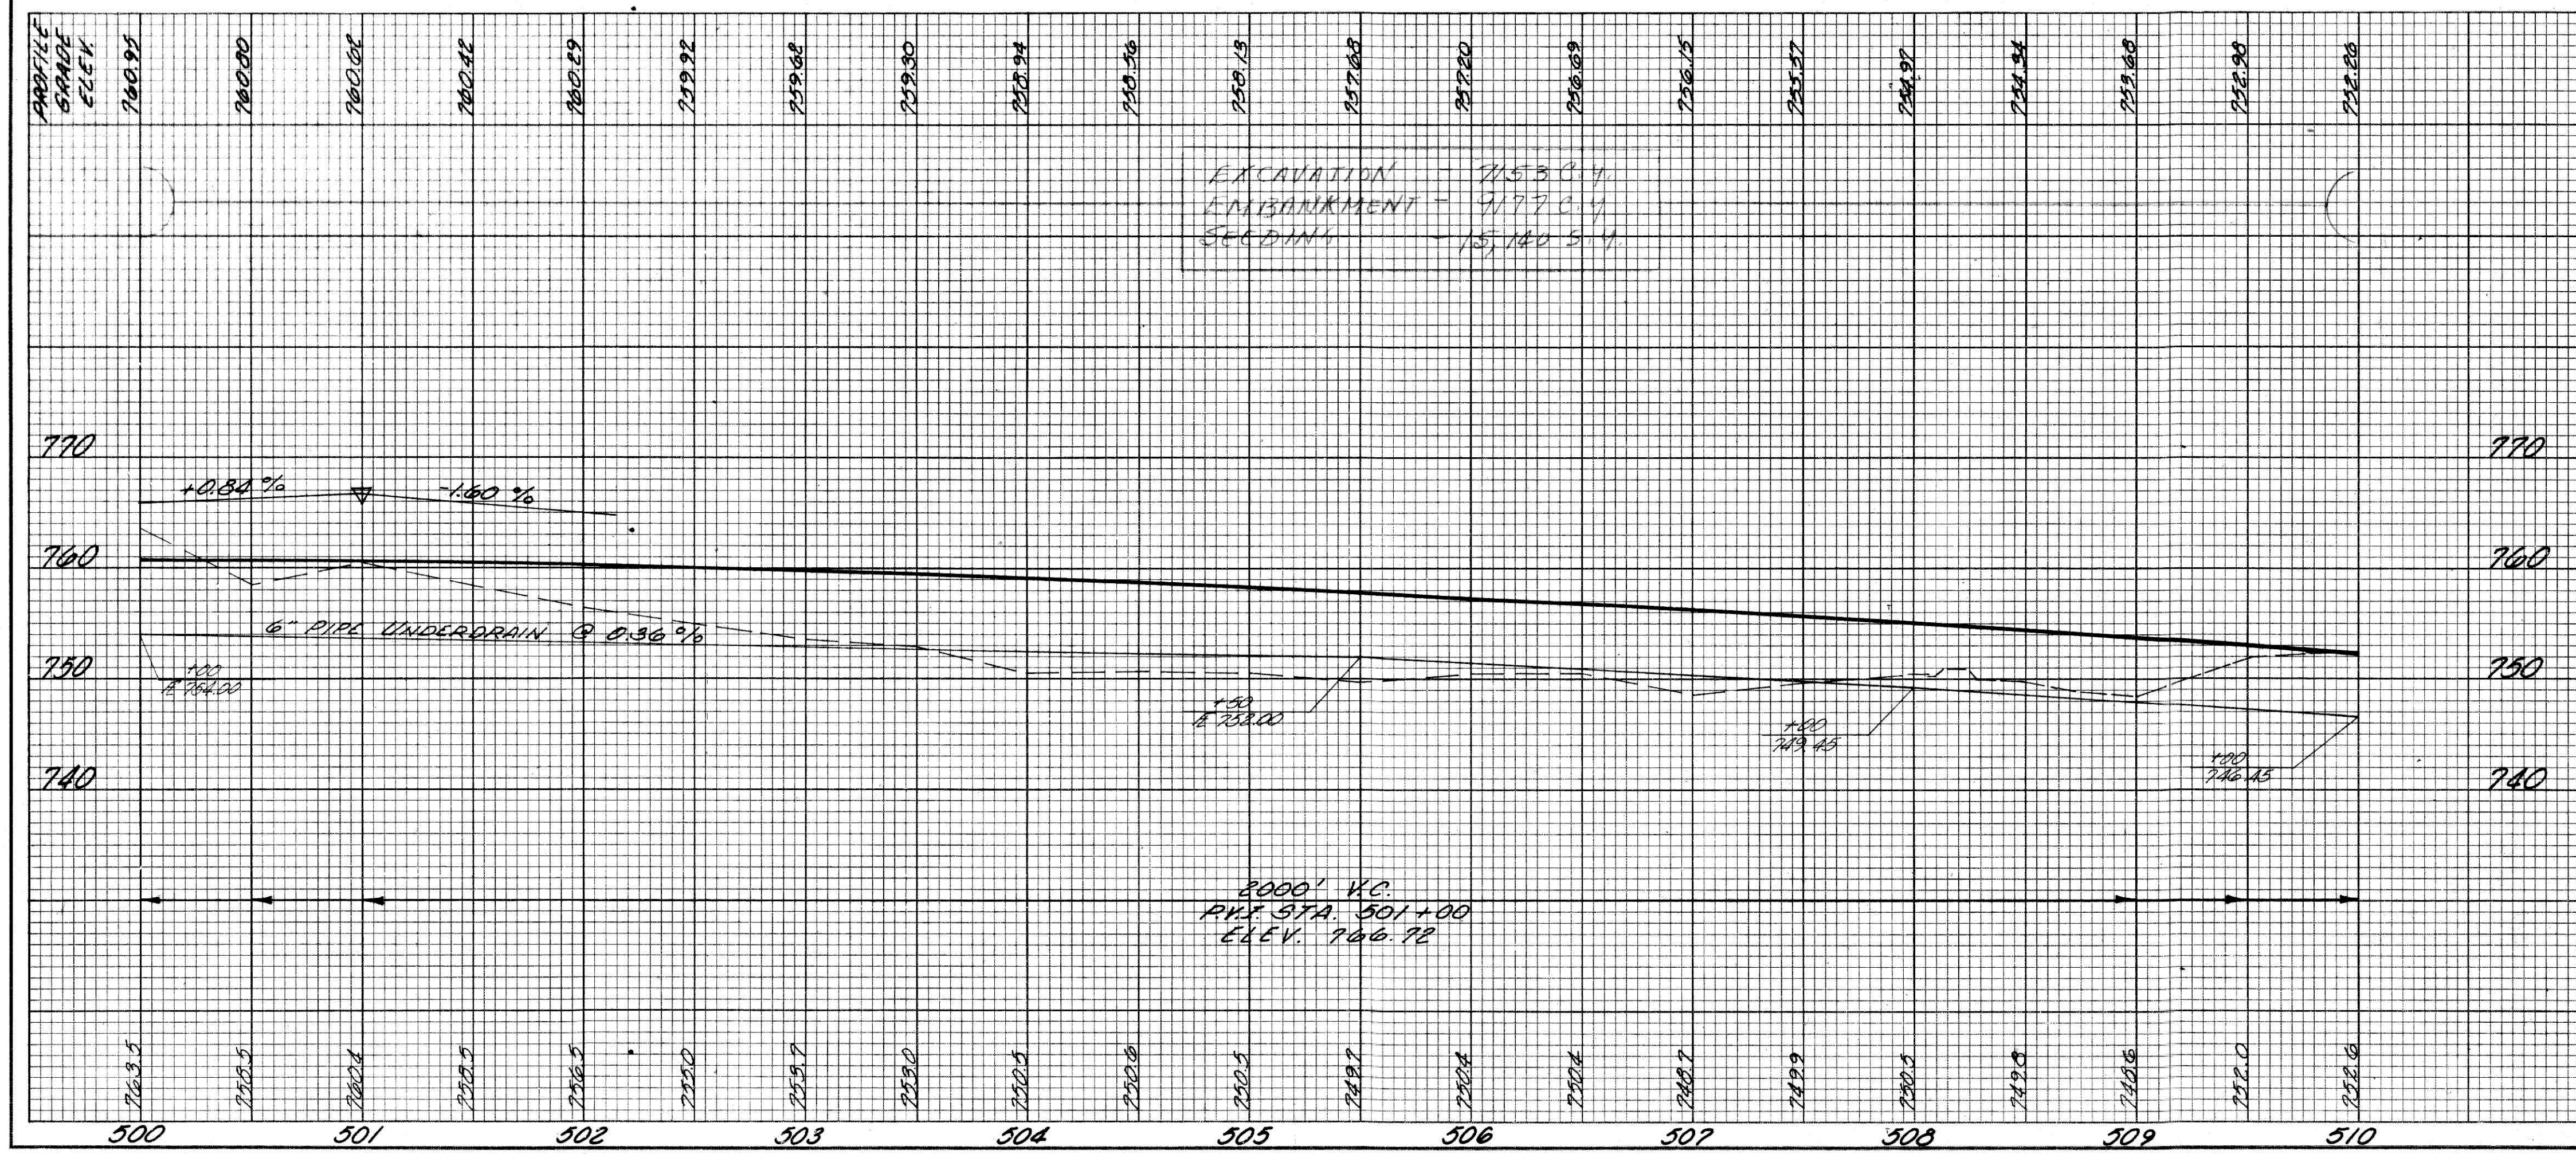


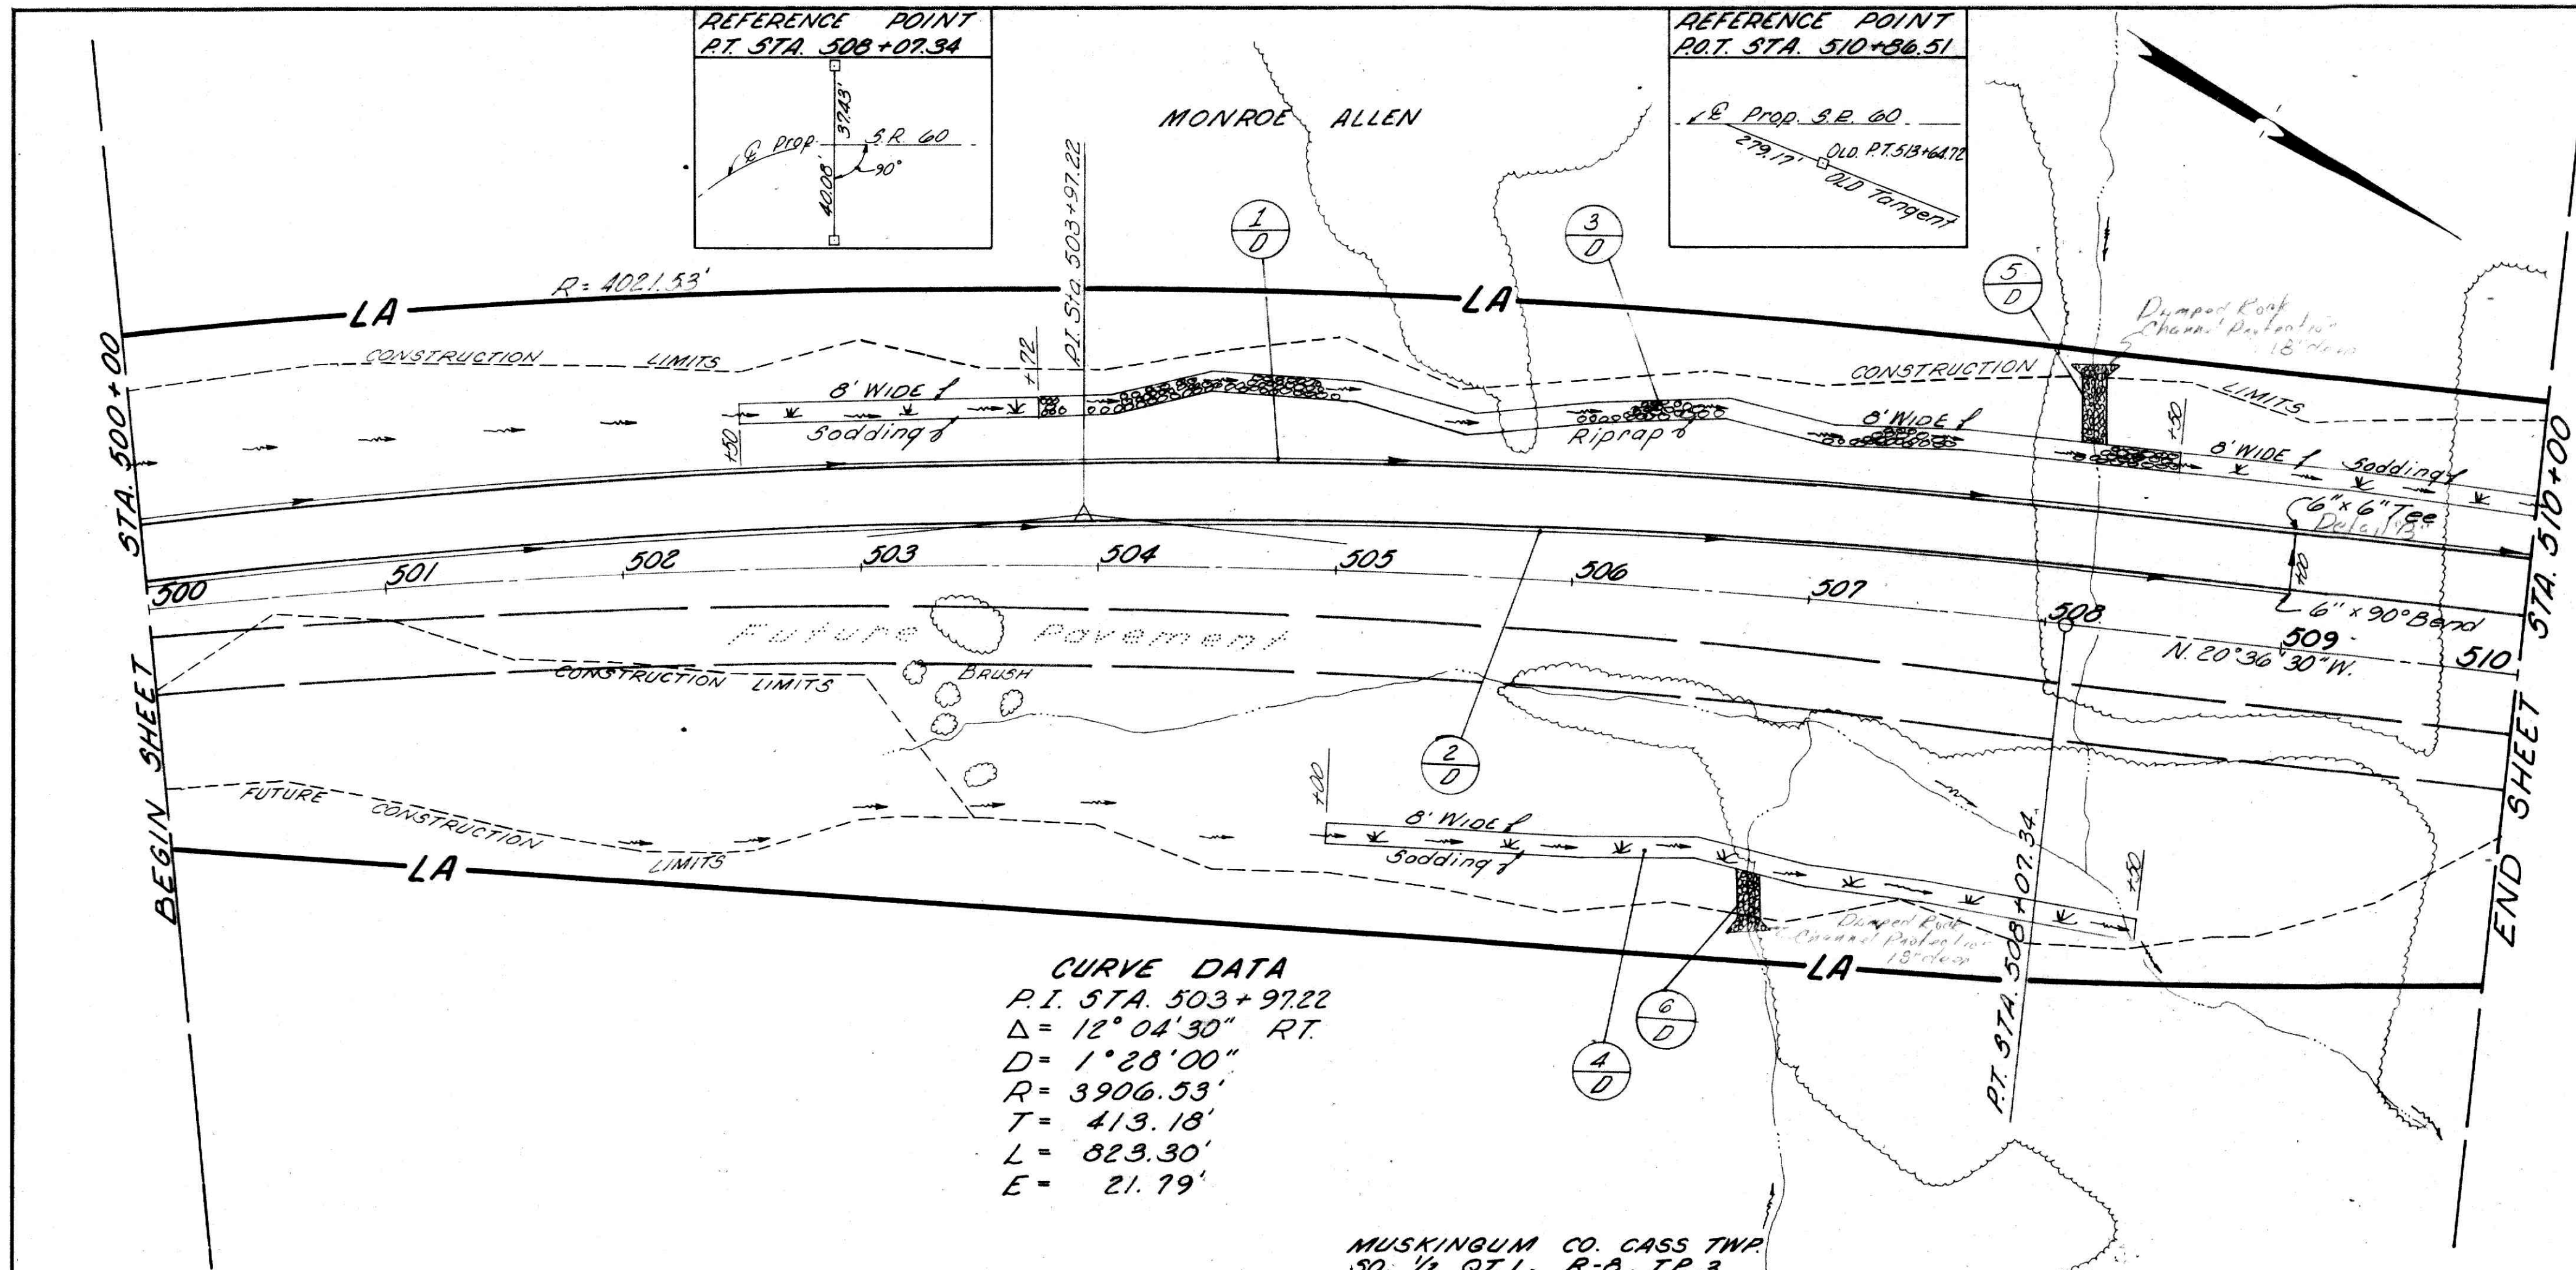

MUSKINGUM COUNTY MUS - 60 - 31.70				FED. RD. DIVISION		STATE		PROJECT		20	
				2		OHIO					
REF. NO.	STATION TO STATION	SIDE	ESTIMATED QUANTITIES	605	601	600	600	600	600	600	TOTALS

PLAN AND PROFILE ~ STA. 500+00 TO STA. 510+00
PLAN AND PROFILE ~ STA. 500+00 TO STA. 510+00