


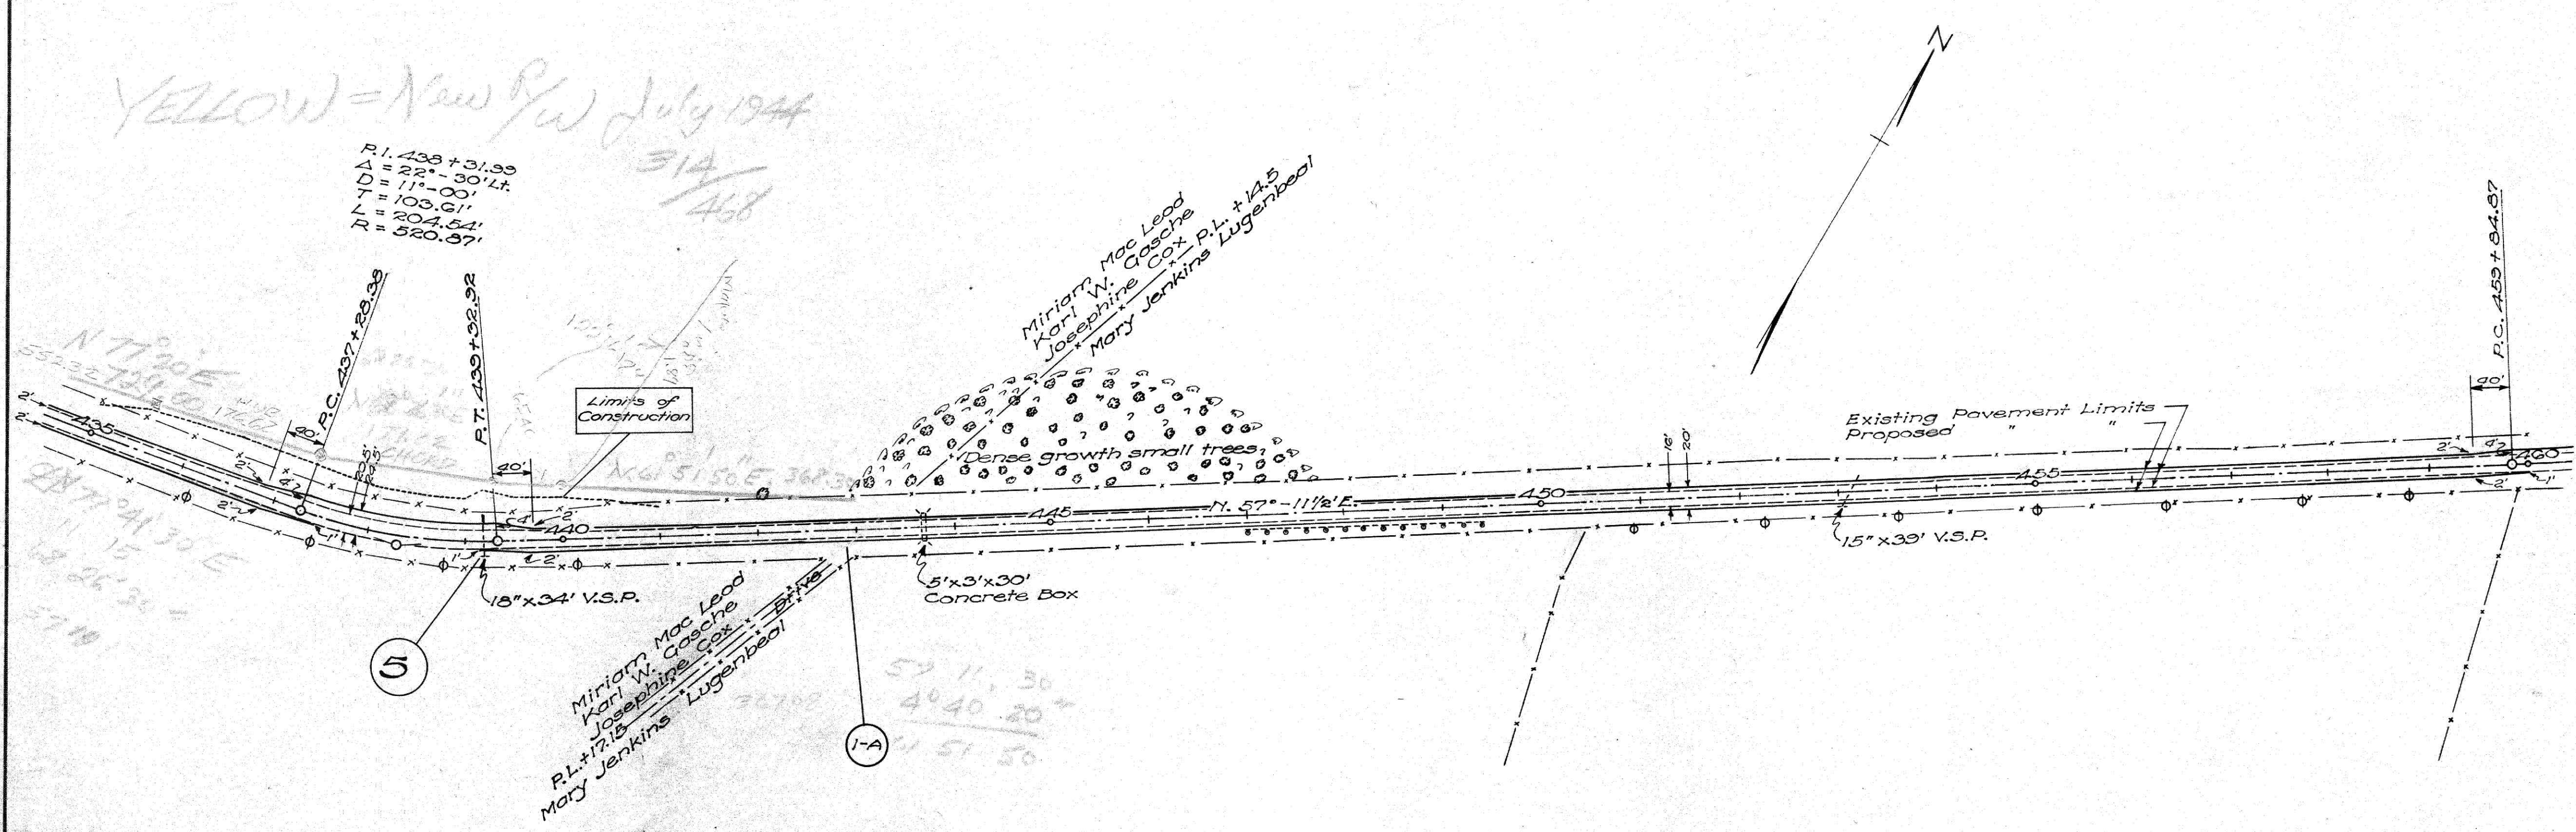

DRIVES & APPROACHES				
Item No.	Station	Side	Type	I-17 Cu. Yds.
1-A	443+17.2	Rt.	Road	0.33
Total				0.33

Note:-
See page 11 for
Table of Super-
elevations.

D.M. #10, Elev. 901.79
Spike in triple Elm
Sta. 440+56 - 31' left.

STRUCTURES ~ 20 FT. SPAN & UNDER								
Struct. No.	Station	Present			Proposed			Sheet No.
		Type	Size	Length	Type	Size	Length	
5	439+22.6	V.S.P	18"	34'	Pipe	18"	Ext 10'Lt	13

