


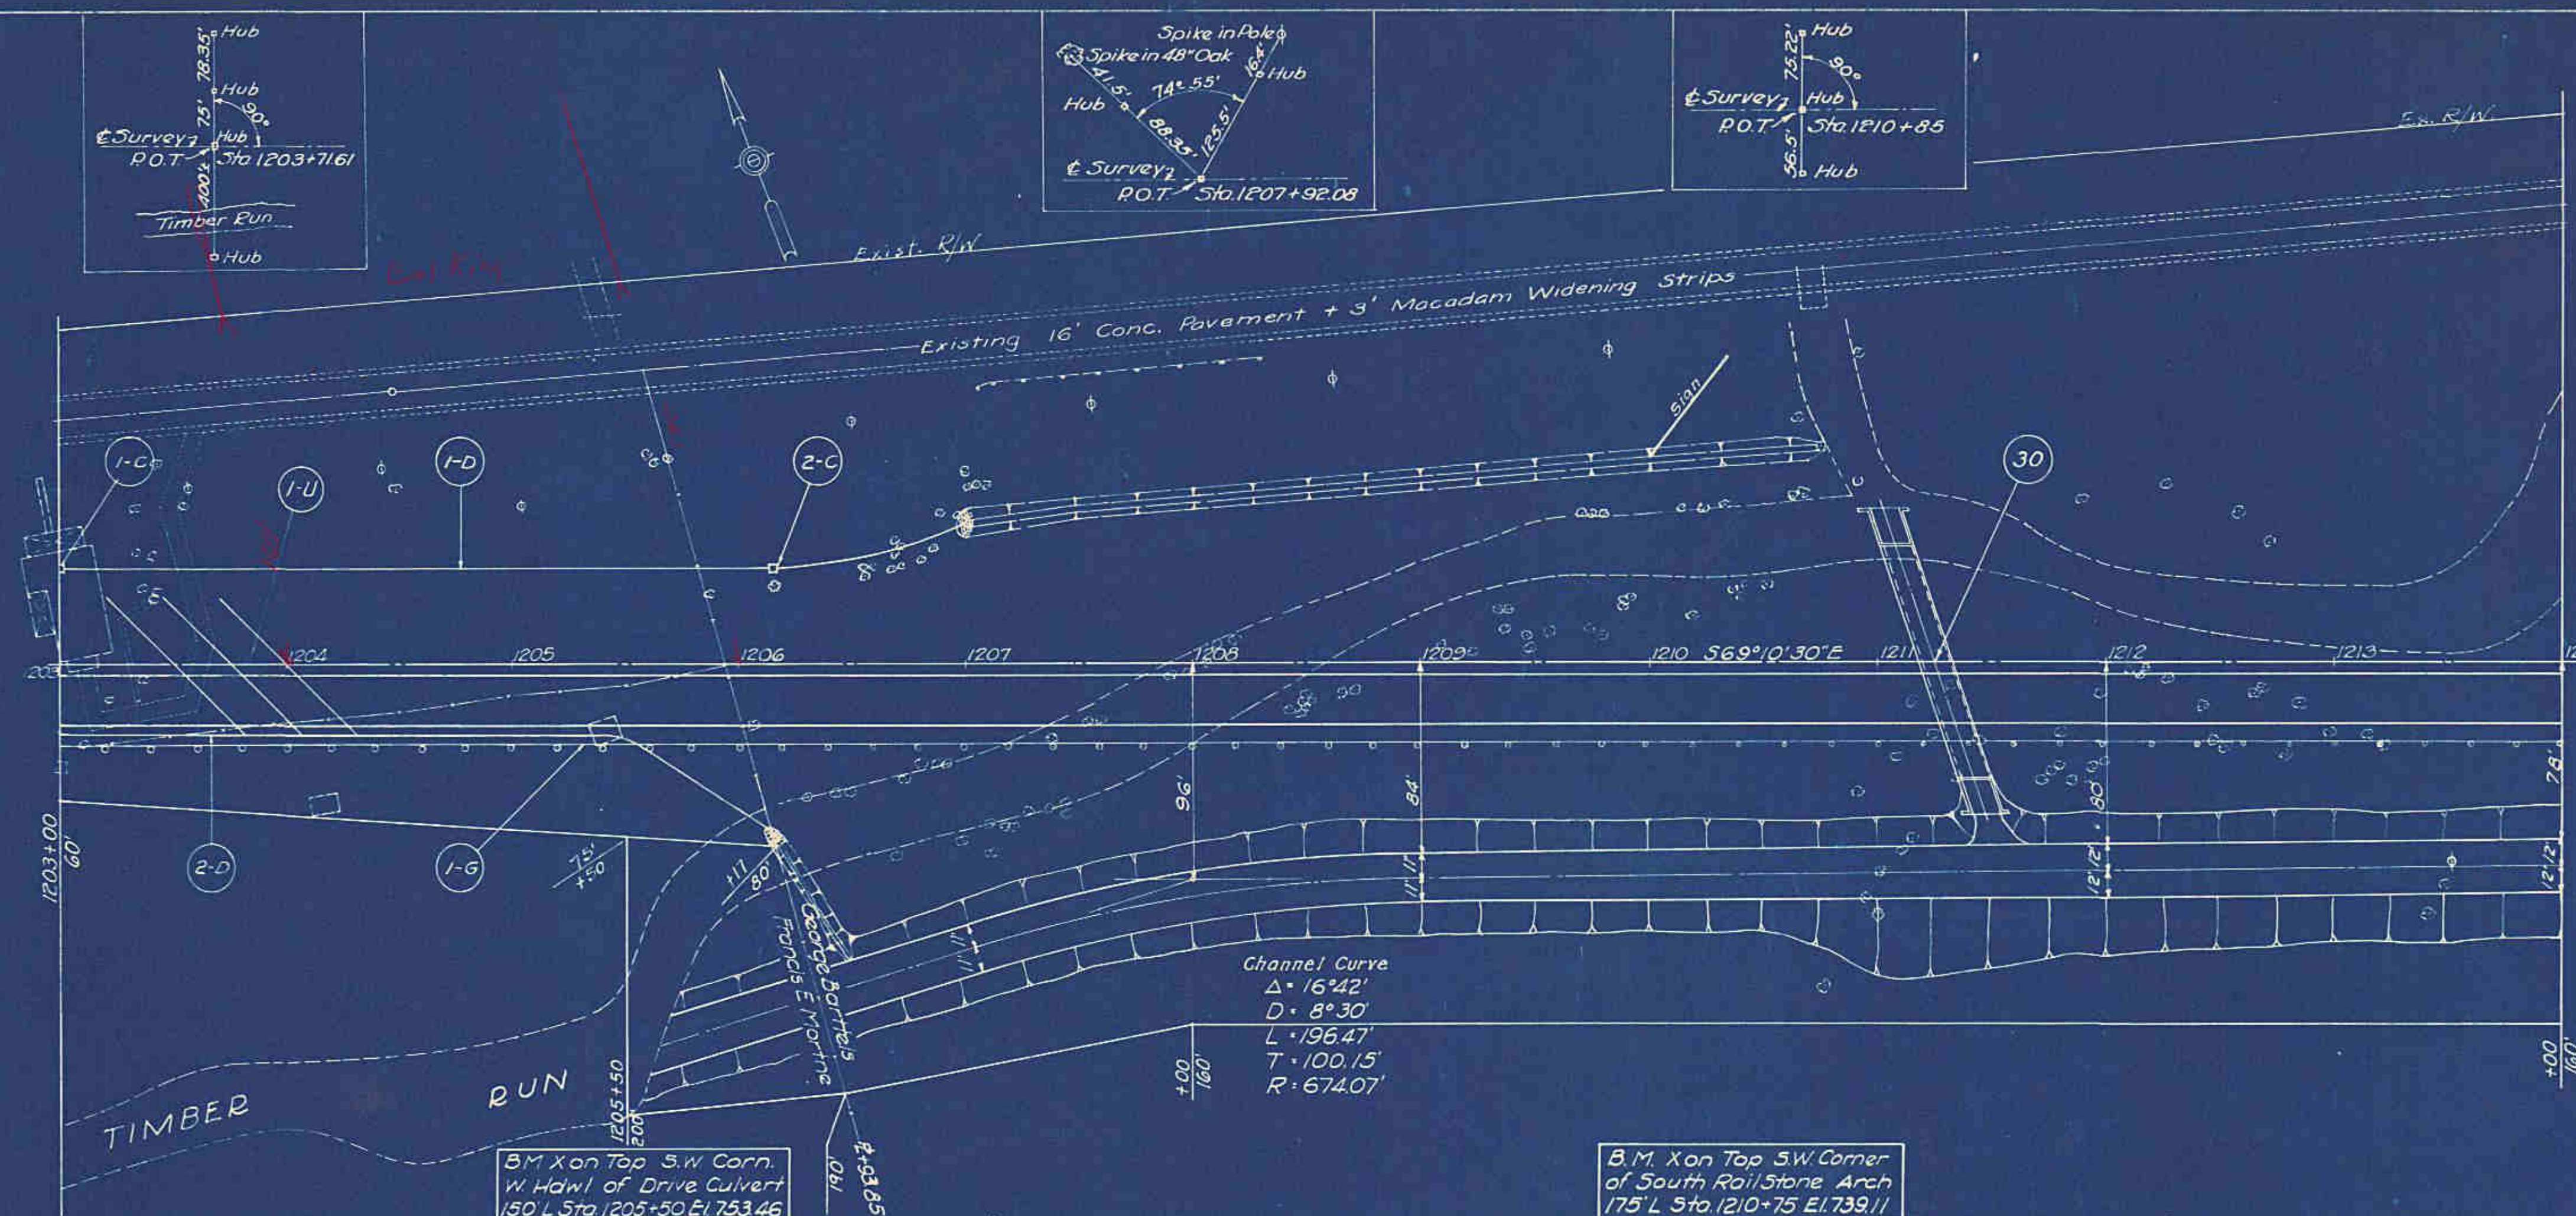

STRUCTURES 20' SPAN & UNDER			
Str. No.	Station	Description	Details on Sheet No.
30	1211+25	12' x 9' x 142' Large Box Culvert	159

GUARD RAIL (G)			
Item No.	Station		Guard Rail Lin. Ft.
	From	To	
1-G	1203+00	1214+00	1100
Total			1100

ROADWAY DRAINAGE (D)									
Item No.	Station		Side	Outlet Pipe				Pipe Specials	
	From	To		12"	8"	12"	8"	12"	8"
1-D	1203+02	1207+00	Lt.			40		354	
2-D	1203+00	1206+10	Rt.		68		258		
Total					68	40	258	354	

CATCH BASINS (C)			
Item No.	Station	Side	Catch Basins
1-C	1203+01	Lt.	1
2-C	1206+15	Lt.	1
Total			2

PIPE UNDERDRAINS (U)			
Item No.	Side	Station	4" Pipe Underdrain Lin. Ft.
1-U	Rt.	1203+50/1204+00	252

