
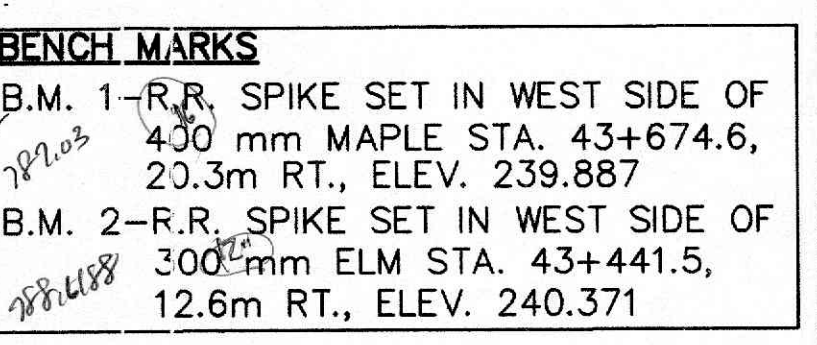


CALCULATED	CHECKED
SAM	JLW

MUS-60-43.500

8	25
---	----

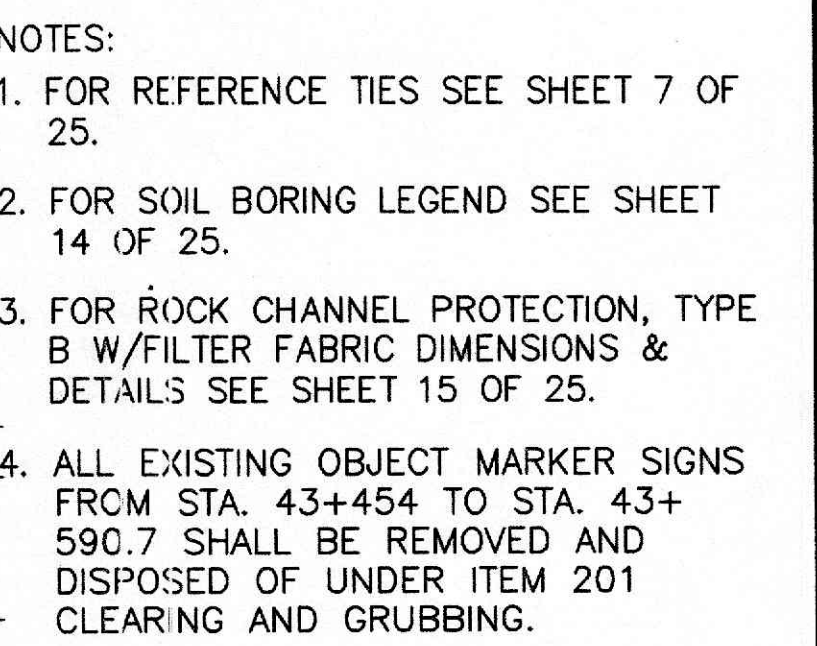

ESTIMATED QUANTITIES											
REF. NO.	STATION		SIDE	2022 GUARDRAIL REMOVED	501 ROCK CHANNEL PROTECTION, TYPE B W/ FABRIC FILTER	606 GUARDRAIL TYPE 5	606 ANCHOR ASSEMBLY, TYPE E	606 BRIDGE TERMINAL ASSEMBLY, TYPE 4			
	FROM	TO									
1-GR	43+483.772	43+514.252	L.T.	METER	CU METER	METER	EACH	EACH			
2-GR	43+484.946	43+515.426	R.T.			22,860	1	1			
3-GR	43+527.587	43+558.067	L.T.			22,860	1	1			
4-GR	43+528.761	43+559.241	R.T.			22,860	1	1			
1-RC	43+512.91	43+519.42	BOTH		50						
2-RC	43+523.92	43+529.99	BOTH		94						
1-R	43+479.610	43+567.716	L.T.	88							
2-R	43+477.098	43+565.326	R.T.	88							
TOTAL				176	144	91,440	4	4			