


MCFARLAND PLACE

Begin Project MUS. 22-8.12
Sta. 425+71.10

FED. RD. DIVISION	STATE	PROJECT	TYPE FUNDS
2	OHIO		

49
52


MUS. 22-(8.12-9.85)
R/W PLAN

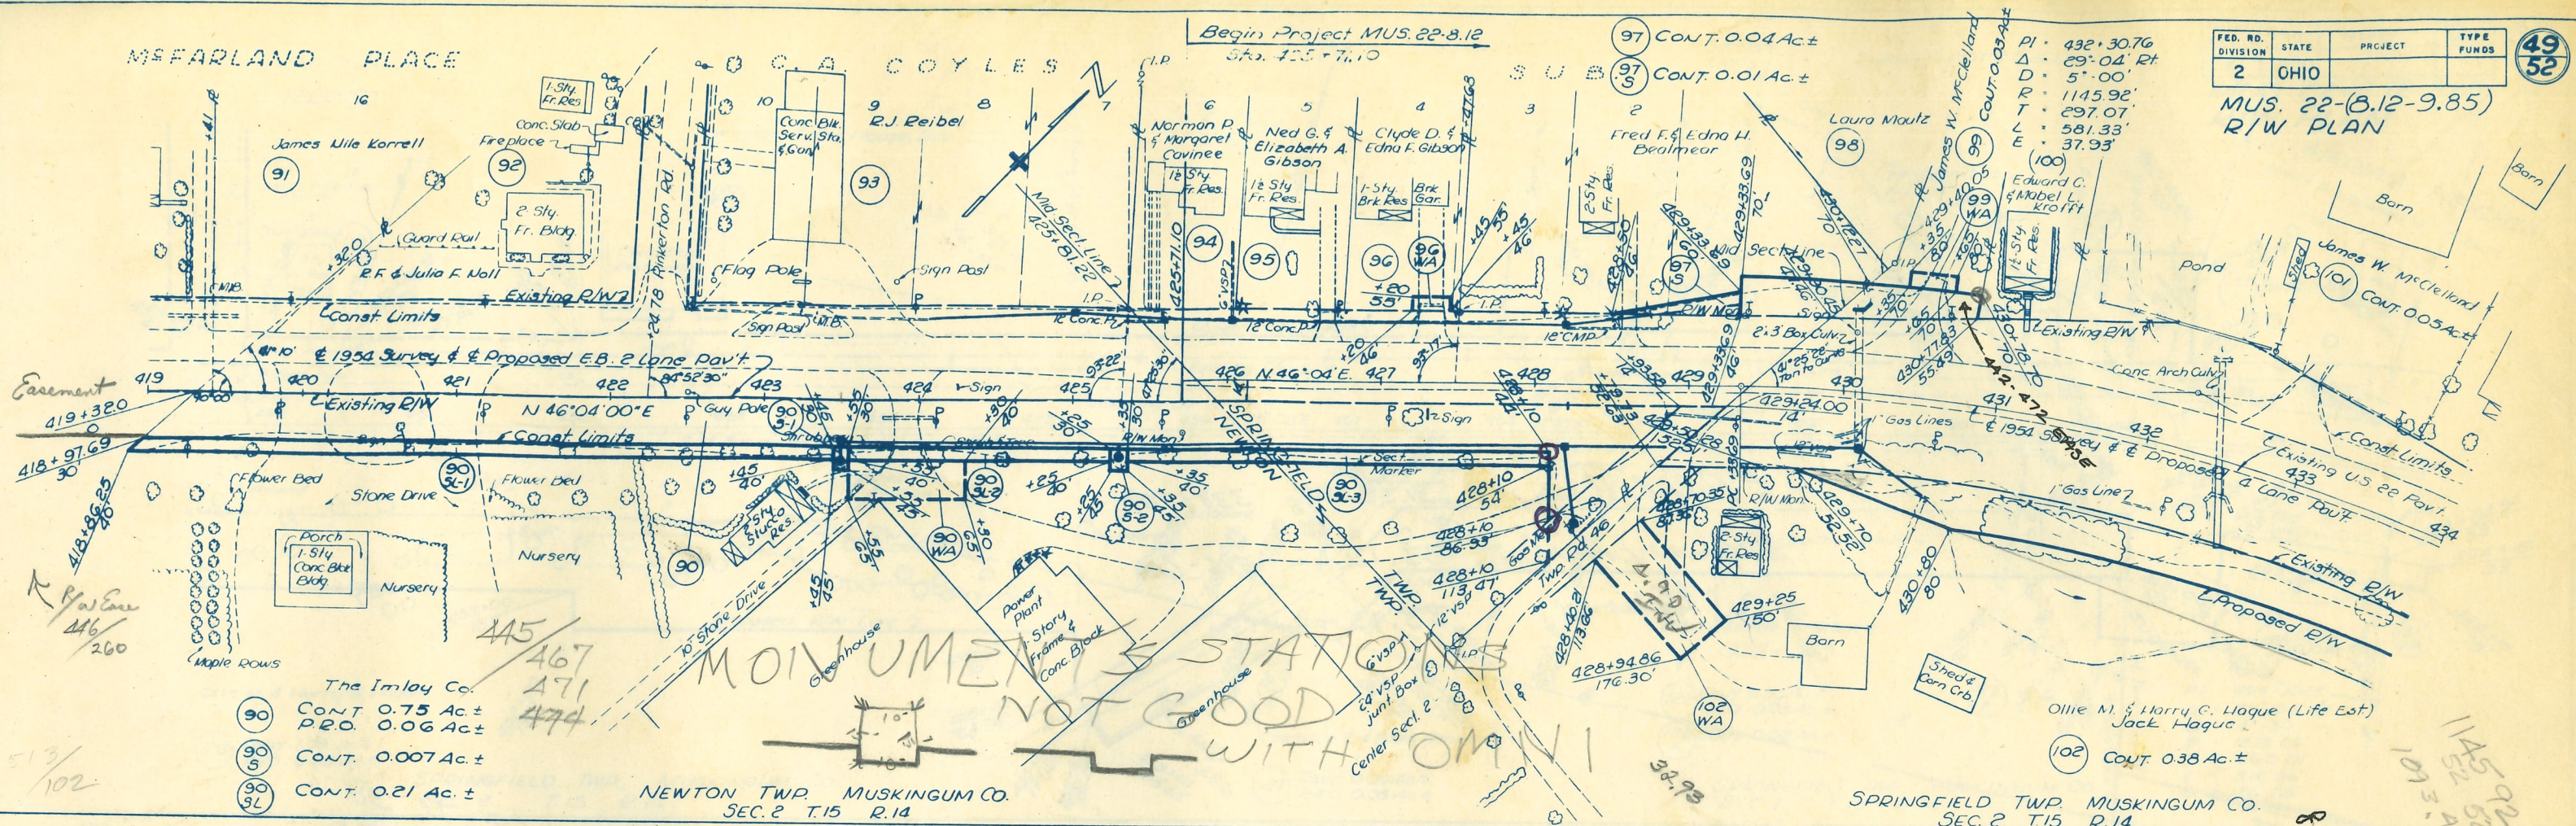

- 90 CONT. 0.75 Ac ±
P.R.O. 0.06 Ac ±
- 90 S CONT. 0.007 Ac ±
- 90 SL CONT. 0.21 Ac ±

MAYSVILLE COUNTRY PLACE

ZANESVILLE TERRACE

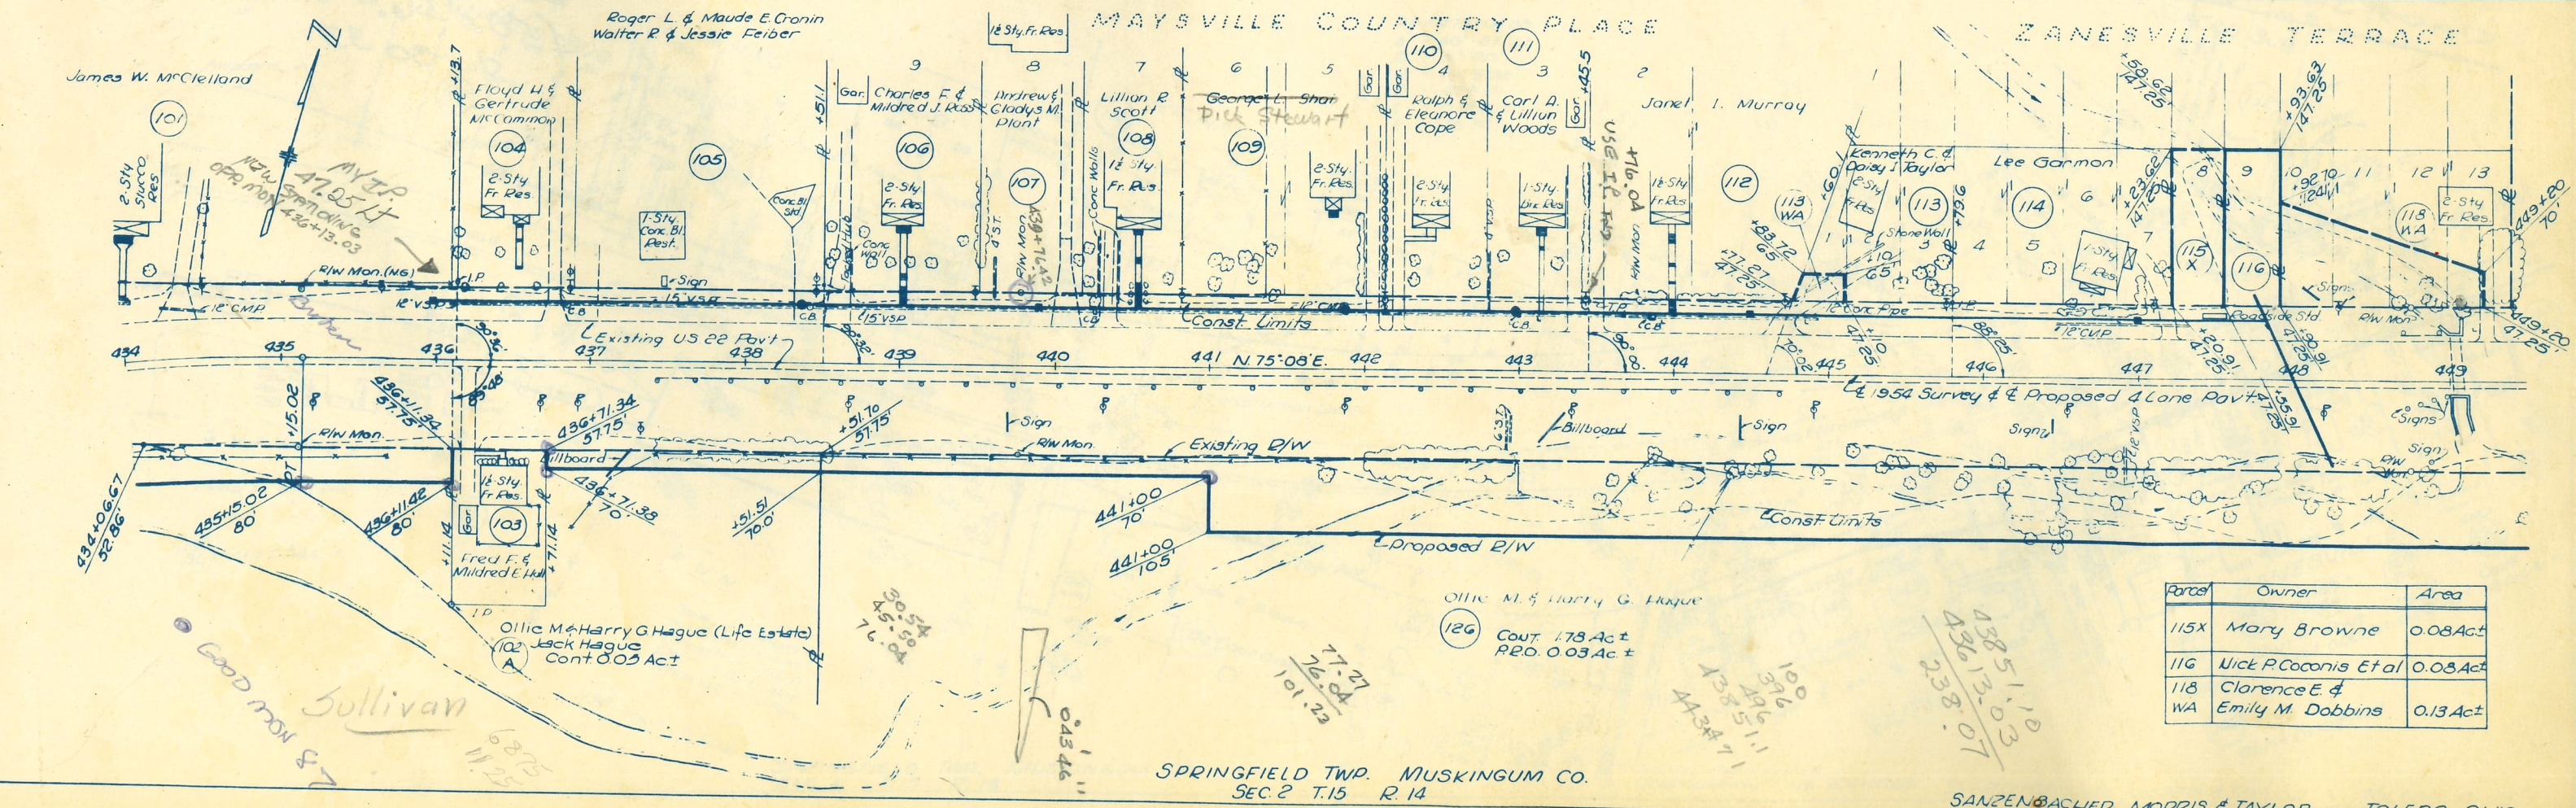


Parcel	Owner	Area
115X	Mary Browne	0.08 Act
116	Nick P. Coconis Et Al	0.08 Act
118 WA	Clarence E. & Emily M. Dobbins	0.13 Act

FED. RD. DIVISION	STATE	PROJECT	TYPE FUNDS
2	OHIO		


51
52

MUS. 22-(8.12-9.85)
R/W PLAN

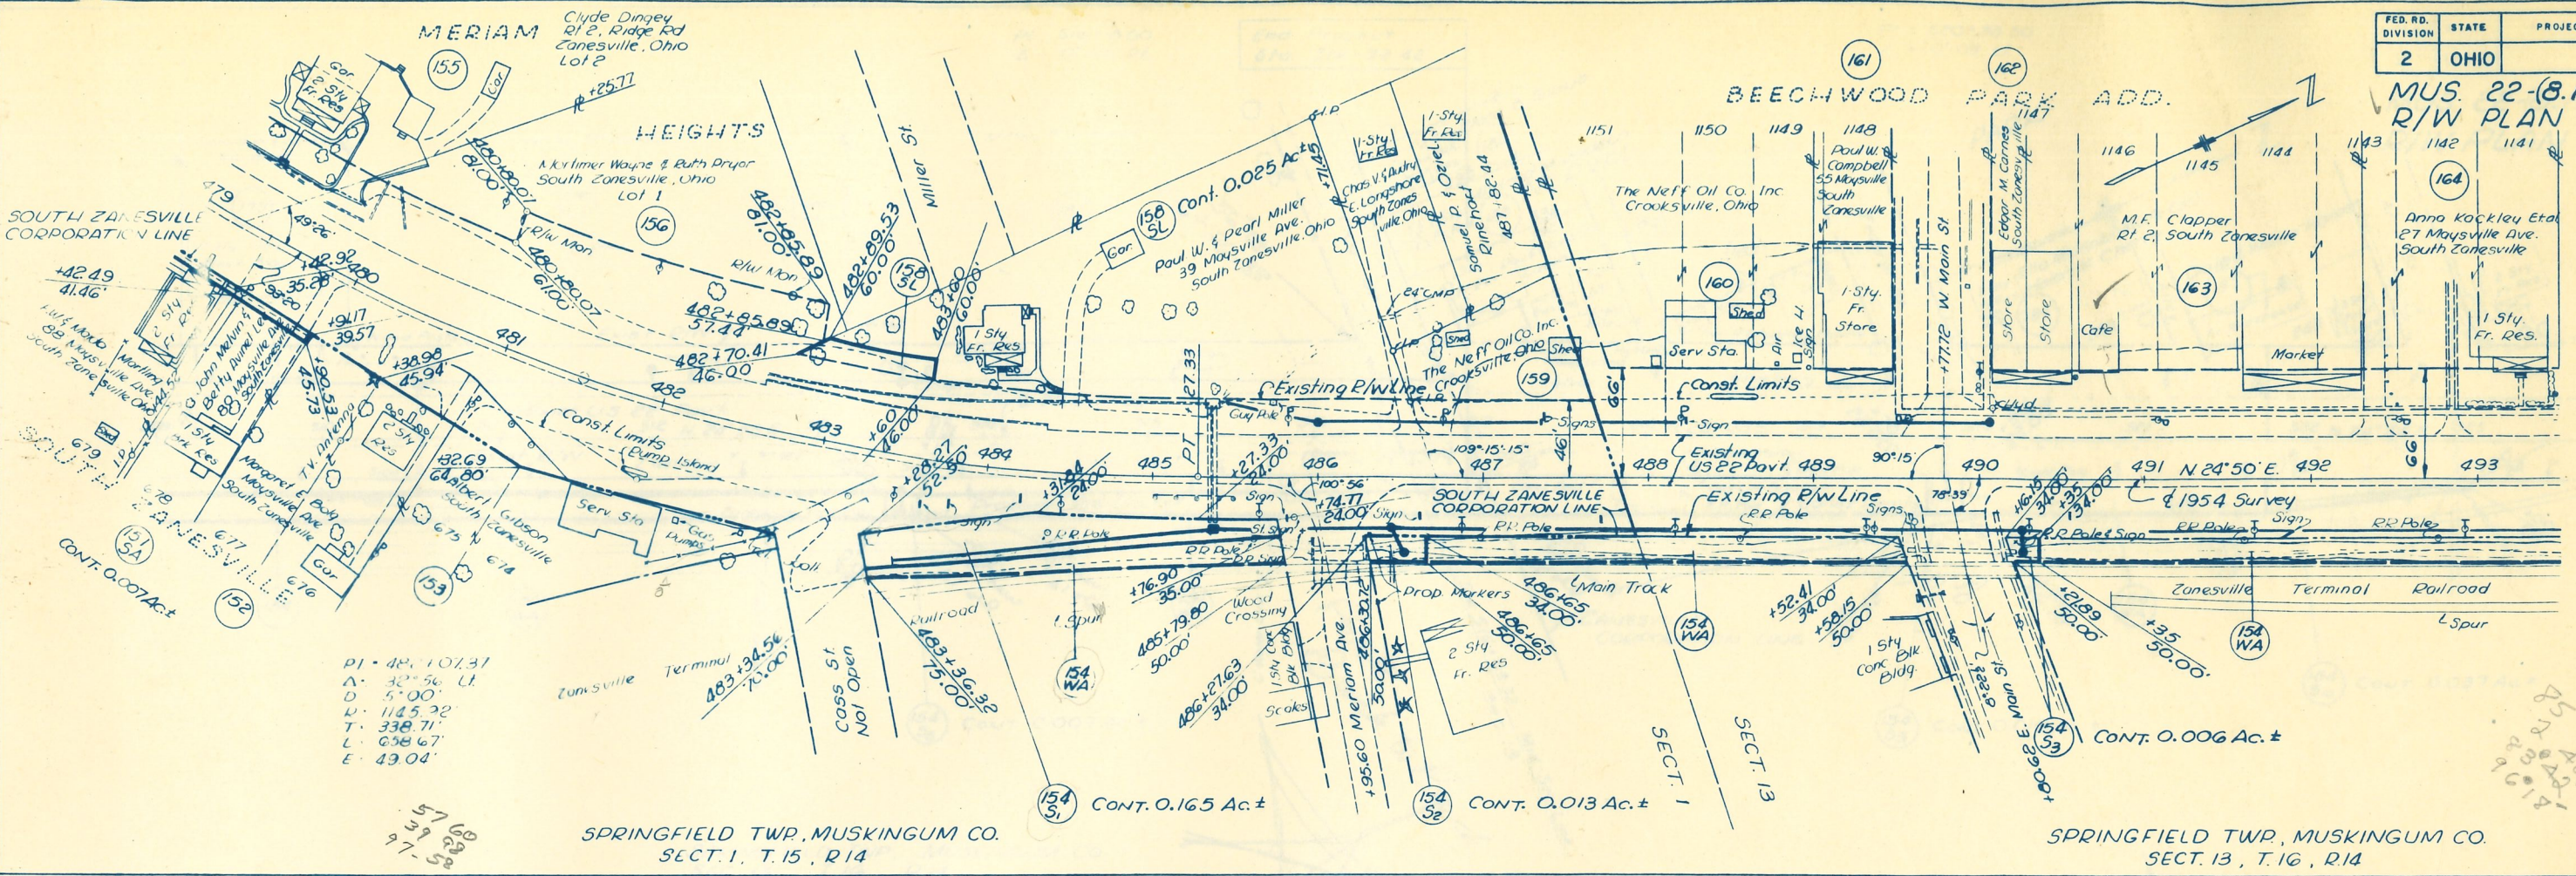

SPRINGFIELD TWP, MUSKINGUM CO.
SECT. 1, T. 15, R. 14

SPRINGFIELD TWP, MUSKINGUM CO.
SECT. 13, T. 16, R. 14

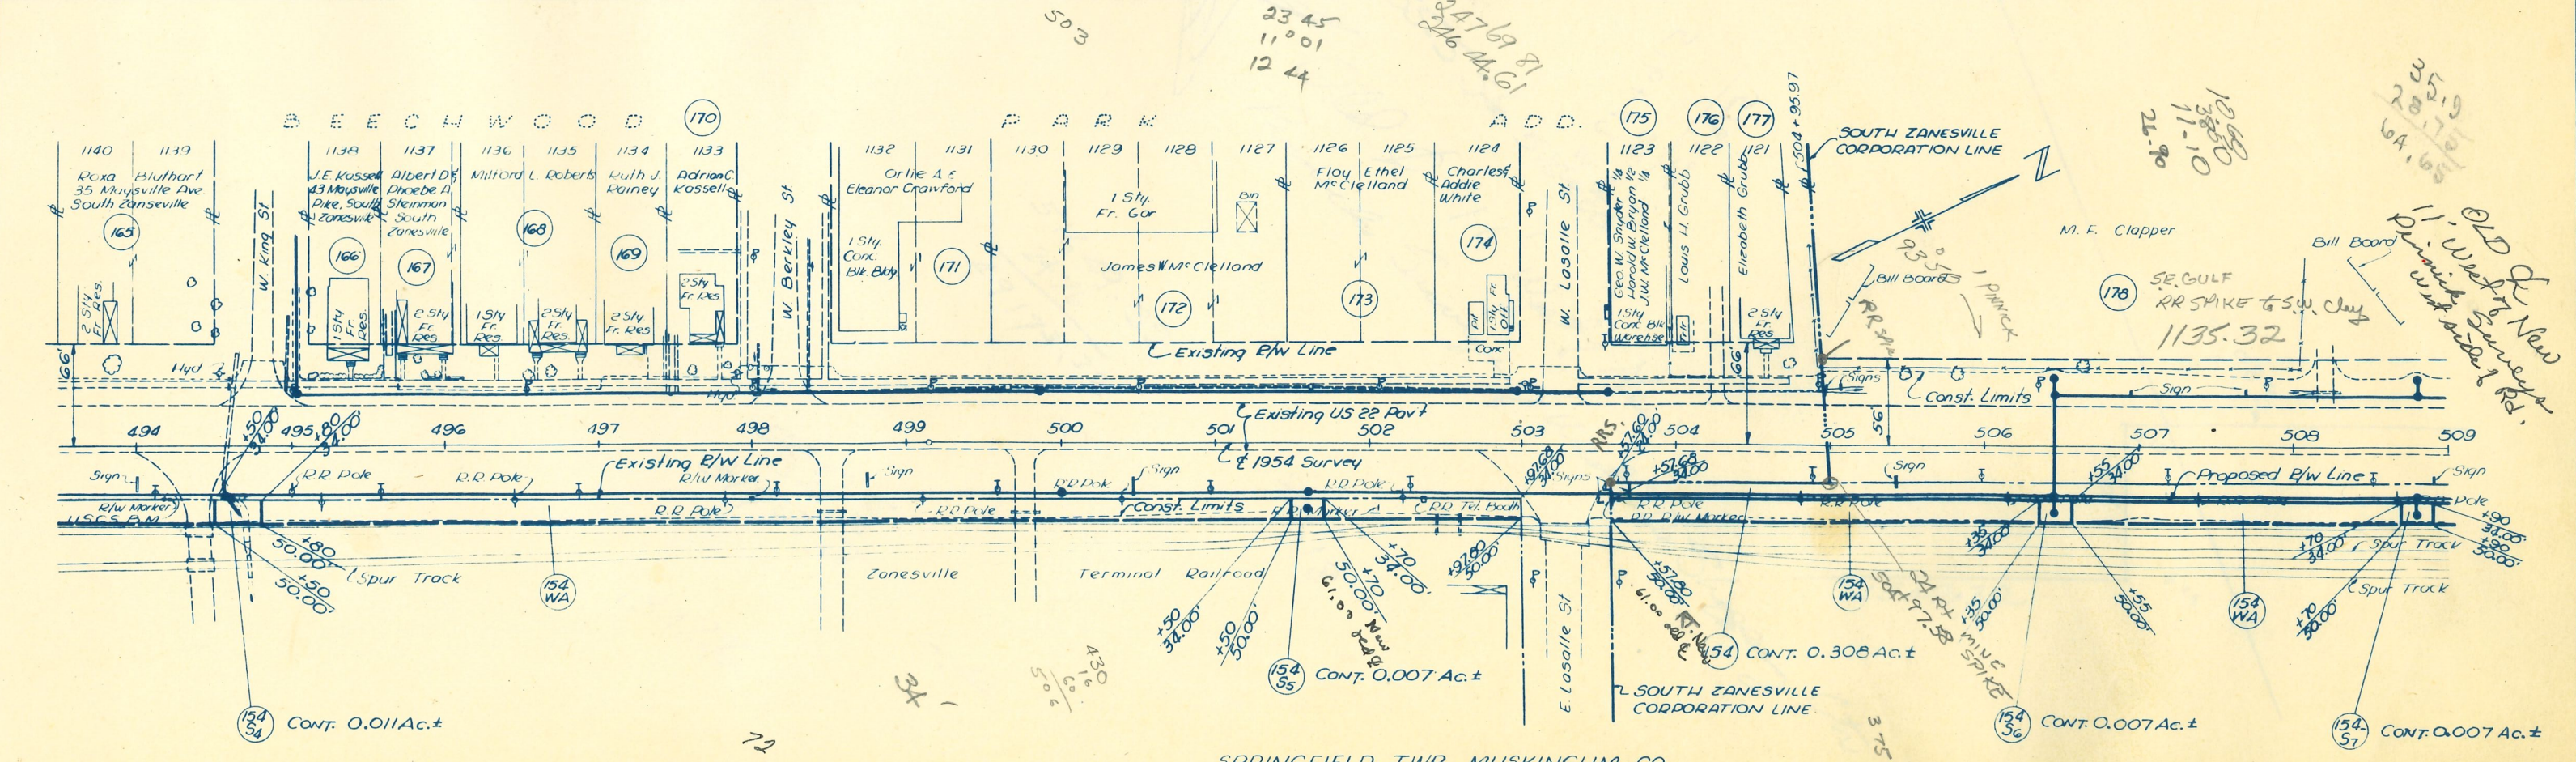

SPRINGFIELD TWP, MUSKINGUM CO.
SECT. 13, T. 16, R. 14

SANZENBACHER, MORRIS & TAYLOR - TOLEDO, OHIO
Rev. G-2-23

479 +00 - 509 +00

FED. RD. DIVISION	STATE	PROJECT	TYPE FUNDS
2	OHIO		


52
52

MUS. 22-(8.12-9.85)
R/W PLAN

PI. 516+18.00
Δ = 0°-05' RT.

End Project
Sta. 516+92.42

PI. 520+38.50
Δ = 0°-09' LT.

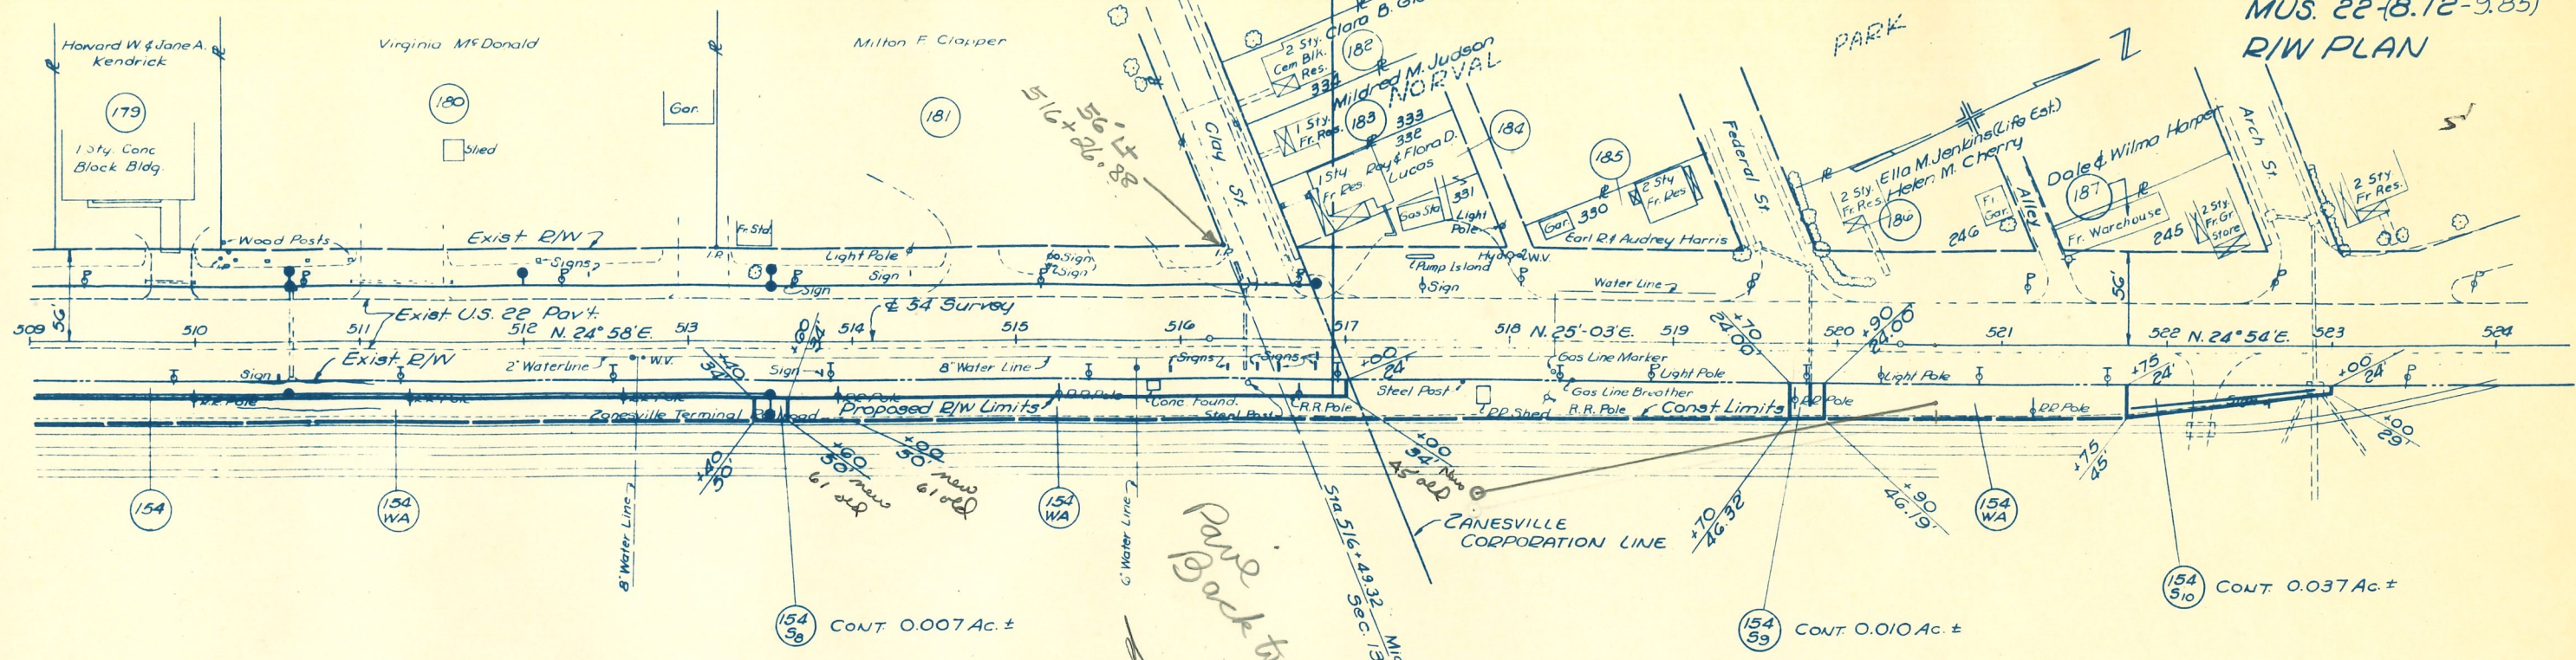

SPRINGFIELD TWP., MUSKINGUM CO.
SEC. 13 T. 16 R. 14






