


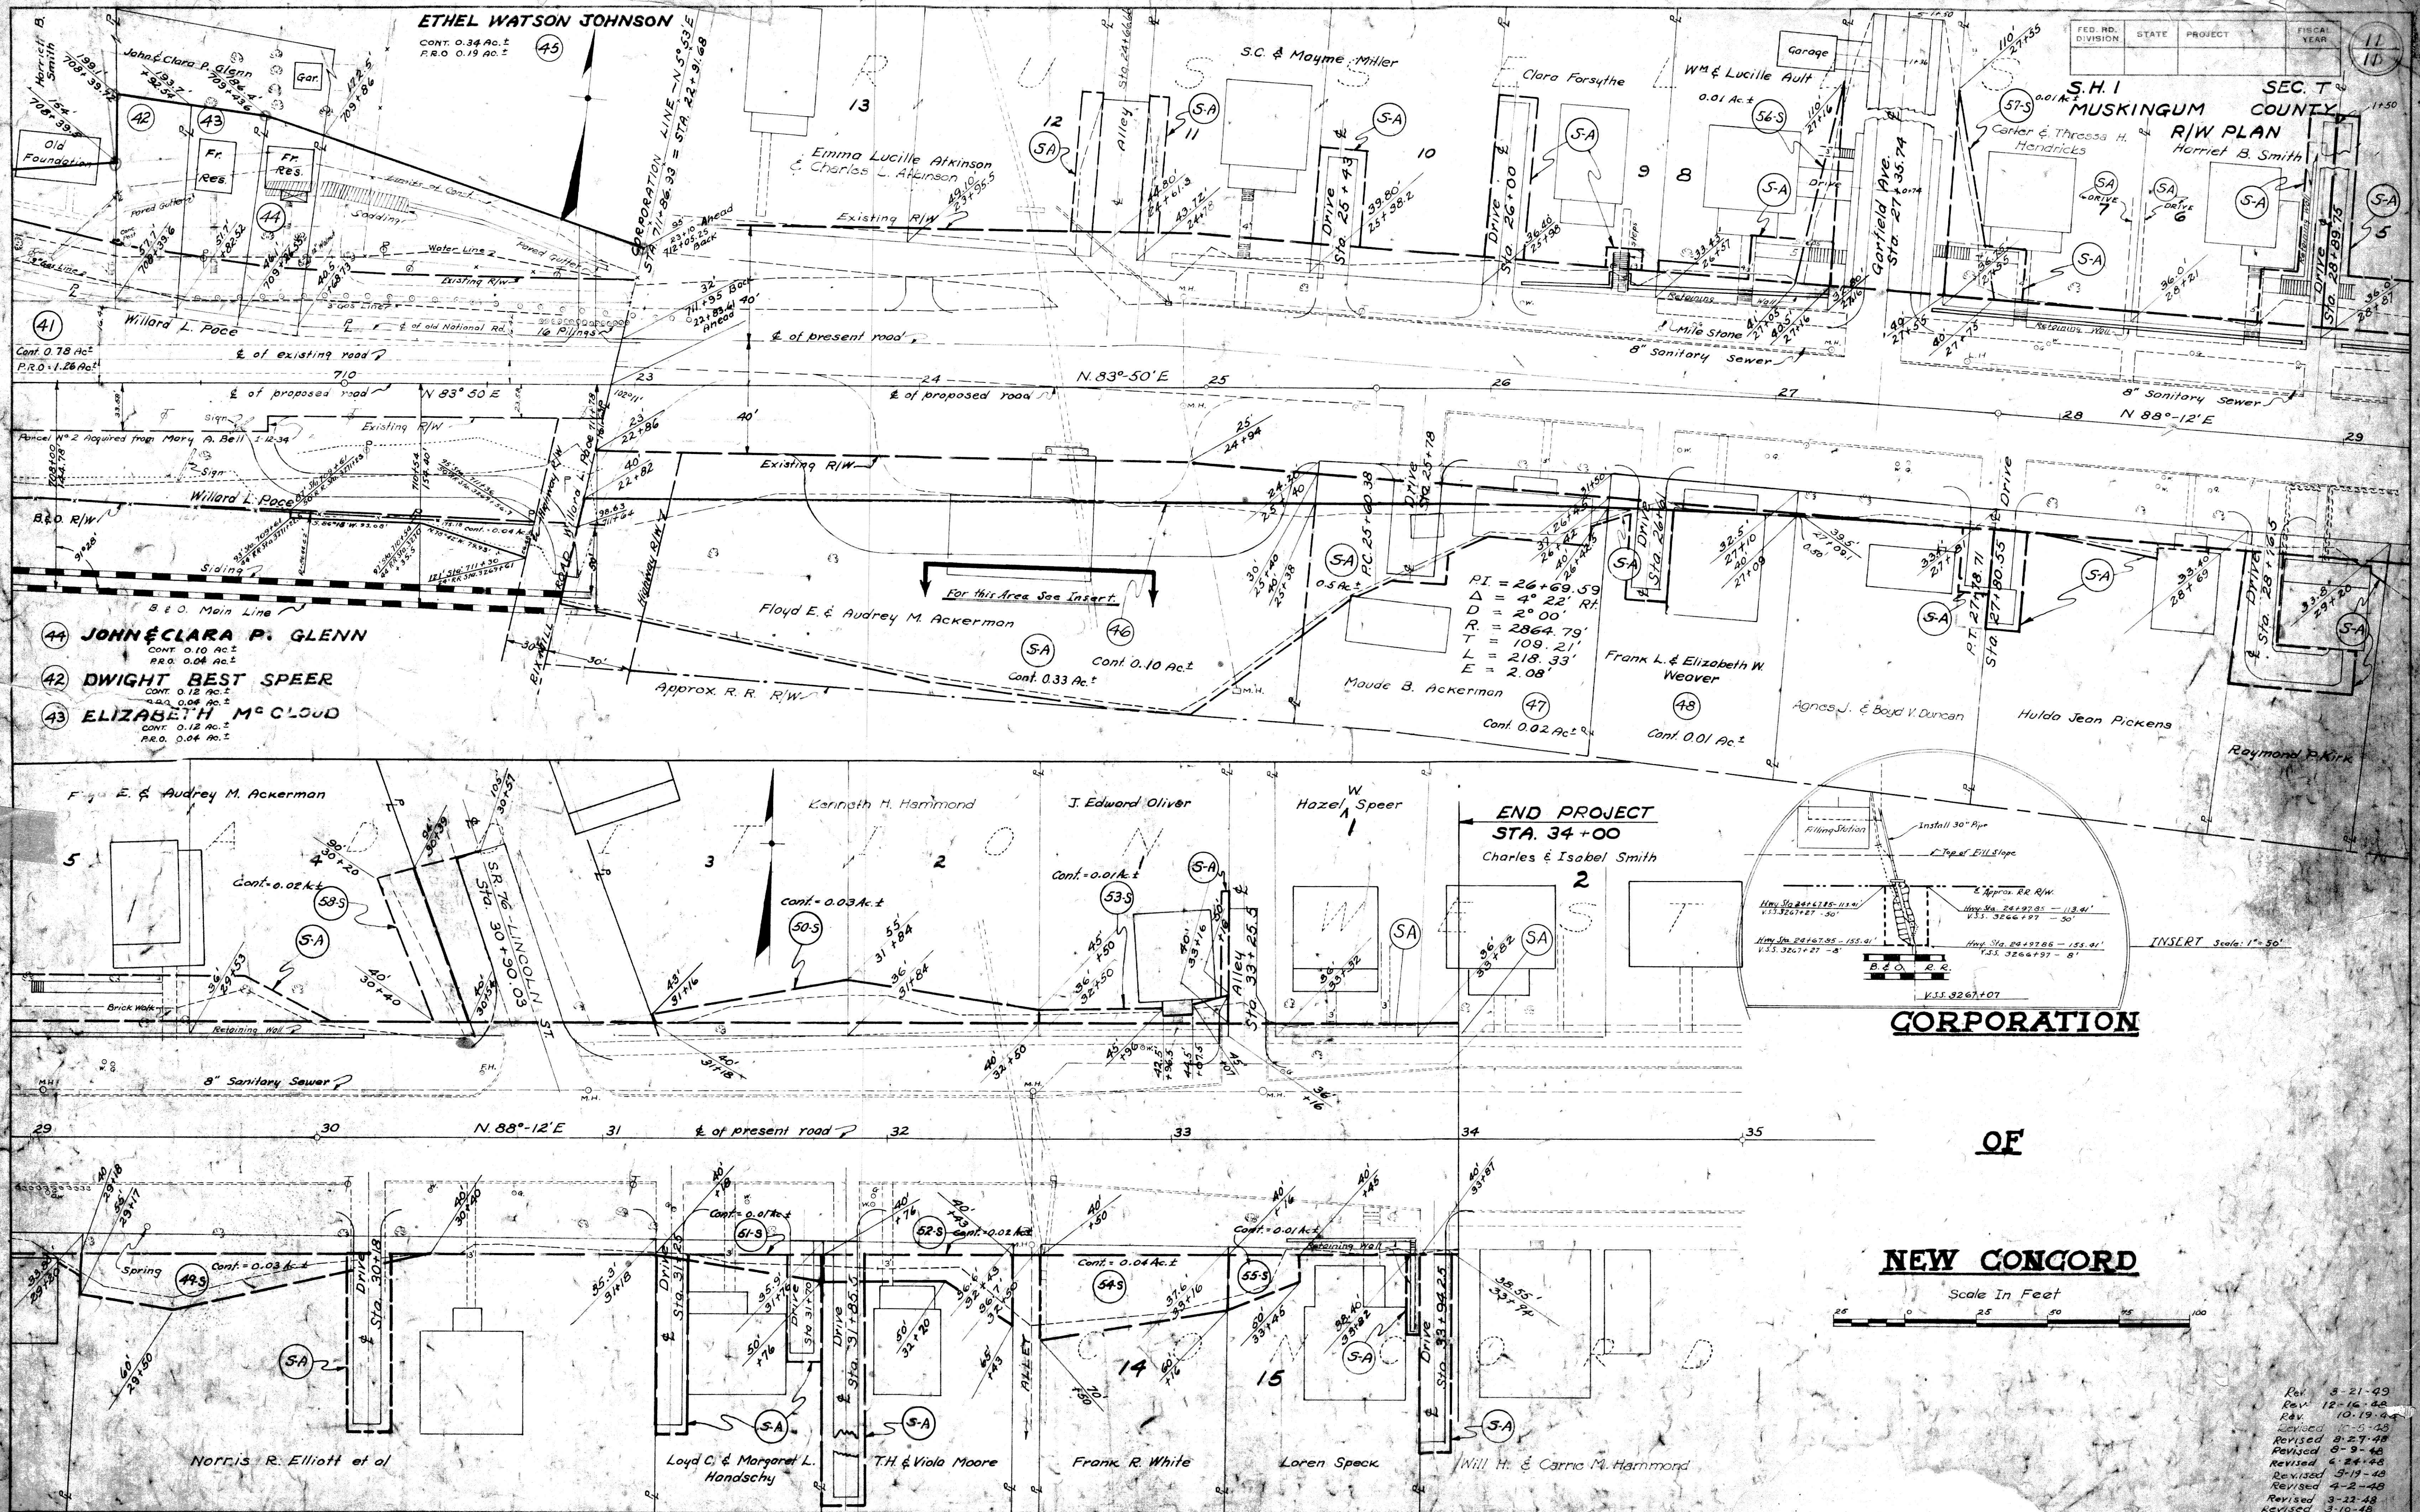

Rev. 8-21-49
Rev. 12-16-49
Rev. 10-19-49
Revised 10-5-48
Revised 8-27-48
Revised 6-9-48
Revised 6-24-48
Revised 5-19-48
Revised 4-2-48
Revised 3-22-48
Revised 3-10-48