FED. RD. DIVISION	STATE	PROJECT	FISCAL YEAR
2	OHIO		

4/11

S.H. I SEC. T
MUSKINGUM COUNTY
R/W PLAN

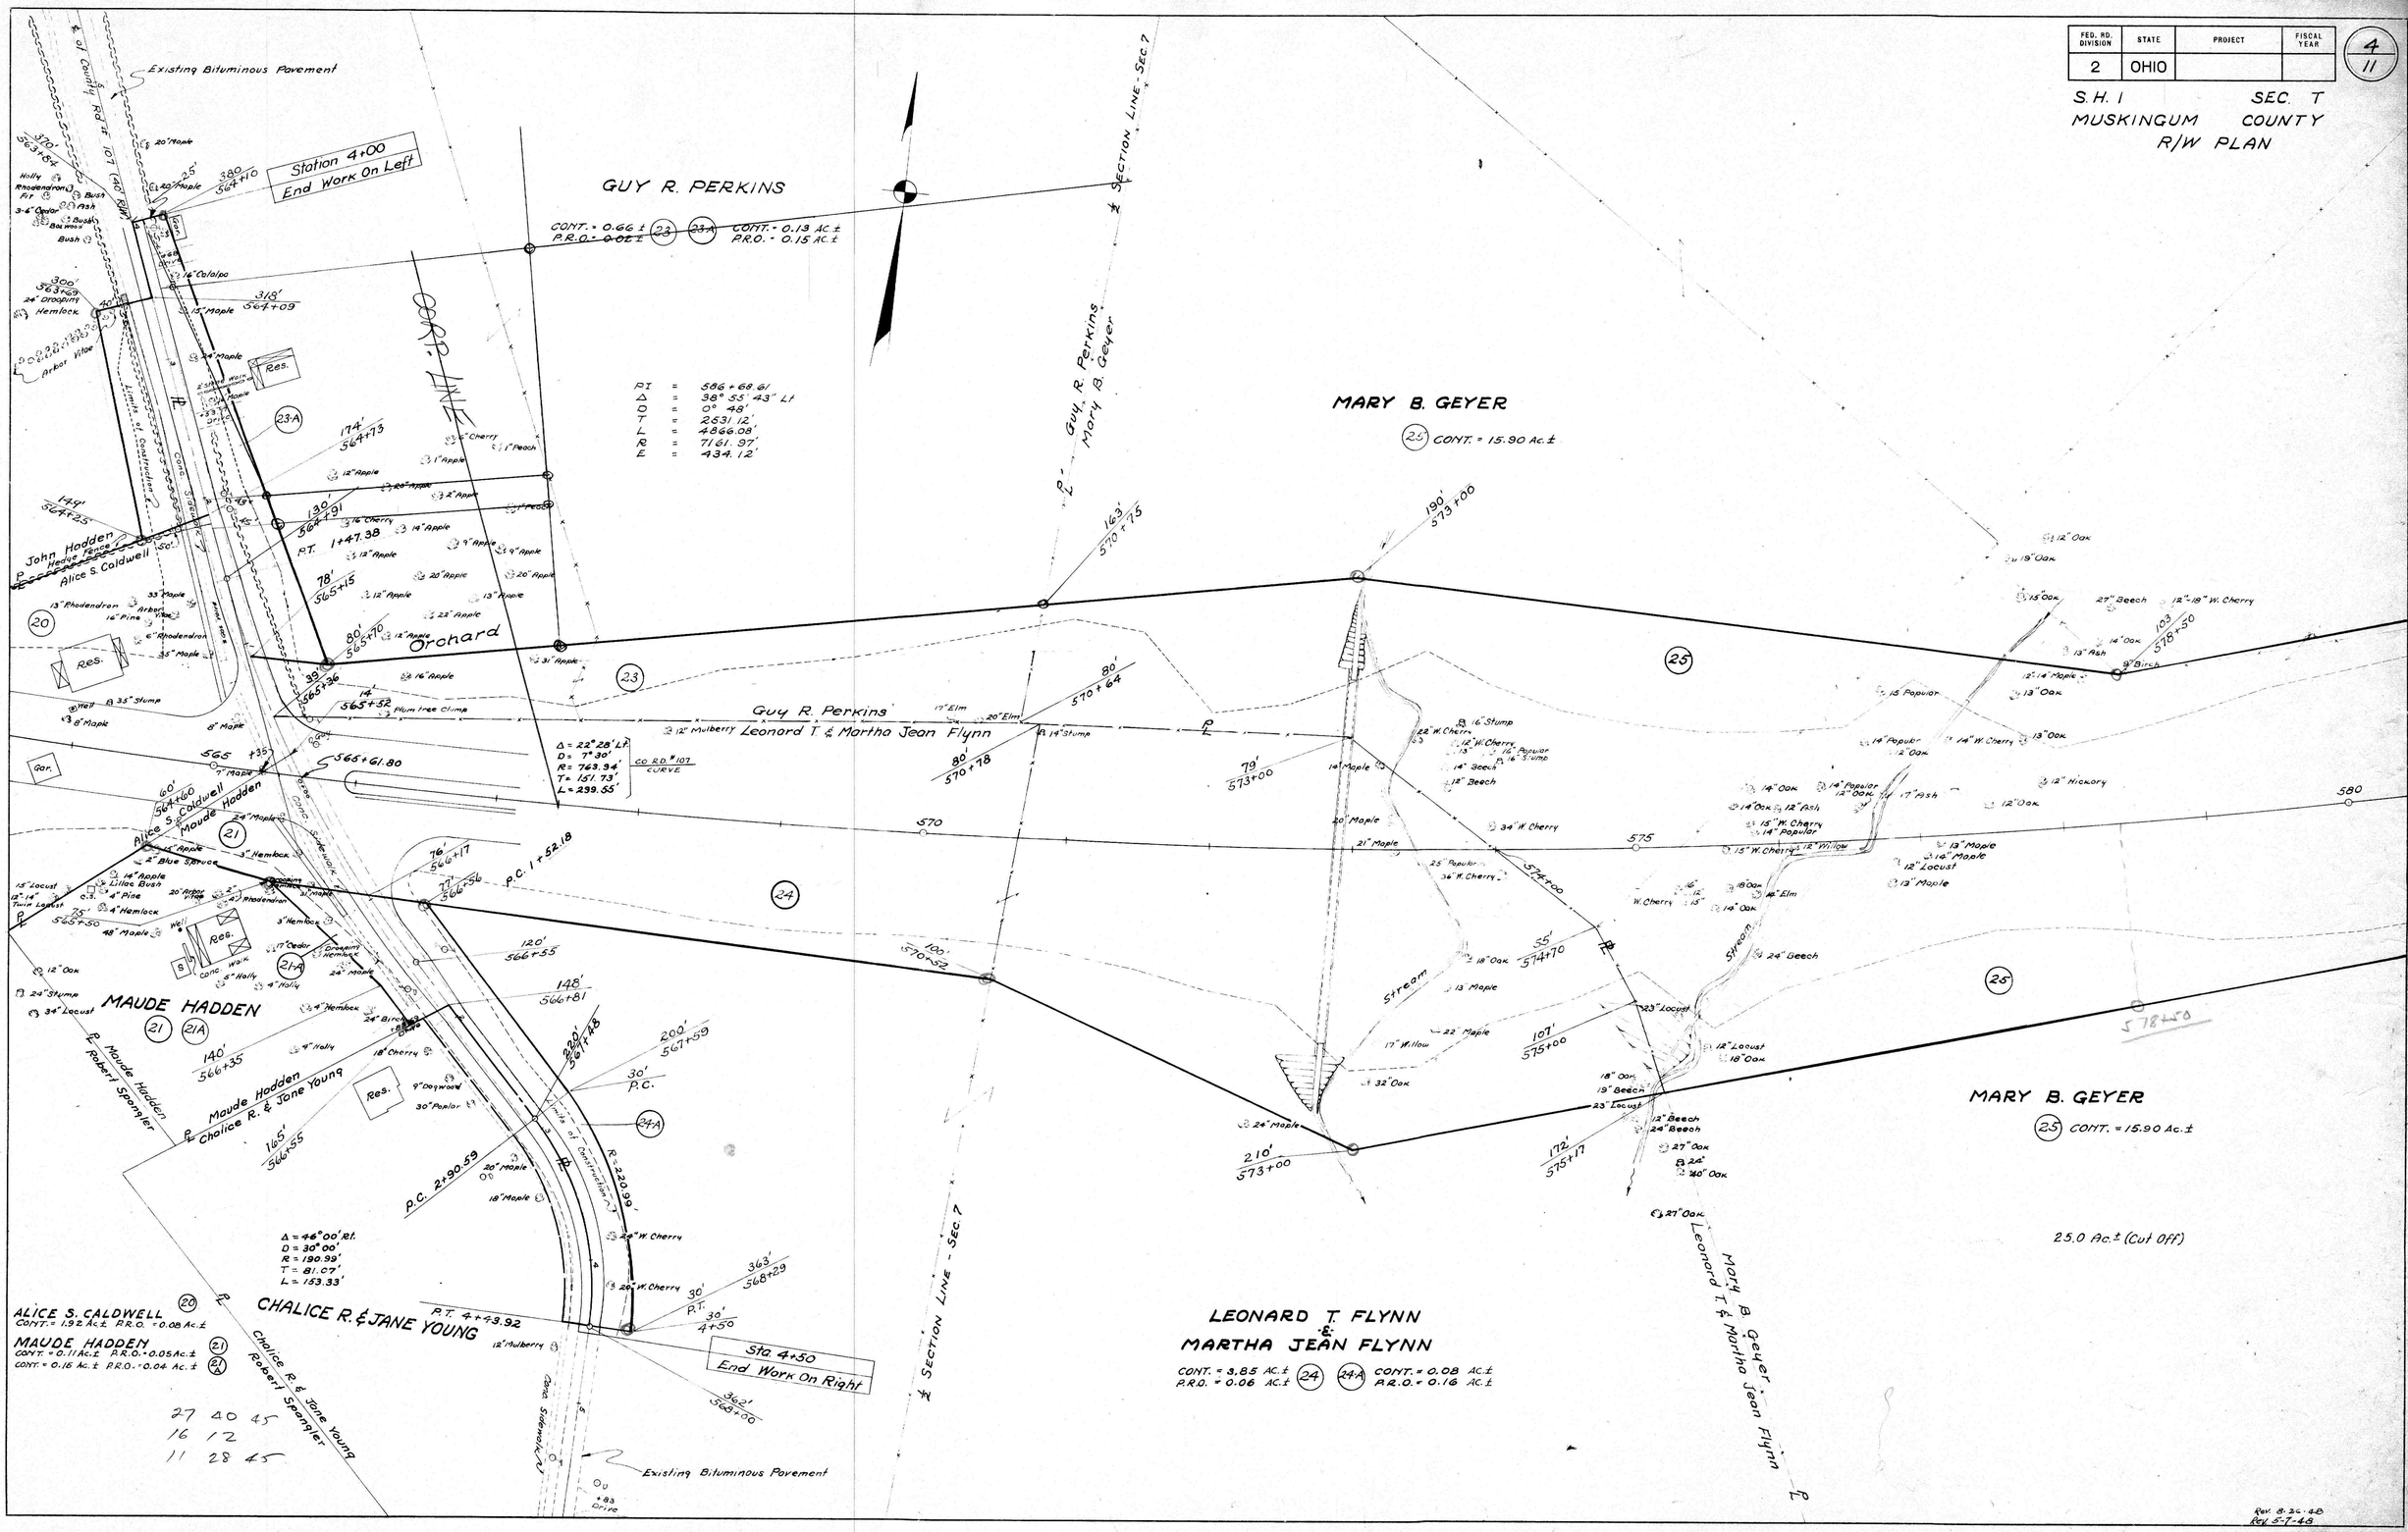

Rev. 8-26-48
Rev. 5-7-49

S.H. I SEC. T MUSKINGUM CO.
S.H. I SEC. T MUSKINGUM CO.