

FED. RD. DIVISION	STATE	PROJECT	FISCAL YEAR
2	OHIO		

6
11

S.H. 1 SEC. T
MUSKINGUM CO.
R/W PLAN

MARY B. GEYER

(25) CONT. = 15.90 AC ±

HARLEY WEST

CONT. = 14.44 ± (27) (27A) CONT. = 0.40 AC ±
P.R.O. = 0.13 ± P.R.O. = 0.20 AC ±

PI = 586 ± 68.61
Δ = 38° 55' 43" Lt
D = 0° 48'
T = 2531.12'
L = 4866.08'
R = 7161.97'
E = 434.12'

(3.77 AC ± Cut Off)


See Sheet A-A
This Rd

EASEMENT AREA 9.52 AC
Common Pleas CRT # 36175 (1945-1949)

HAROLD H. MASON

Cont. = 8.65 AC ± (26) (26A) 0.37 AC ±
P.R.O. = 0.42 AC ± (26B) 0.55 AC ±
(26C) 0.47 AC ±
P.R.O. = 0.16 AC ±

See sheet No. 4-A
For R/W detail

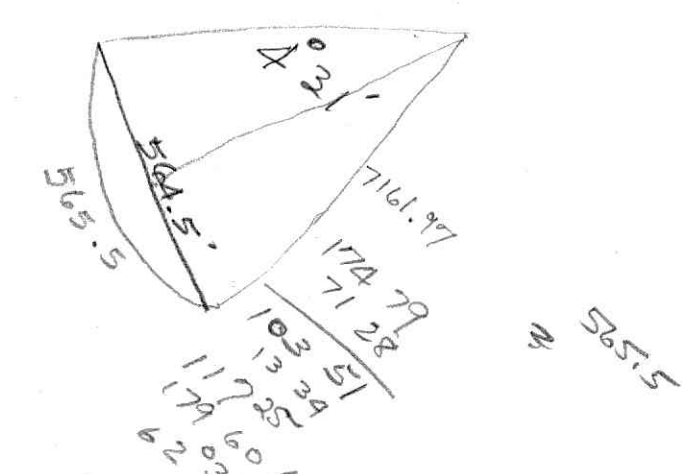

S.H. 1 SEC. T MUSKINGUM CO.

Rev. 8-27-48
Rev. 4-8-48
Rev. 4-2-48