


FED. RD. DIVISION	STATE	PROJECT	FISCAL YEAR
2	OHIO		

7
11

S.H. 1 SEC. T
MUSKINGUM CO.
R/W PLANS

HARLEY WEST

CONT. = 14.44 AC.±
P.R.O. = 0.13 (27) (27-A) CONT. = 0.40 AC.±
P.R.O. = 0.20 AC.±

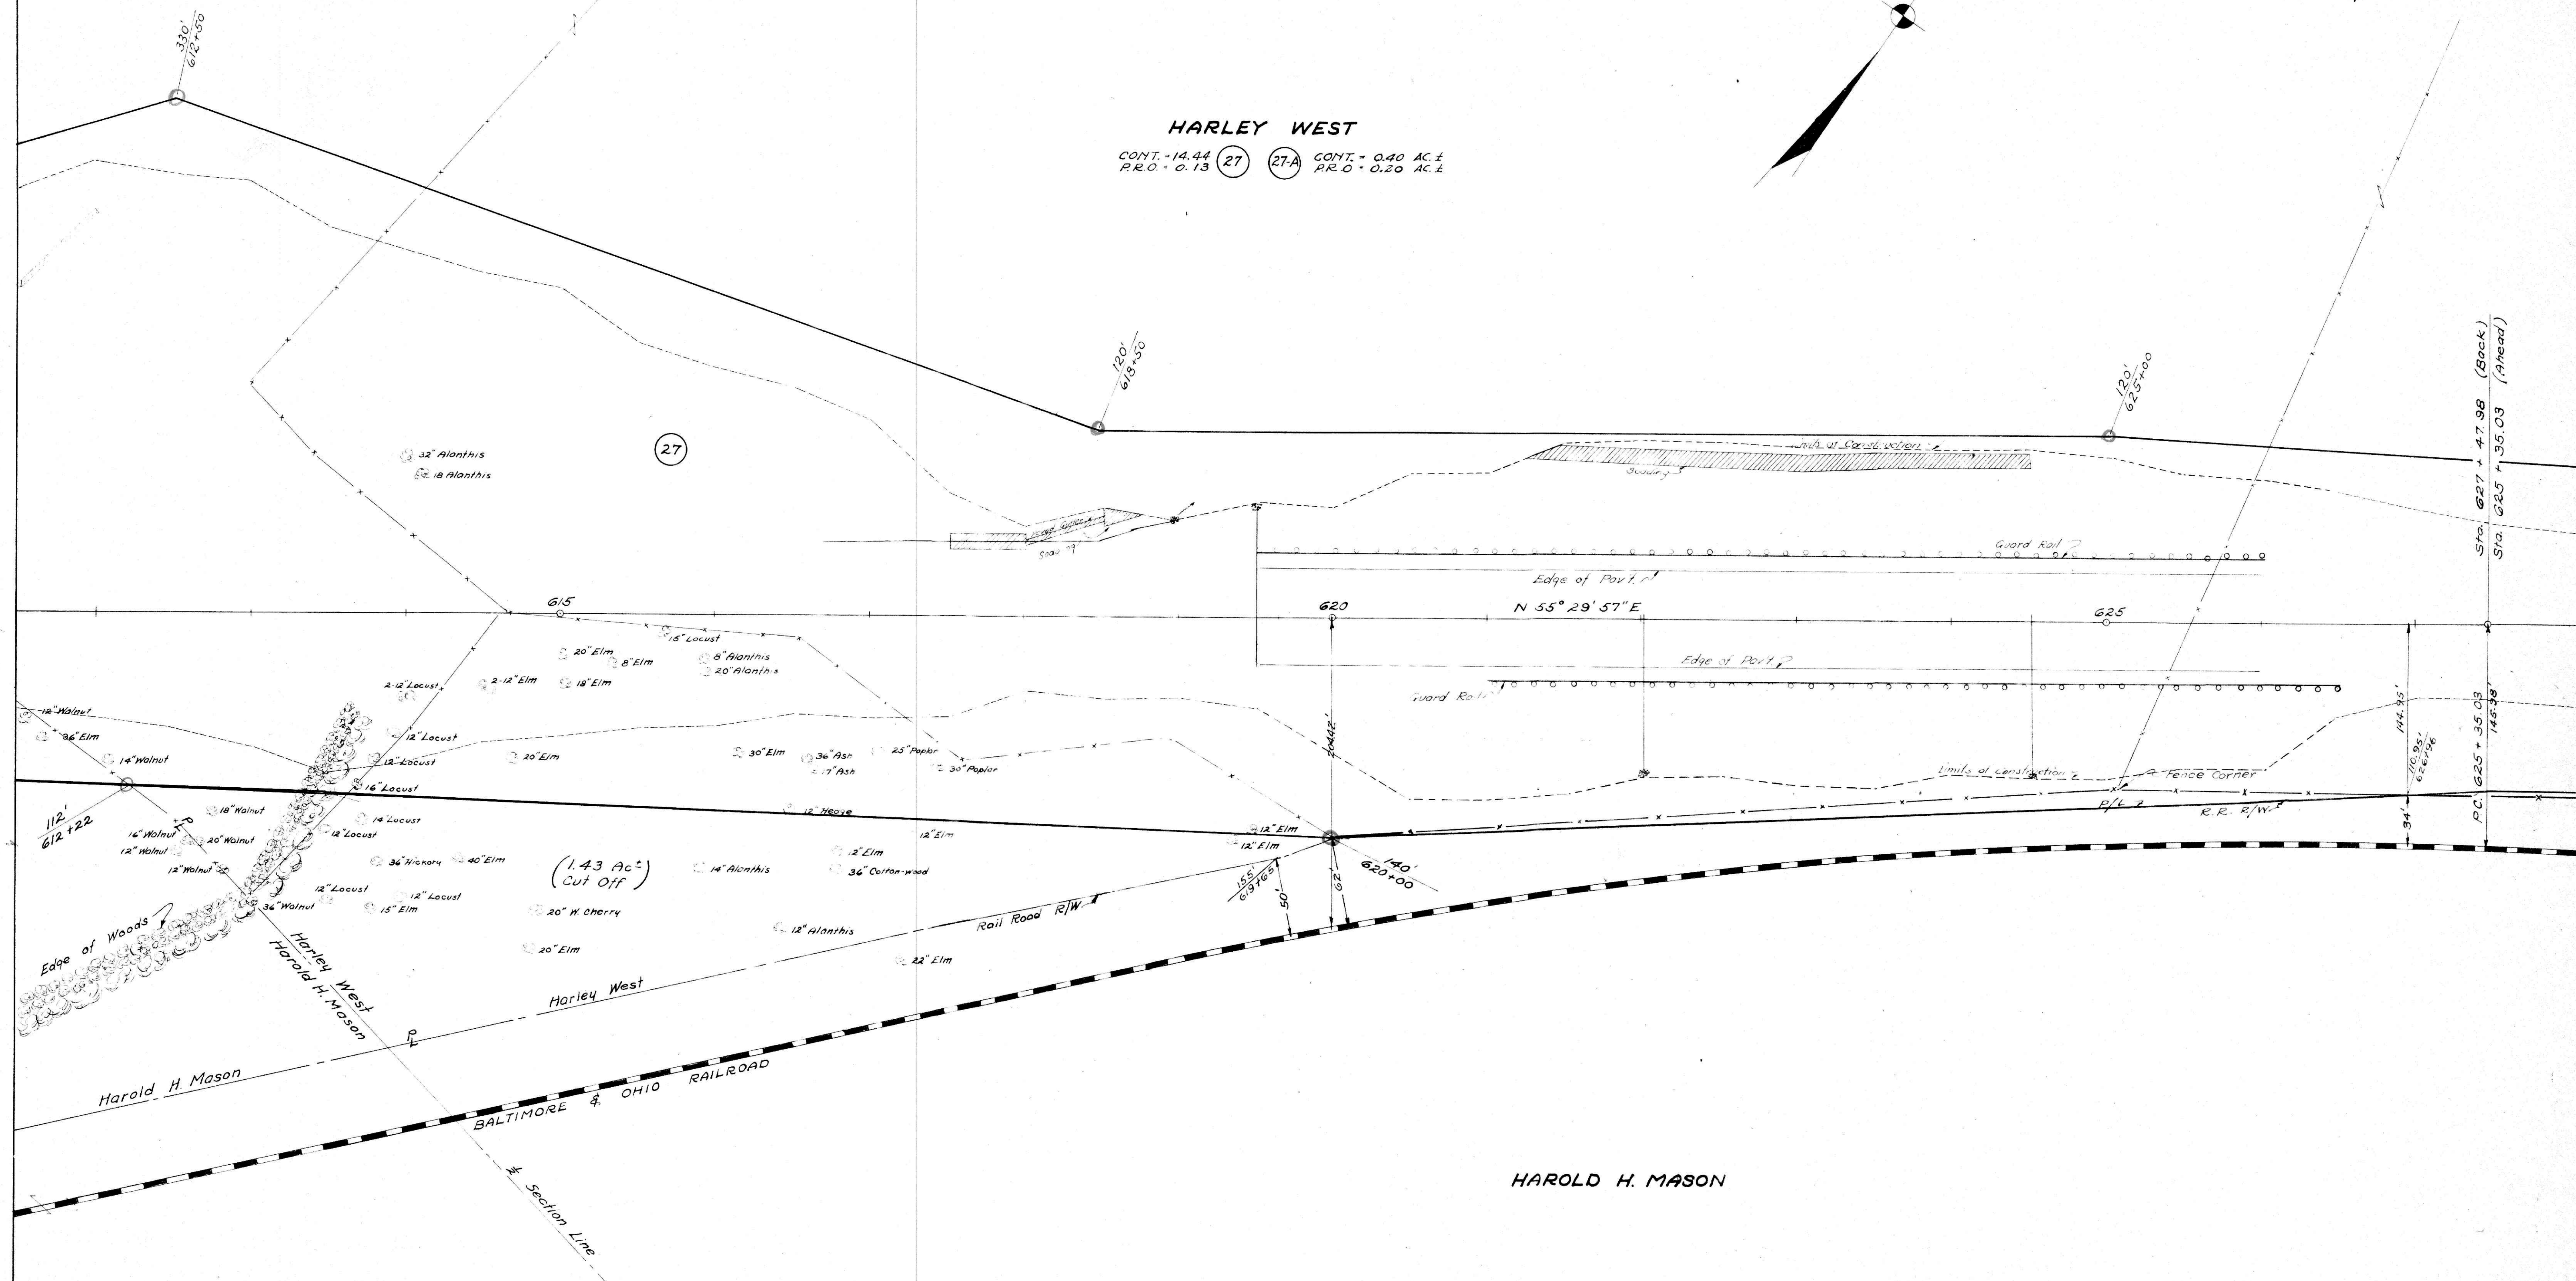

HAROLD H. MASON

Harold H. Mason
SEC. LINE - SEC. 8
Rev. 8-25-48
Rev. 8-9-48
Rev. 4-8-48

S.H. 1 - SEC. T - MUSKINGUM CO.
S.H. 1 - SEC. T - MUSKINGUM CO.