



P:\MUS\83024\DESIGN\RIGHT_OF_WAY\PLAN_SHEETS\MUS-666-5.71\83024_0002_RTS.dgn 03/12/13

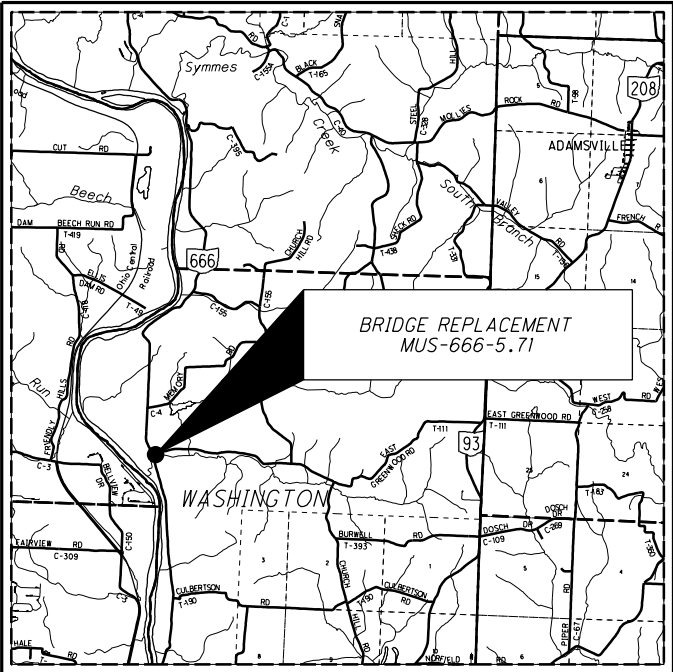

LOCATION MAP

LATITUDE: 39°57'31" N LONGITUDE: 82°00'36" W

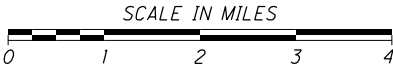

NOTE:
THE LOCATION OF THE UNDERGROUND UTILITES SHOWN ON THE PLANS ARE OBTAINED FROM THE OWNER OF THE UTILITIES AS REQUIRED BY SECTION 153.64 O.R.C.

UTILITY OWNERS

LISTED BELOW ARE ALL UTILITIES LOCATED WITHIN THE PROJECT CONSTRUCTION LIMITS TOGETHER WITH THEIR RESPECTIVE OWNERS:

AT&T OHIO 111 N. 4TH STREET ROOM 802 COLUMBUS, OHIO 43215 ATTN: DAVE BUEHNER 614-223-4392	NATIONAL GAS AND OIL CORP. 1500 GRANVILLE ROAD P.O. BOX 4970 NEWARK, OHIO 43058 ATTN: GREG WILSON 740-348-1254	GUERNSEY MUSKINGUM ELECTRIC COOPERATIVE, INC. 17 SOUTH LIBERTY STREET NEW CONCORD, OHIO 43762 ATTN: JOHN MARSHALL 740-826-7661
TIME WARNER CABLE 3760 INTERCHANGE DRIVE COLUMBUS, OHIO 43204 ATTN: RAY MAURER 614-481-5262		

CONVENTIONAL SYMBOLS

County Line	Ditch / Creek (Ex)
Township Line	Ditch / Creek (Pr)
Section Line	Tree Line (Ex)
Corporation Line	Ownership Hook Symbol  , Example 
Fence Line (Ex) — x — x — (Pr) — x — x —	Property Line Symbol  , Example 
Center Line	Break Line Symbol  , Example 
Right of Way (Ex) — Ex R/W —	Tree (Pr)  , Tree (Ex)  , Shrub (Ex) 
Right of Way (Pr) — R/W —	Tree (Remove)  , Shrub (Remove) 
Standard Highway Ease.(Ex) — Ex SH —	Evergreen (Ex)  , Stump 
Temporary Right of Way — TMP —	Evergreen (Remove)  , Stump (Remove) 
Channel Ease. (Pr) — CH —	Wetland (Pr)  , Grass (Pr)  , Aerial Target 
Utility Ease. (Ex) — Ex U —	Post (Ex)  , Mailbox (Ex)  , Mailbox (Pr) 
Railroad ————— or —————	Light (Ex)  , Telephone Marker (Ex) TEL
Guardrail (Ex)  (Pr) 	Fire Hydrant (Ex)  , Water Meter (Ex) 
Construction Limits —	Water Valve (Ex)  , Utility Valve Unknown (Ex.) 
Edge of Pavement (Ex) —————	Telephone Pole (Ex) , Power Pole (Ex)
Edge of Pavement (Pr) —————	Light Pole (Ex)
Edge of Shoulder (Ex) —————	
Edge of Shoulder (Pr) —————	

STRUCTURE KEY

	RESIDENTIAL
	COMMERCIAL
	OUT-BUILDING

STATE OF OHIO
DEPARTMENT OF TRANSPORTATION
**RIGHT OF WAY
LEGEND SHEET
MUS-666-5.71**
PART II
QTR. TWP. 3, T2N, R7W
PART OF JACKSON' LAND P.B.M, PG. 384
WASHINGTON TOWNSHIP
MUSKINGUM COUNTY
(FOR PART 1 SEE MUS-666-2.76)

INDEX OF SHEETS:

CENTERLINE PLAT	2
PROPERTY MAP	3
SUMMARY OF ADDITIONAL RIGHT OF WAY.	4
DETAIL SHEETS	5-6

LEGEND:

WL = FEE SIMPLE WITH LIMITATION OF ACCESS
WD = WARRANTY DEED
SH = STANDARD HIGHWAY EASEMENT
LA = LIMITED ACCESS EASEMENT
T = TEMPORARY EASEMENT
CH = CHANNEL EASEMENT

PROJECT DESCRIPTION

REMOVAL OF EXISTING SINGLE SPAN BRIDGE AND REPLACE WITH THREE SPAN CONTINUOUS SLAB BRIDGE. PAVEMENT VERTICAL RE-ALIGNMENT AND SUPERELEVATION CORRECTION WITH ASSOCIATED WORK. PAVEMENT VERTICAL AND HORIZONTAL RE-ALIGNMENT OF GILBERT ROAD.

PROJECT CONTROL

NORTH AMERICAN VERTICAL DATUM (NAVD 88)
AND STATE PLANE GRID COORDINATES, SOUTH ZONE.

PLAN PREPARED BY:

FIRM NAME: ODOT, DISTRICT 5
PLANS PREPARED BY: CANDY SHOEMAKER
FIELD REVIEW BY: CHUCK PRICE & CANDY SHOEMAKER
OWNERSHIP VERIFIED BY: CHARLES PRICE, JR.
DATE COMPLETED: 06/04/12

UNDERGROUND UTILITIES

CONTACT BOTH SERVICES
CALL TWO WORKING DAYS
BEFORE YOU DIG

CALL
1-800-362-2764
(TOLL FREE)

OHIO UTILITIES PROTECTION SERVICE
NON-MEMBERS
MUST BE CALLED DIRECTLY

OIL & GAS PRODUCERS PROTECTIVE
SERVICE CALL: 1-800-925-0988

I, Charles W. Price, Jr., P. S. have conducted a survey of the existing conditions for the Ohio Department of Transportation in April, 2012. The results of that survey are contained herein.

Underground utility locations are shown for informational purposes only. Though they are believed to be accurate, their location is as marked on the ground by the utility company per OUPS Confirmation Number A12770268 and those markings subsequently being surveyed as a part of this project.

The horizontal coordinates expressed herein are based on the Ohio State Plane Coordinates system, NAVD 88, South Zone.

As a part of this project I have reestablished the locations of the existing property lines and centerline of existing Right of Way for property takes contained herein.

As a part of this project I have established the proposed property lines, calculated the Gross Take, present roadway occupied (PRO), Net Take and Net Residue; as well as prepared the legal descriptions necessary to acquire the parcels as shown herein.

As a part of this work I have set monuments at the proposed property corners, and other points shown herein. The iron pins and caps will be 3/4" x 30" rebar with aluminum cap stamped "Odor R/W District 5". All of my work contained herein was conducted in accordance with Ohio Administrative Code 4733-37 commonly known as "A Minimum Standards for Boundary Surveys in the State of Ohio" unless so noted.


The words I and my as used herein are to mean that either myself or someone working under my direct supervision.


Charles W. Price, Jr., Professional Land Surveyor # 7825

Date: 06/04/12

SURVEYORS SEAL

STATE OF OHIO
CHARLES W. PRICE, JR.
S-7825
REGISTERED
SURVEYOR

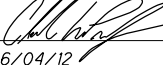SIGNED: 
DATE: 06/04/12

FEDERAL PROJECT NO.

PID NO.

RAILROAD INVOLVEMENT

RIGHT OF WAY
LEGEND SHEET

MUS-666-5.71

1 / 6

59
64



Doc ID: 006186060001 Type: PLA
Kind: PLATS
Recorded: 06/10/2019 at 02:57:23 PM
Fee Amt: \$40.00 Page 1 of 1
Instr# 201900005168
Muskingum County
CINDY RODGERS County Recorder

MONUMENT TABLE

E OF PROP. R/W S.R. 666		PROJECT COORDINATES SEE SURVEY CERTIFICATION		MONUMENTS TO BE SET DURING CONSTRUCTION	R/W MON. EXPECTED TO BE DISTURBED	DESCRIPTION
STATION	OFFSET	NORTHING (Y)	EASTING (X)	MON. ASSEMBLY 604E 38501	R/W MON. 604E 40520	
PT STA. 299+39.67	30' LT.	736,729.9089	2,115,074.7341	I		
PT STA. 299+39.67	30' RT.	736,712.6587	2,115,132.2009	I		
STA. 300+37.58	30.00' RT.	736,806.4306	2,115,160.3491		I	IRON PIN SET INSIDE CONSTRUCTION LIMITS
PC STA. 300+98.36	35' RT.	736,863.2068	2,115,182.6124	I		
STA. 302+62.09	70' RT.	737,066.9738	2,115,189.7601		I	IRON PIN SET INSIDE CONSTRUCTION LIMITS
PT STA. 303+84.35	30' LT.	737,083.4305	2,115,027.4083	I		
PT STA. 303+84.35	40' RT.	737,147.4916	2,115,055.6249	I		
PC STA. 304+94.39	30' LT.	737,127.5656	2,114,927.2068	I		
SUBTOTAL CARRIED TO SHEET 2				6	2	

QTR. TWP. 3, R7W, T2N,
PART OF JACKSON'S LAND, P.B. M, PG. 384
WASHINGTON TOWNSHIP
MUSKINGUM COUNTY

BK 20 PG 152

THE PROPOSED RIGHT OF WAY SHALL BE REFERENCED FROM THE CENTERLINE OF RIGHT OF WAY.

PLACEMENT OF ALL MONUMENTS SHALL BE UNDER THE DIRECTION OF A SURVEYOR REGISTERED IN THE STATE OF OHIO. THE CENTERLINE MONUMENT ASSEMBLY BOX(S) AND REFERENCE MONUMENTS WILL BE INSTALLED BY THE HIGHWAY CONTRACTOR AT THE TIME OF CONSTRUCTION.

THE IRON PIN WITH CAP (WHEN REQUIRED) ARE TO BE INSTALLED SET BY THE CONTRACTOR'S SURVEYOR.

CHANGES OR ALTERATIONS TO THE LOCATION OF ANY MONUMENTS SHOWN ON THIS PLAT, REQUIRES PRIOR APPROVAL OF THE DISTRICT REAL ESTATE ADMINISTRATOR OF THE OHIO DEPARTMENT OF TRANSPORTATION. A REVISED CENTERLINE PLAT WITH THE NEW LOCATIONS SHALL BE RECORDED IN THE APPLICABLE COUNTY RECORDS AND THE OHIO DEPARTMENT OF TRANSPORTATION. SPECIFICATIONS FOR CENTERLINE MONUMENTS, REFERENCE MONUMENTS AND RIGHT OF WAY MONUMENTS ARE SHOWN ON STANDARD CONSTRUCTION DRAWING RM-1.1 OF THE OHIO DEPARTMENT OF TRANSPORTATION.

BASIS FOR BEARINGS:

ALL BEARINGS SHOWN ARE BASED ON THE OHIO STATE PLANE COORDINATES SYSTEM, SOUTH ZONE.

NOTE: THE EXISTING R/W WIDTH AND LOCATION WERE DETERMINED USING DOCUMENTATION ON FILE FROM THE OHIO DEPARTMENT OF TRANSPORTATION, DISTRICT 5 OFFICE, JACKSONTOWN, OHIO.

I, Charles W. Price, Jr., P. S. have conducted a survey of the existing conditions for the Ohio Department of Transportation in July, 2011. The results of that survey are contained herein.

The horizontal coordinates expressed herein are based on the Ohio State Plane Coordinates system, NAD 83, South Zone.

As a part of this project I have reestablished the locations of the existing property lines and centerline of existing Right of Way for property takes contained herein.

As a part of this project I have established the proposed property lines, calculated the Gross Take, present roadway occupied (PRO), Net Take and Net Residue; as well as prepared the legal descriptions necessary to acquire the parcels as shown herein.

As a part of this work I have set monuments at the proposed property corners, and other points shown herein.


The iron pins and caps will be 3/4" x 30" rebar with aluminum cap stamped "Odor R/W District 5". All of my work contained herein was conducted in accordance with Ohio Administrative Code 4733-37 commonly known as "A Minimum Standards for Boundary Surveys in the State of Ohio" unless so noted.

The words I and my as used herein are to mean that either myself or someone working under my direct supervision.


Charles W. Price, Jr., Professional Land Surveyor # 7825

Date: 06/04/12

RECEIVED June 10, 2019
RECORDED June 10, 2019
PLAT BOOK 20 PAGE 152
COUNTY RECORDER

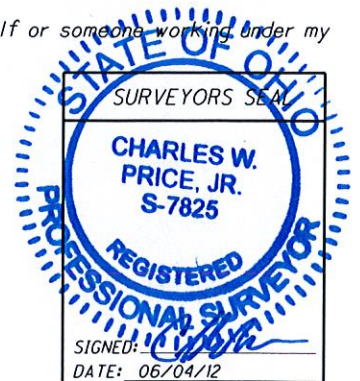

5/8" IRON PIN W/CAP FOUND
AT THE NORTHWEST CORNER OF LOT 12,
JACKSON'S LAND P.B. M, PG. 384
BASED ON A 0.7963 AC. SURVEY IN
MAY, 1995 BY STEVEN B. WALTON, S-7675

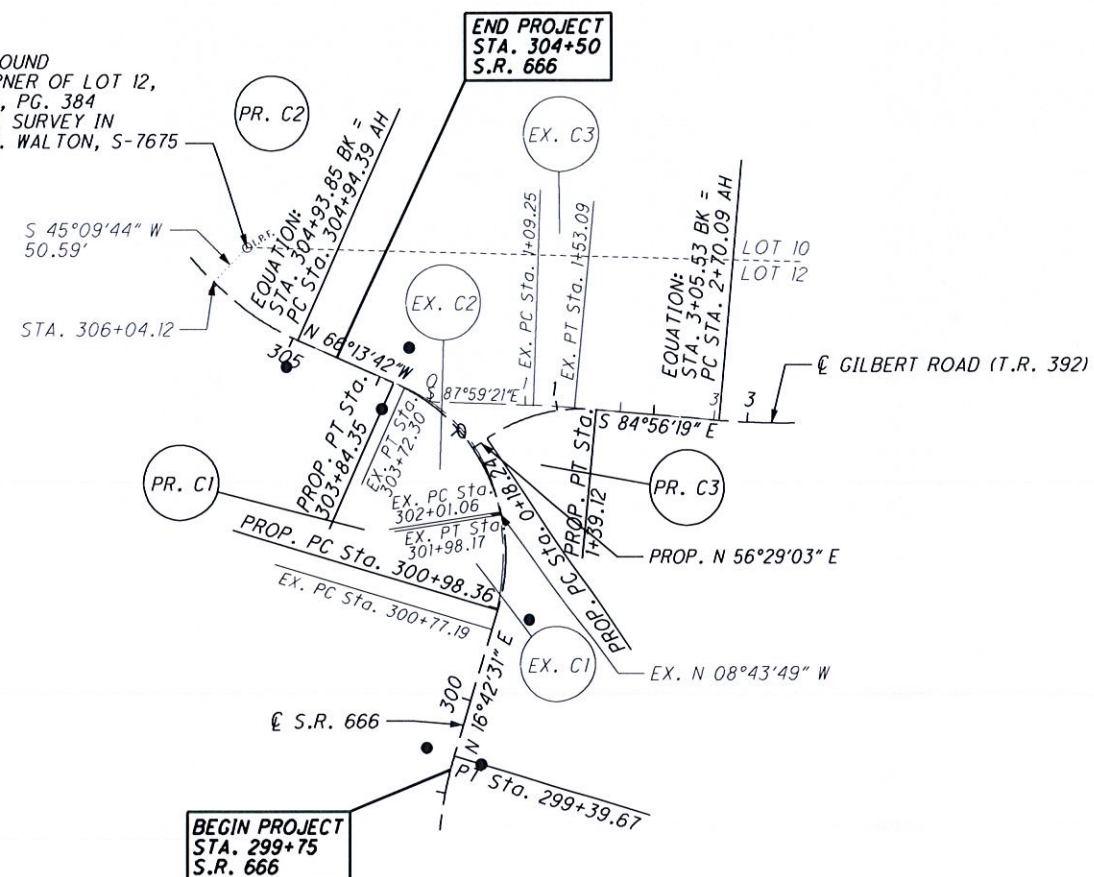

TRANSFER
NOT NECESSARY

JUN 10 2019

Auditor, Muskingum County, Ohio

MONUMENT LEGEND

- EXISTING R/W MONUMENT BOX
- PROPOSED R/W MONUMENT BOX
- EXISTING CONCRETE MONUMENT
- PROPOSED CONCRETE MONUMENT
- RAILROAD SPIKE FOUND
- RAILROAD SPIKE SET
- IRON PIN FOUND
- IRON PIN FOUND W/ ID CAP
- IRON PIN SET W/ ID CAP
- IRON PIPE FOUND
- IRON PIPE SET
- P.K. NAIL FOUND
- P.K. NAIL SET

EX. S.R. 666 CURVE 1
P.I. STA. 301+38.69
D = 25°26'19" LT.
Dc = 21°01'39"
R = 272.48'
T = 61.50'
L = 120.98'
E = 6.85'


EX. S.R. 666 CURVE 2
P.I. STA. 302+94.67
D = 57°29'53" LT.
Dc = 33°34'39"
R = 170.34'
T = 93.61'
L = 171.24'
E = 23.99'

EX. GILBERT ROAD (T.R. 392) CURVE 1
P.I. STA. 1+31.17
D = 03°03'02" RT.
Dc = 06°57'30"
R = 823.41'
T = 21.93'
L = 43.84'
E = 0.29'

PROP. S.R. 666 CURVE 1
P.I. STA. 302+72.97
D = 82°56'12" LT.
Dc = 29°00'00"
R = 197.57'
T = 174.60'
L = 285.99'
E = 66.10'

PROP. S.R. 666 CURVE 2
P.I. STA. 305+77.36
D = 31°31'40" RT.
Dc = 19°29'37"
R = 293.92'
T = 82.97'
L = 161.73'
E = 11.49'

PROP. GILBERT ROAD (T.R. 392) CURVE 1
P.I. STA. 0+81.21
D = 39°34'38" RT.
Dc = 32°44'26"
R = 175.00'
T = 62.96'
L = 120.88'
E = 10.98'

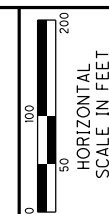

PID NO.
83024

CS
R/W REVIEW
JG

PROPERTY MAP

MUS-666-5.71

P:\MUS\83024\DESIGN\RIGHT_OF_WAY\PLAN_SHEETS\MUS-666-5.71\83024_0002_RPM.dgn

STANLEY &
SANDRA J. HITTL
70-01-02-10-000
NO TAKE

END RW ACQUISITION
STA. 304+70
S.R. 666

END RW ACQUISITION
STA. 1+80
GILBERT ROAD

STANLEY L. & SANDRA J. HITTLE
70-01-01-08-001
NO TAKE

~~PATRICIA M. SNUGG~~
~~70-01-01-05-000~~

EX. C GILBERT ROAD
(T.R. 392)

DONALD MCPHERSON
61-70-01-01-06-000

(14)
ROBERT MESSER

LOT 10

LOT 12
JACKSON'S LAND
PLAT BOOK M, PG. 384

ROBERT MESSER
70-01-01-07-000

~~NO TAKE~~
~~Ex SH~~

Ex SH

OP. © GILBERT RO

11
STANLEY LYONS
70-01-03-02-000

BOARD OF PARK
COMMISSIONERS MUSKINGUM
COUNTY PARK DISTRICT
70-01-02-17-000
NO TAKE

STANLEY LYONS
70-01-03-02-000

— C SURVEY & CONSTRUCTION,
S.R. 666

BEGIN RW ACQUISITION
STA. 299+00
S.R. 666

(10)
GLORIA A. & JAMES N. SMITH
70-01-03-03-000

STATE OF OHIO DEPARTMENT
OF NATURAL RESOURCES
70-01-03-04-000
NO TAKE

(10)
GLORIA A. &
JAMES N. SMITH
70-01-03-03-000

STRUCTURE KEY

-  RESIDENTIAL
 COMMERCIAL
 OUT-BUILDING

CS	12/20/12	REVISED PARCEL 12-SH AT OWNER'S REQUEST
REV. BY	DATE	DESCRIPTION
FIELD REVIEW BY: CS & CP		
OWNERSHIP VERIFIED BY: CP		
DATE COMPLETED: 06/04/12		

3	/	6
---	---	---



[illegible]

*DENOTES RIGHT OF WAY ENCROACHMENT

MUS-666-5.71	SUMMARY OF ADDITIONAL	R.W. DESIGNER	STATE JOB NO.	PID NO.	FEDERAL PROJECT NO.
		C.S.			
		R.W. ESTEER		83024	NONE
		C.P.			

CS	12/20/12	REVISED PARCEL 12-SH AT OWNER'S REQUEST
REV BY:	DATE	DESCRIPTION
FIELD REVIEW BY: CS & CP		
OWNERSHIP VERIFIED BY: CP		
DATE COMPLETE: 06/04/12		

QTR. TWP. 3, T2N, R7W
PART OF JACKSON'S LAND, P.B.M, PG. 384
WASHINGTON TOWNSHIP
MUSKINGUM COUNTY

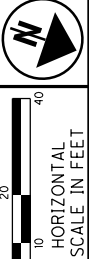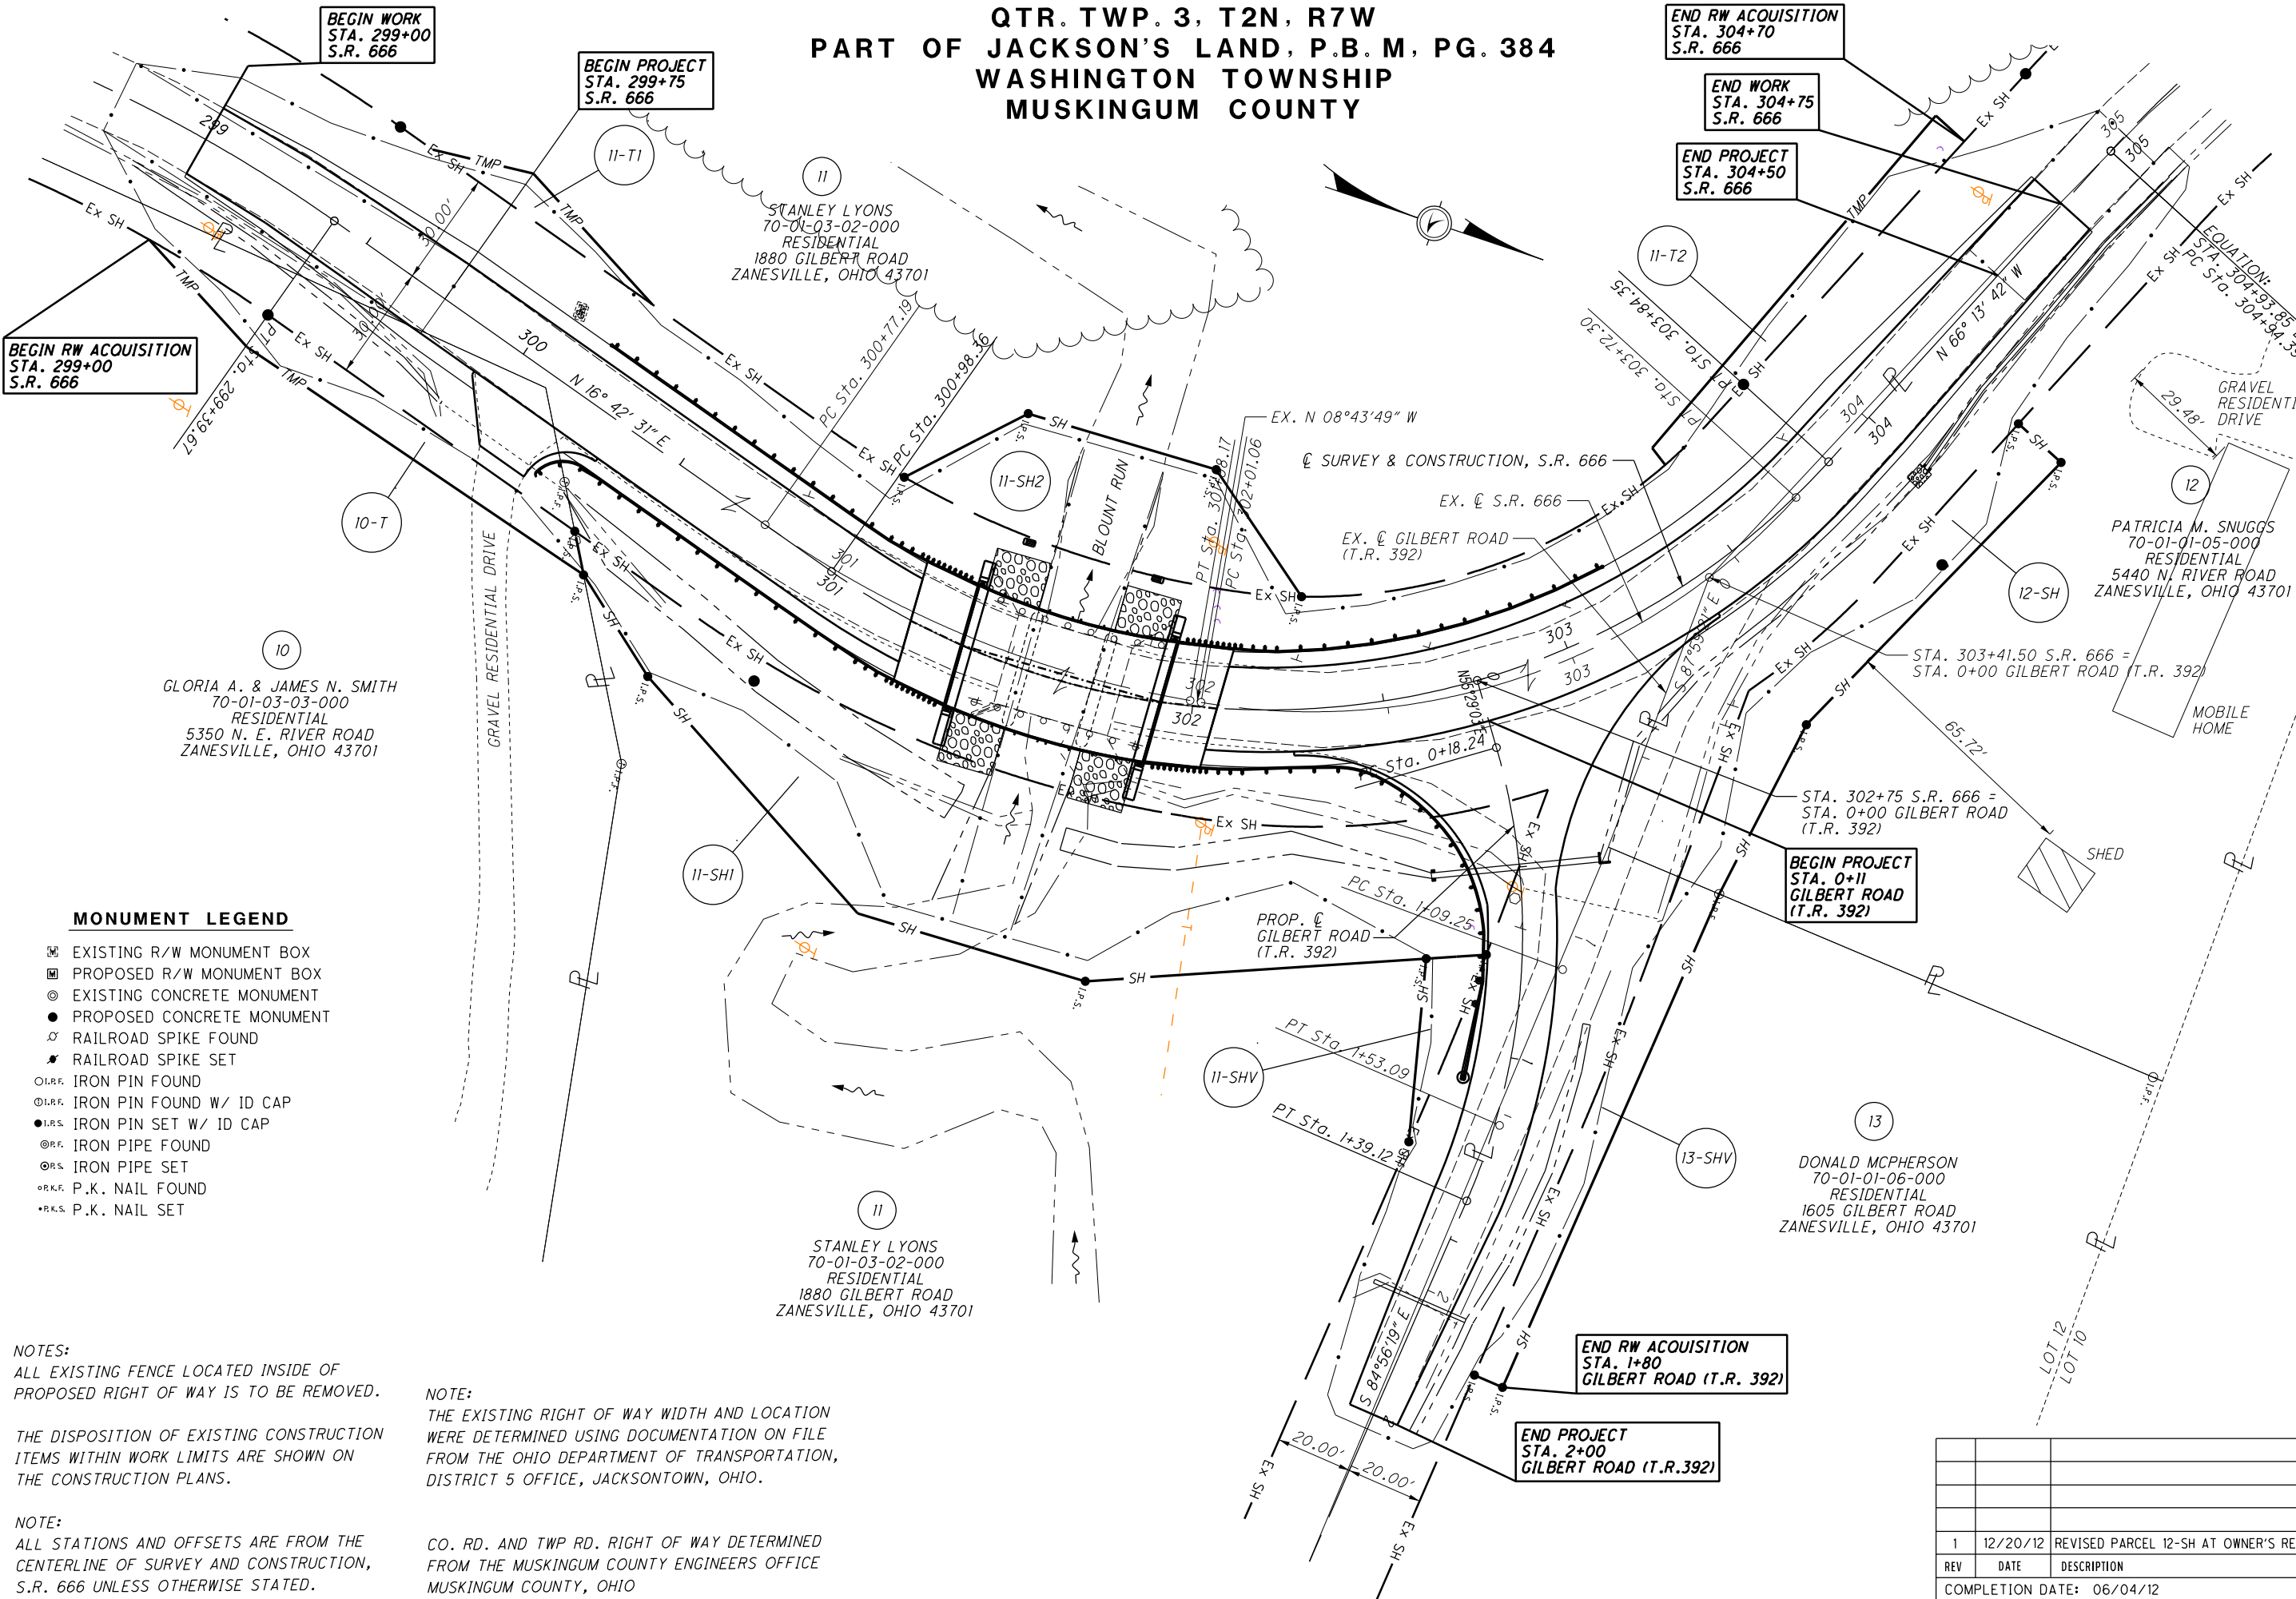

CALCULATED
C.S.
CHECKED
C.P.

RIGHT OF WAY TOPO SHEET
STA. 299+00 TO STA. 305+00

MUS-666-5.71

REV	DATE	DESCRIPTION
1	12/20/12	REVISED PARCEL 12-SH AT OWNER'S REQUEST
COMPLETION DATE: 06/04/12		

QTR. TWP. 3, T2N, R7W
PART OF JACKSON'S LAND, P.B.M. PG. 384
WASHINGTON TOWNSHIP
MUSKINGUM COUNTY



CALCULATED
C.S.
CHECKED
C.P.

RIGHT OF WAY BOUNDARY SHEET
STA. 299+00 TO STA. 305+00

MUS-666-5.71

6 / 6

64
64

P:\MUS\83024\DESIGN\RIGHT_OF_WAY\PLAN_SHEETS\MUS-666-5.71\83024_004D_RDS.dgn 12/20/12

- MONUMENT LEGEND**
- EXISTING R/W MONUMENT BOX
 - PROPOSED R/W MONUMENT BOX
 - EXISTING CONCRETE MONUMENT
 - PROPOSED CONCRETE MONUMENT
 - RAILROAD SPIKE FOUND
 - RAILROAD SPIKE SET
 - IRON PIN FOUND
 - IRON PIN FOUND W/ ID CAP
 - IRON PIN SET W/ ID CAP
 - IRON PIPE FOUND
 - IRON PIPE SET
 - P.K. NAIL FOUND
 - P.K. NAIL SET


NOTES:
ALL EXISTING FENCE LOCATED INSIDE OF PROPOSED RIGHT OF WAY IS TO BE REMOVED.

THE DISPOSITION OF EXISTING CONSTRUCTION ITEMS WITHIN WORK LIMITS ARE SHOWN ON THE CONSTRUCTION PLANS.

NOTE:
ALL STATIONS AND OFFSETS ARE FROM THE CENTERLINE OF SURVEY AND CONSTRUCTION, S.R. 666 UNLESS OTHERWISE STATED.

NOTE:
THE EXISTING RIGHT OF WAY WIDTH AND LOCATION WERE DETERMINED USING DOCUMENTATION ON FILE FROM THE OHIO DEPARTMENT OF TRANSPORTATION, DISTRICT 5 OFFICE, JACKSONTOWN, OHIO.

CO. RD. AND TWP RD. RIGHT OF WAY DETERMINED FROM THE MUSKINGUM COUNTY ENGINEERS OFFICE MUSKINGUM COUNTY, OHIO

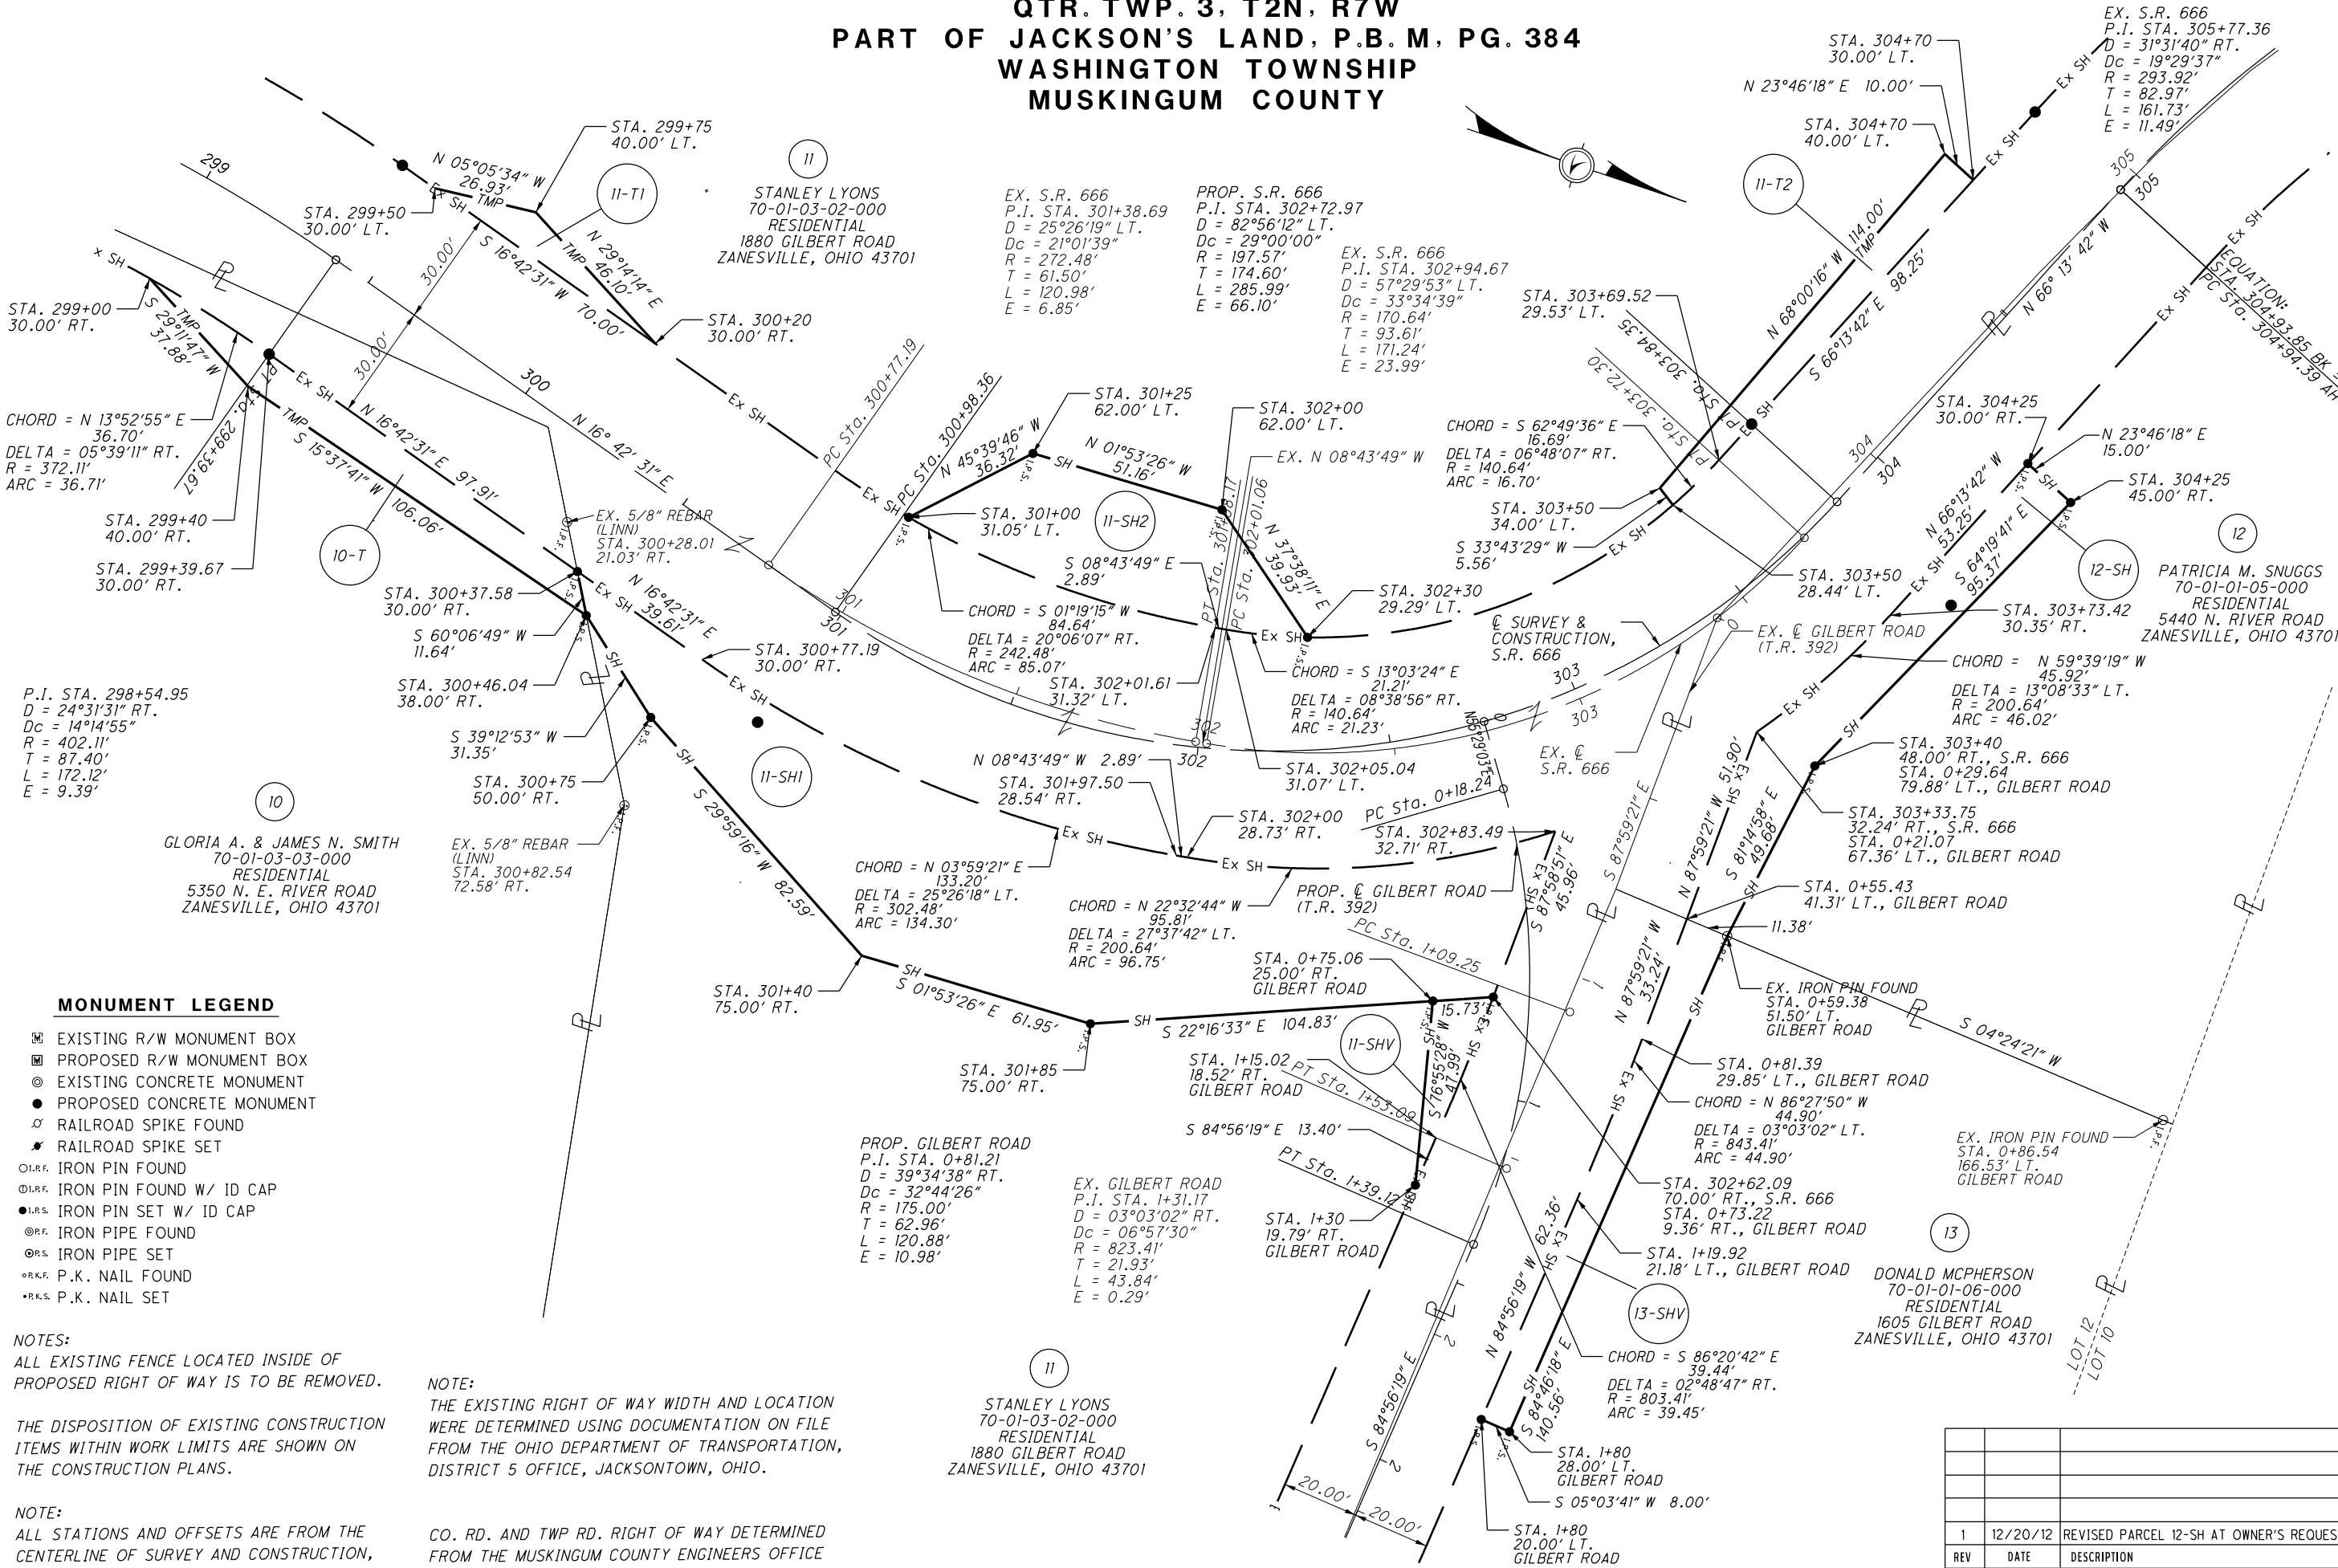

REV	DATE	DESCRIPTION
1	12/20/12	REVISED PARCEL 12-SH AT OWNER'S REQUEST
COMPLETION DATE: 06/04/12		