


$PI = 528+58.37$
 $\Delta = 8^{\circ}38'17''$
 $D = 1^{\circ}00'$
 $R = 5729.58'$
 $T = 432.47'$
 $L = 863.33'$
 $E = 16.27'$

Note: S.R. 60 was formerly S.R. 77

FED. RD. DIVISION	STATE	PROJECT
2	OHIO	

MUS-60-(8.11.13.08)
R/W PLAN

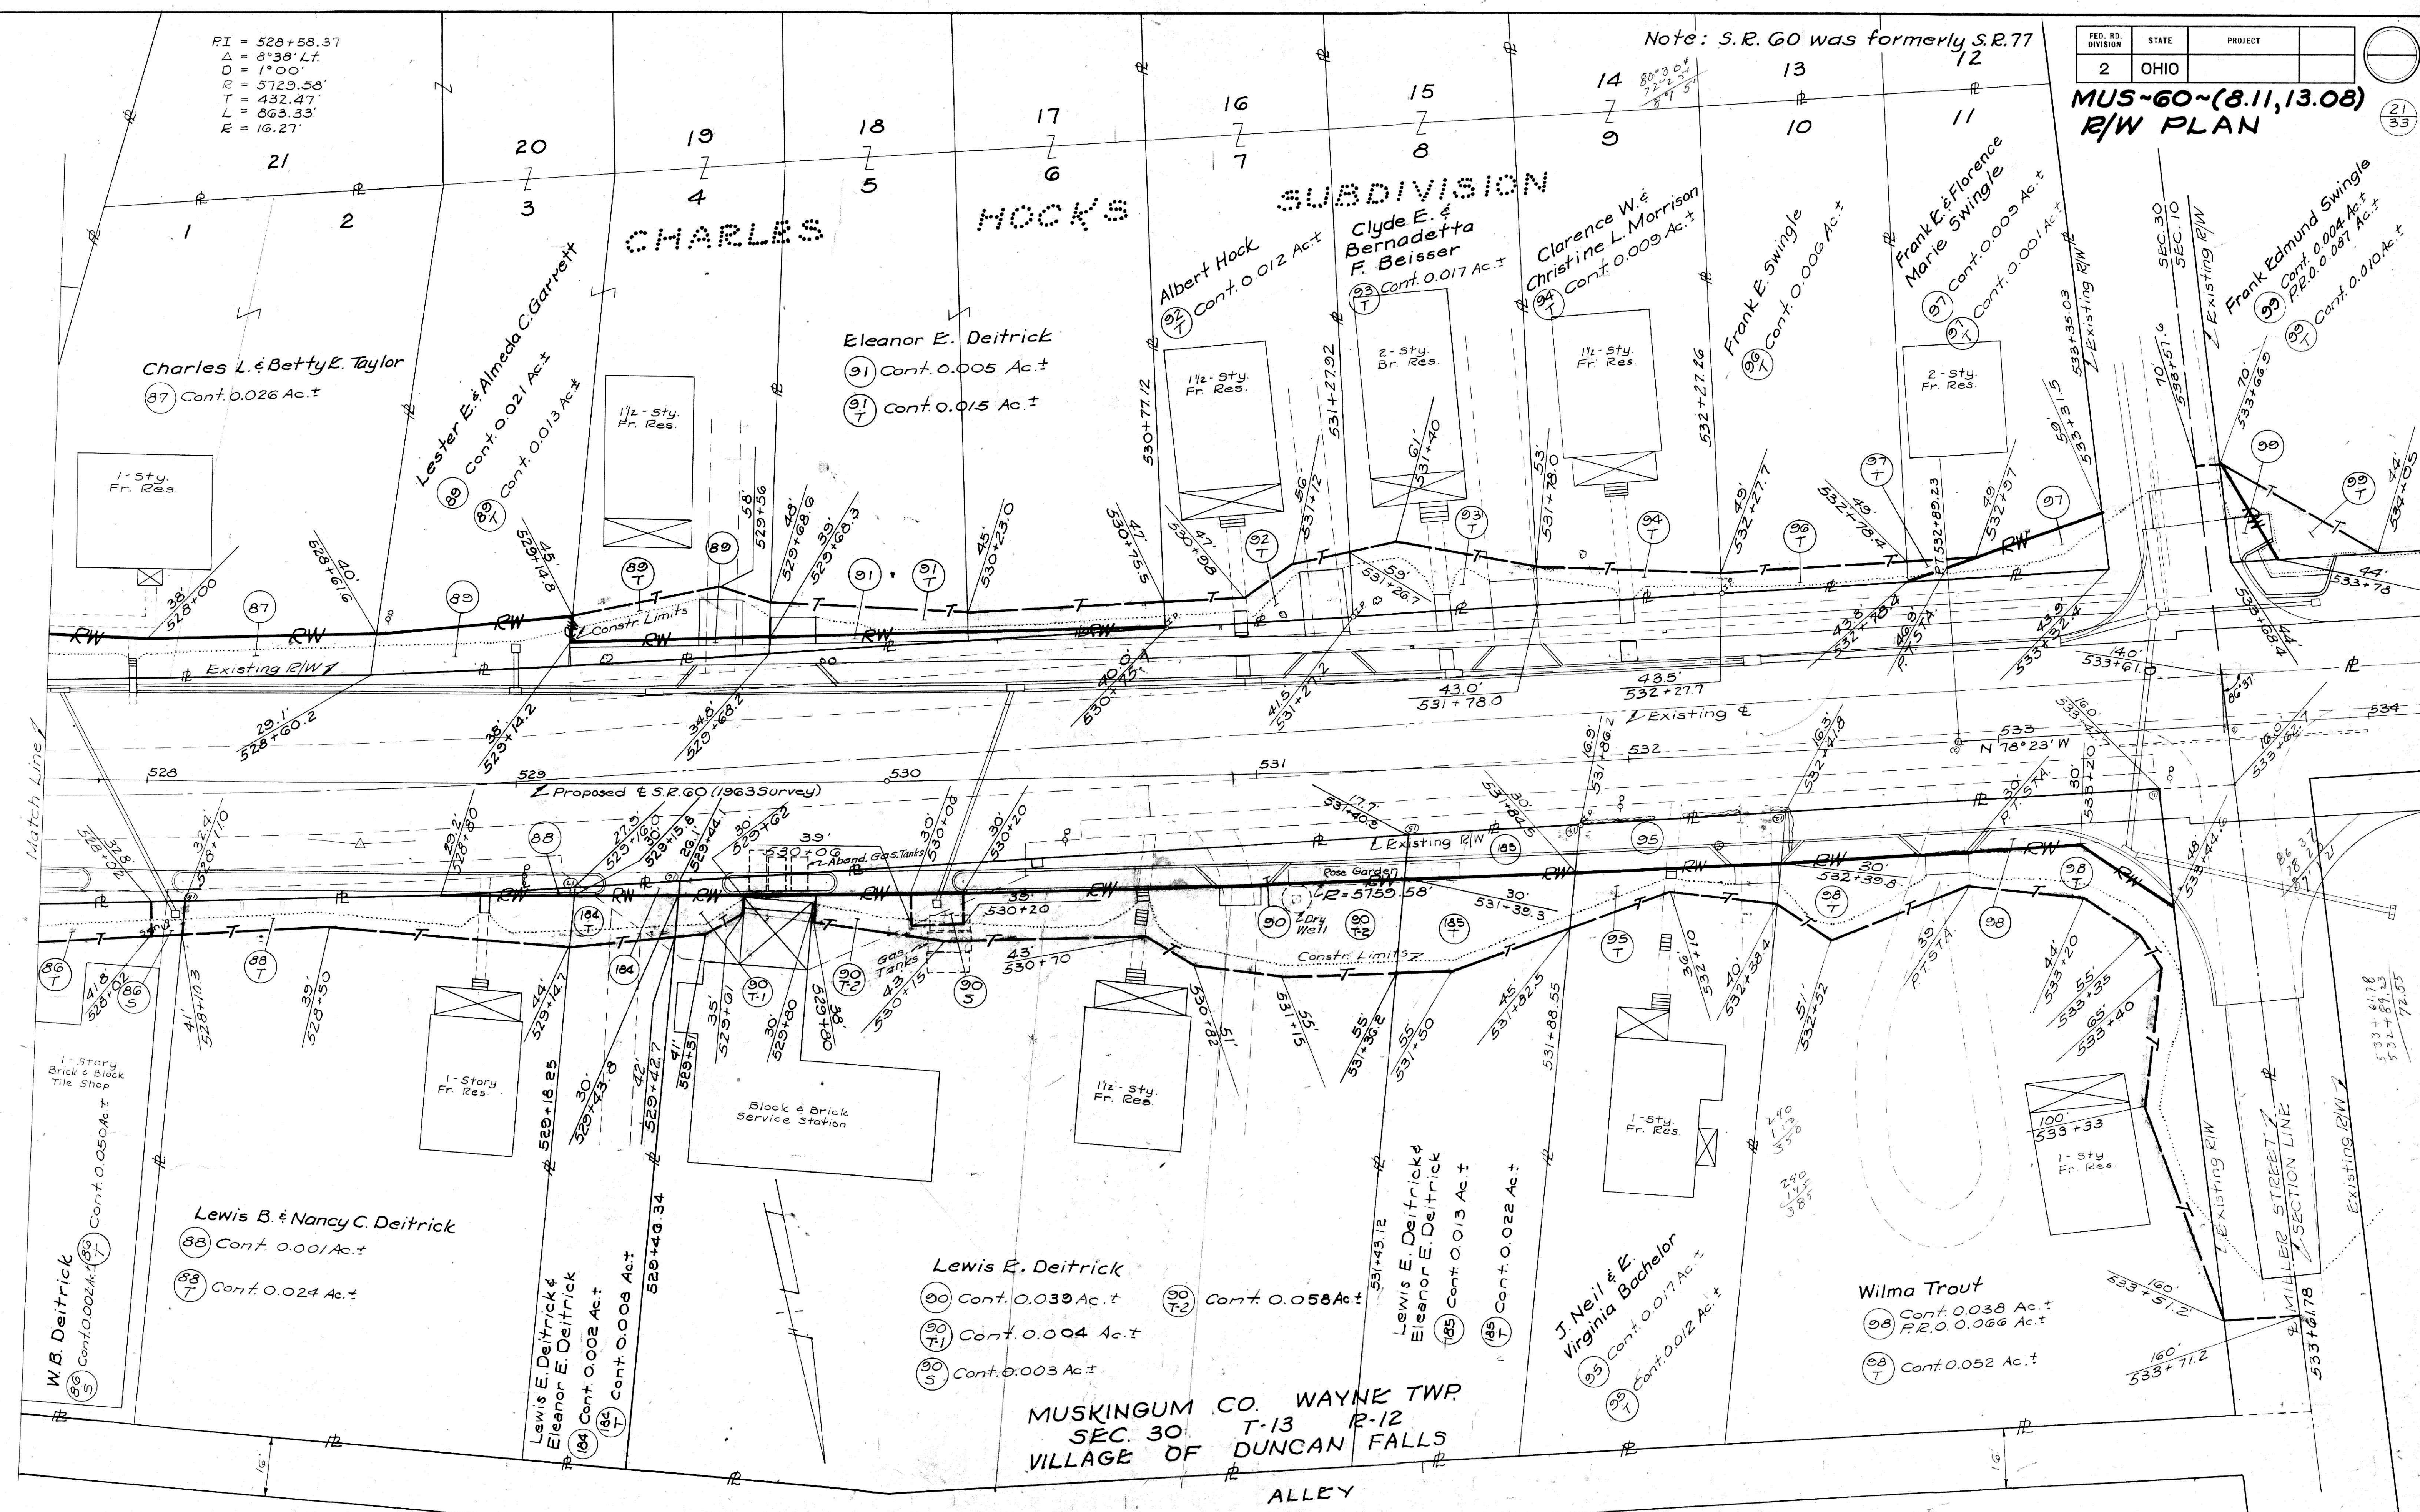

The Plat is Recorded in Bk. 11, Pgs. 26 & 27 of the Muskingum Co. Plat Records

Added Tanks & Dry Well &
 Added Par. 184 & 185 - 8-18-64
 Completion Date: 6-19-64

527 to MILLERS LANE
 527 to MILLERS LANE
 MUS-60-(8.11.13.08)
 MUS-60-(8.11.13.08)