


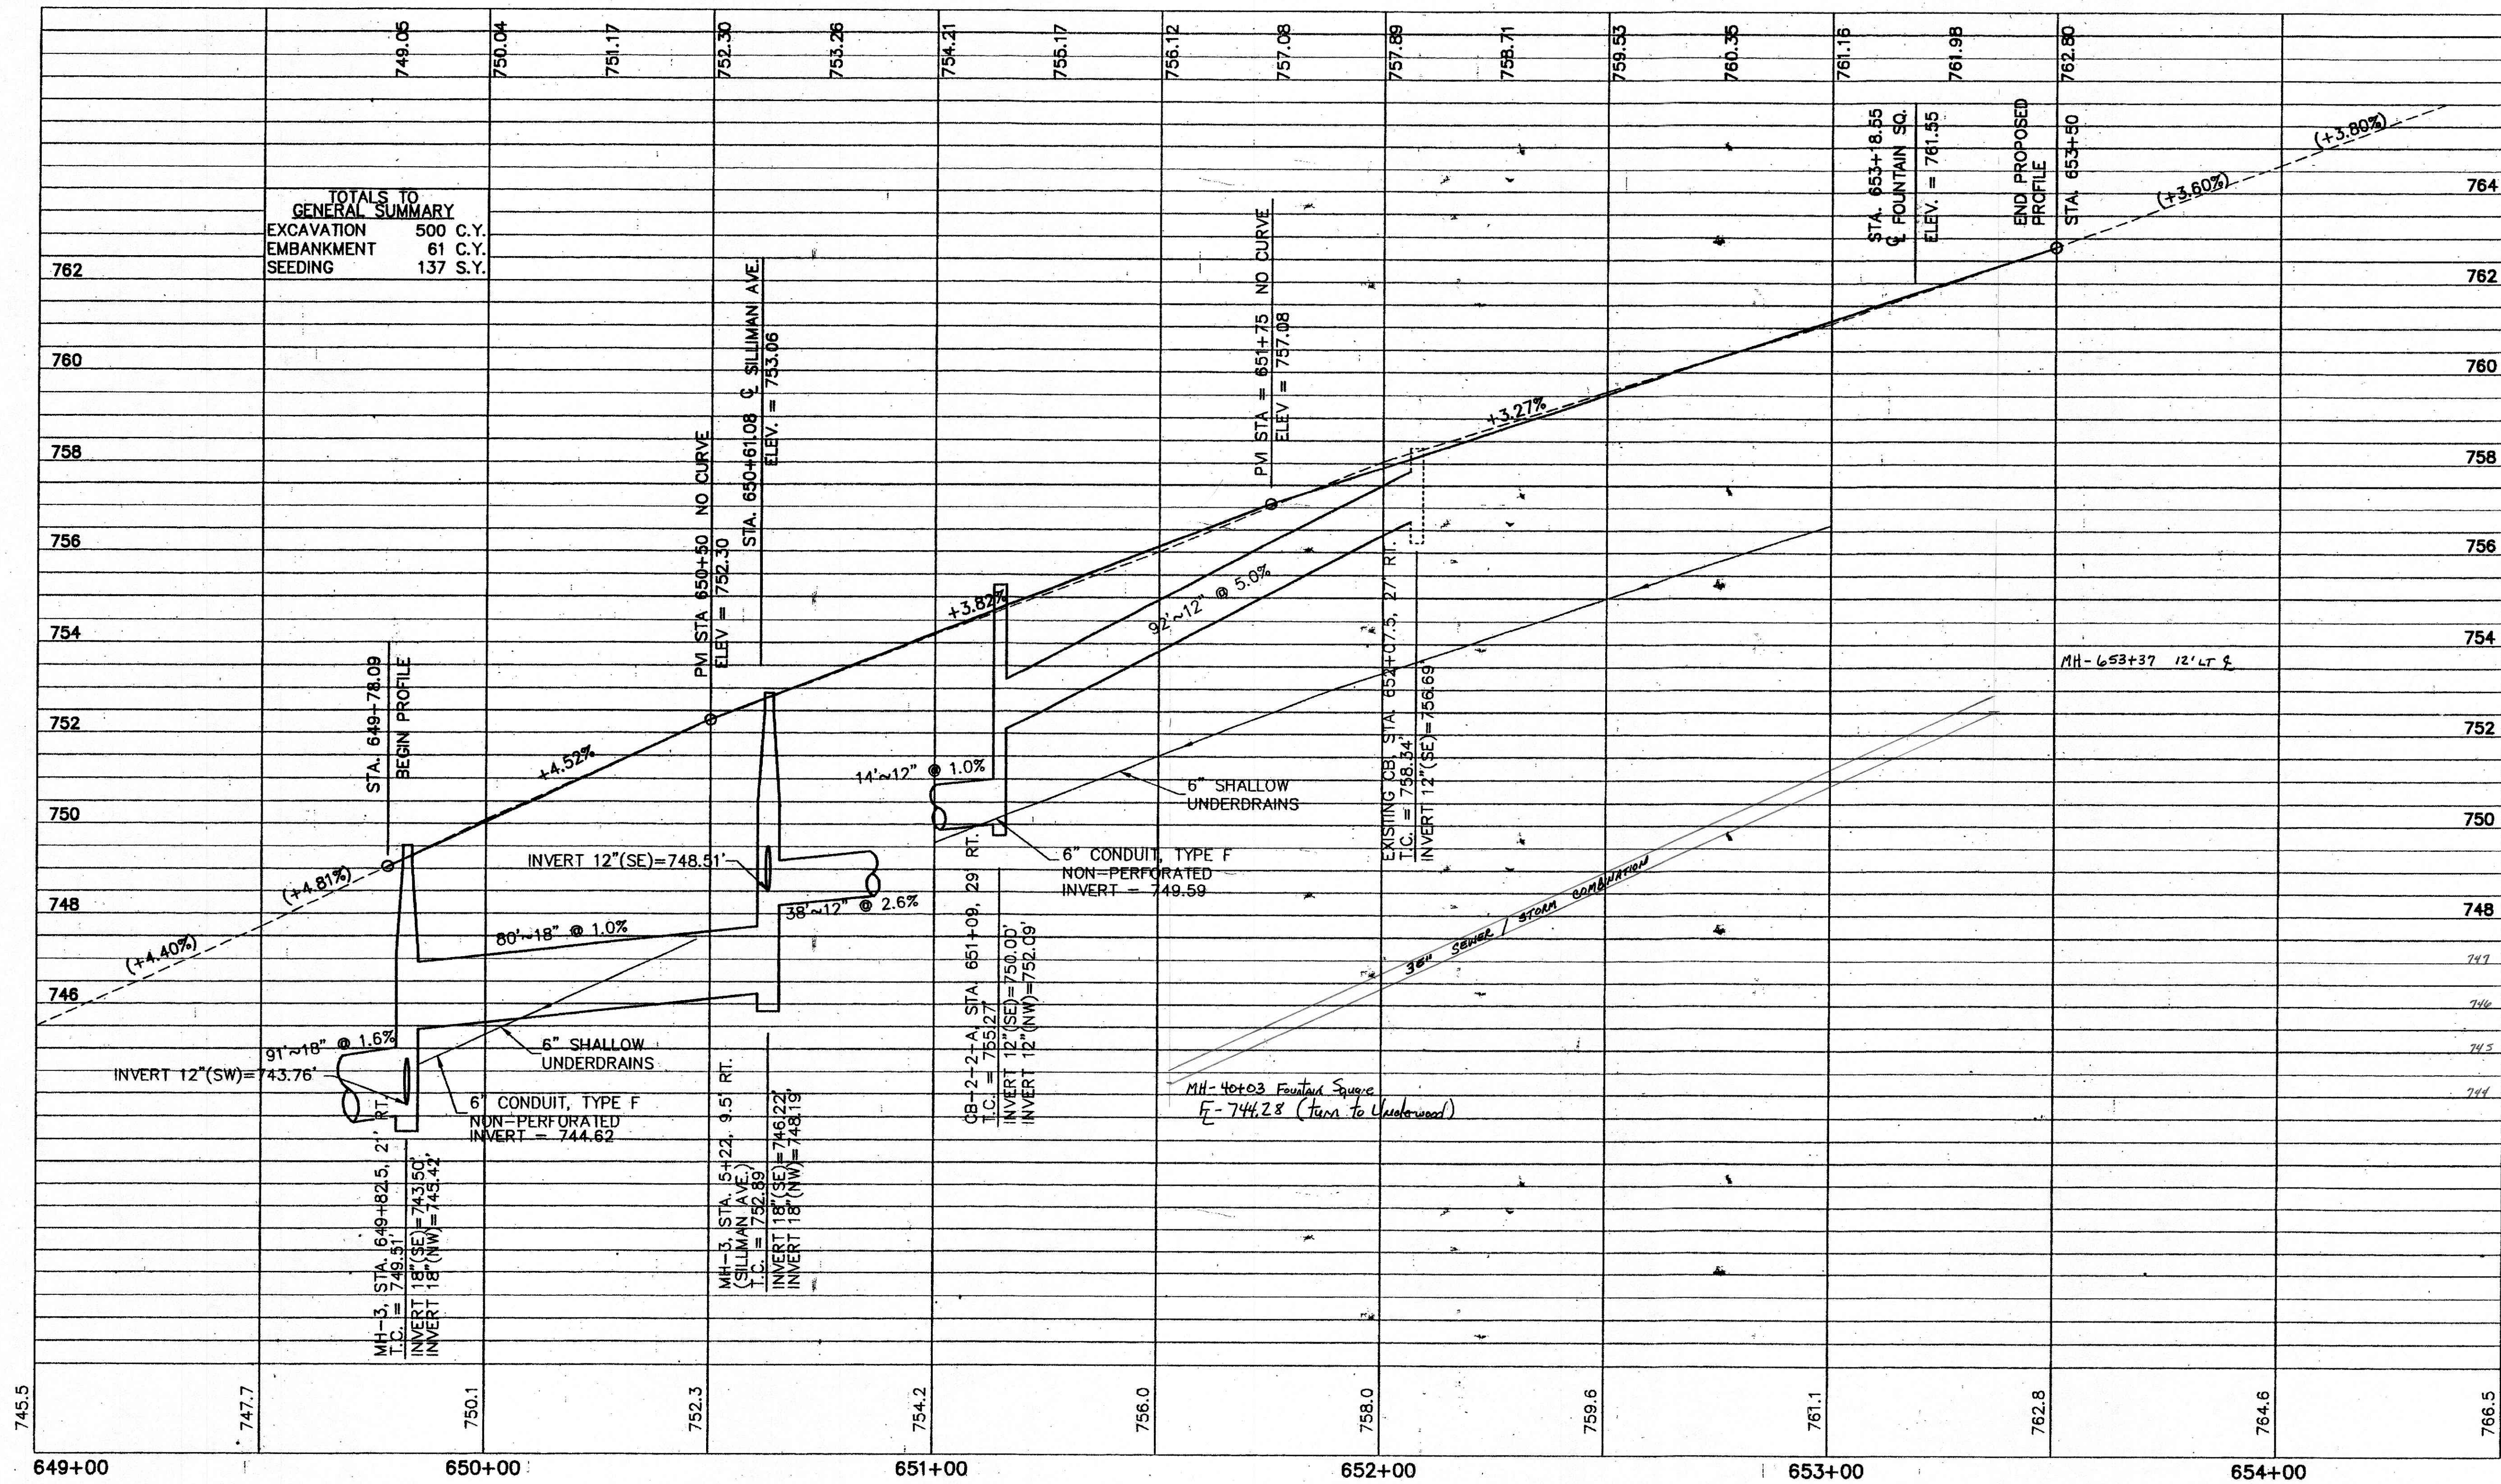

GREENWOOD AVENUE PROFILE

MUS-22-12.28

PROFILE
GREENWOOD AVENUE