


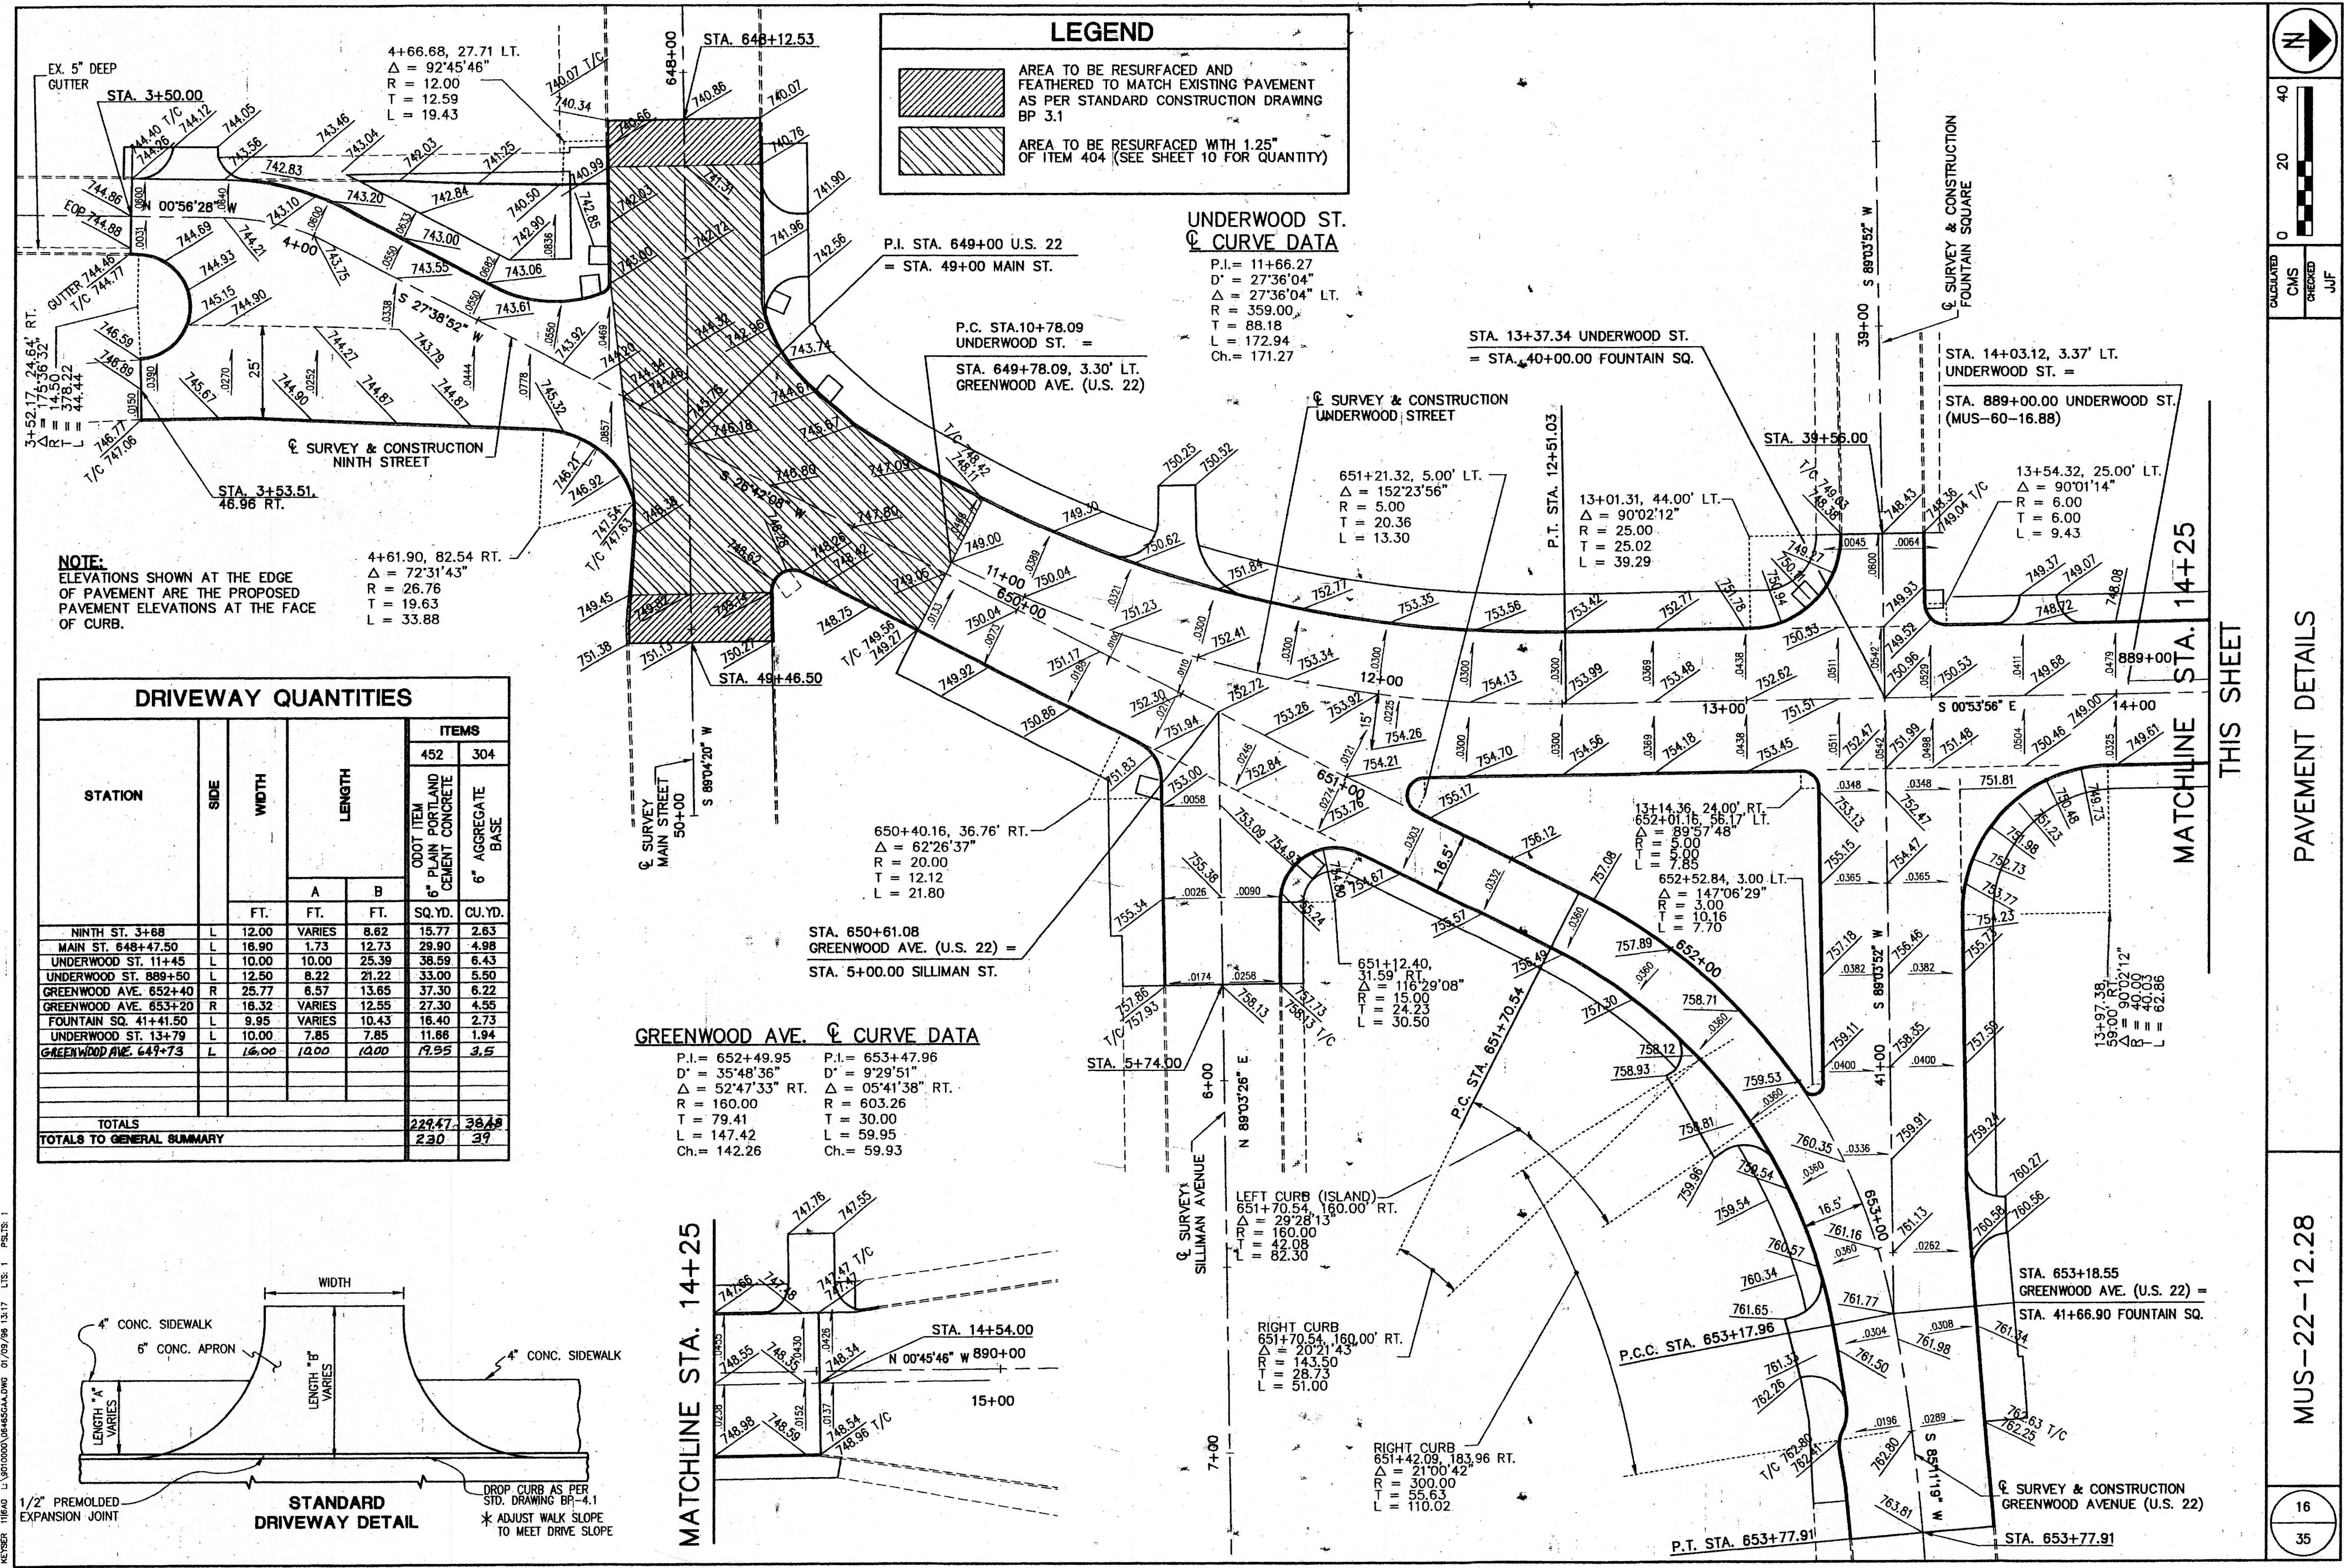

0

20

40

CALCULATED

CMS

CHECKED

JUF

MUS-22-12.28

16

35

DRIVEWAY QUANTITIES						
STATION	SIDE	WIDTH	LENGTH	ITEMS		
				452	304	
				ODOT ITEM 6" PLAIN PORTLAND CEMENT CONCRETE	6" AGGREGATE BASE	
		FT.	A FT.	B FT.	SQ. YD.	CU. YD.
NINTH ST. 3+68	L	12.00	VARIES	8.62	15.77	2.63
MAIN ST. 648+47.50	L	16.90	1.73	12.73	29.90	4.98
UNDERWOOD ST. 11+45	L	10.00	10.00	25.39	38.59	6.43
UNDERWOOD ST. 889+50	L	12.50	8.22	21.22	33.00	5.50
GREENWOOD AVE. 652+40	R	25.77	6.57	13.65	37.30	6.22
GREENWOOD AVE. 653+20	R	16.32	VARIES	12.55	27.30	4.55
FOUNTAIN SQ. 41+41.50	L	9.95	VARIES	10.43	18.40	2.73
UNDERWOOD ST. 13+79	L	10.00	7.85	7.85	11.88	1.94
GREENWOOD AVE. 649+73	L	16.00	12.00	12.00	17.95	3.5
TOTALS					229.47	38.48
TOTALS TO GENERAL SUMMARY					230	39

GREENWOOD AVE. CURVE DATA
P.I. = 652+49.95 P.I. = 653+47.96
D' = 35'48"36" D' = 9'29'51"
Δ = 52'47'33" RT. Δ = 05'41'38" RT.
R = 160.00 R = 603.26
T = 79.41 T = 30.00
L = 147.42 L = 59.95
Ch. = 142.26 Ch. = 59.93