


PAVEMENT MARKING SYMBOL LEGEND			
DESCRIPTION	EXISTING		NEW
	TO REMAIN	TO BE REMOVED	
LANE LINE/CENTER LINE	—	—	—
STOP LINE	—	—	—
WORD ON PAVEMENT	ONLY	ONLY	ONLY
LANE ARROW	↩	↩	↩

SIGNING LEGEND	
	NEW SIGN
	EXISTING SIGN TO REMAIN
	EXISTING SIGN TO BE REMOVED

PAVEMENT MARKING LEGEND	
SL	STOP LINE
CL	CHANNELIZING LINE
DSY	DOUBLE SOLID LINE
LL	LANE LINE
DL	DOTTED LINE, WHITE
EW	EDGE LINE, WHITE
EY	EDGE LINE, YELLOW
CW	CROSSWALK LINE
TW	TRANSVERSE LINE, WHITE
TY	TRANSVERSE LINE, YELLOW
BSY	BROKEN AND SOLID YELLOW CENTERLINE

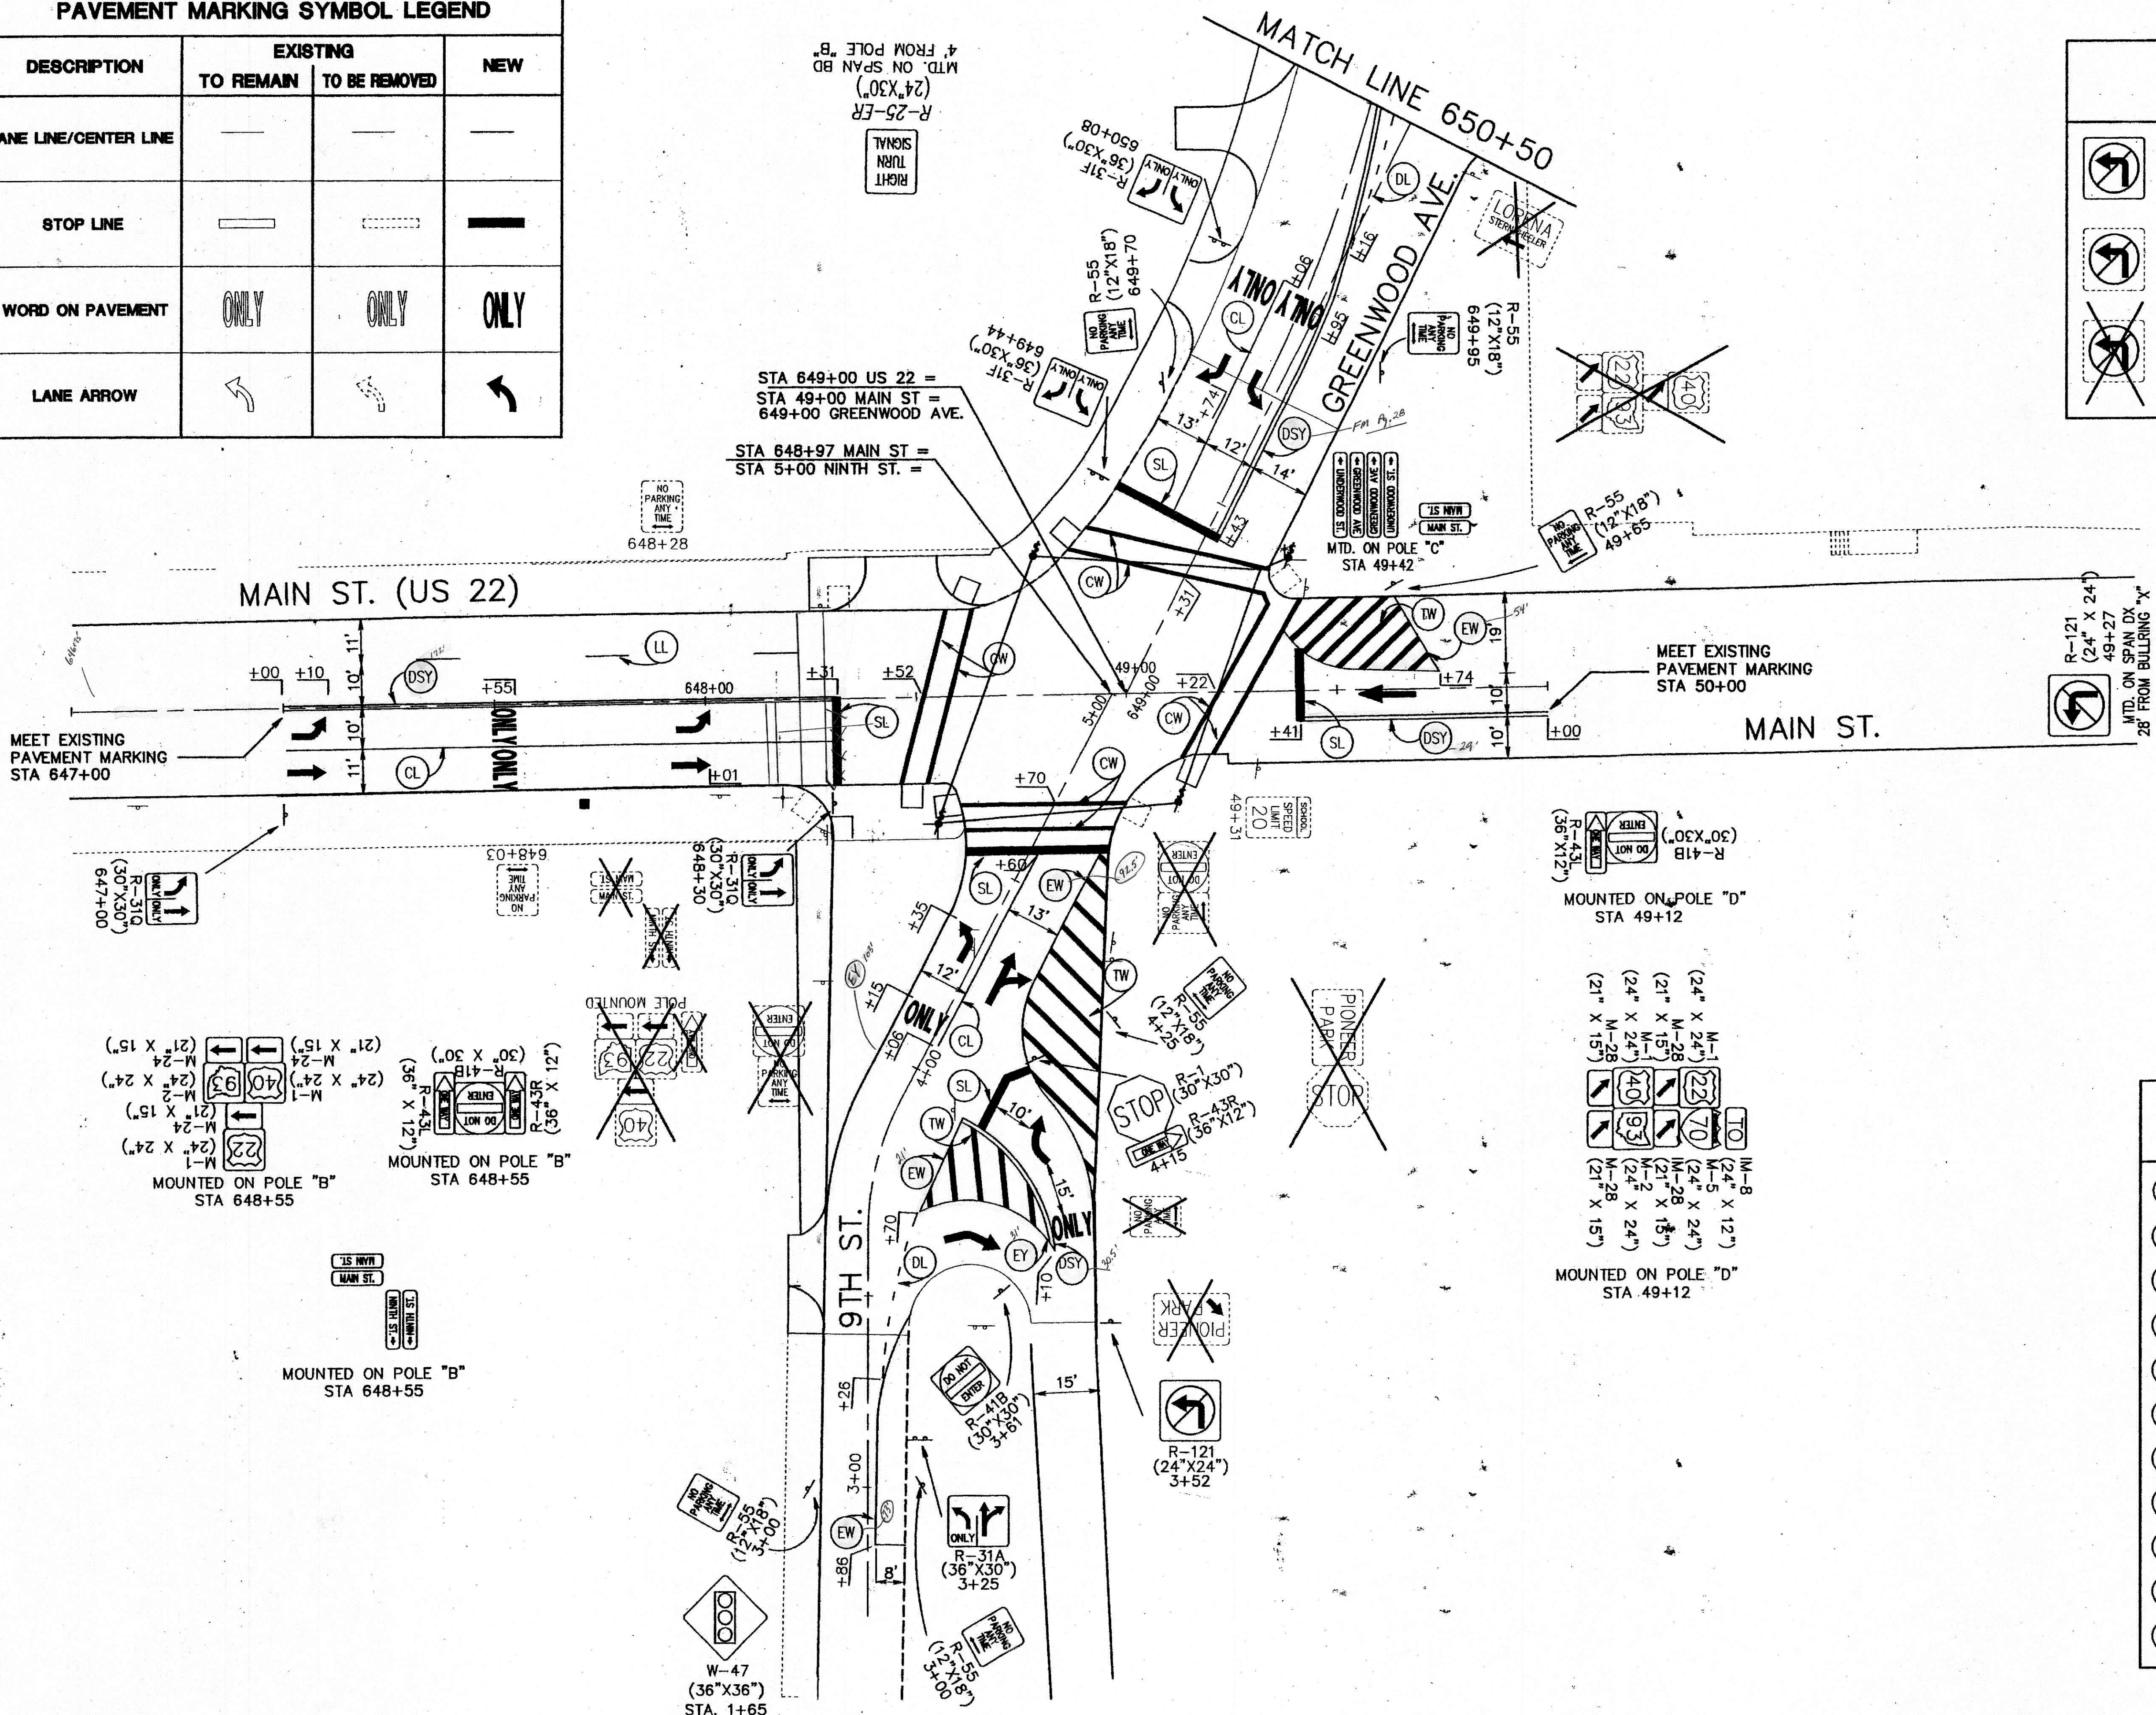

SIGNING & PAVEMENT MARKING PLAN
STA 2+86 TO STA 650+50

MUS-22-12.28