


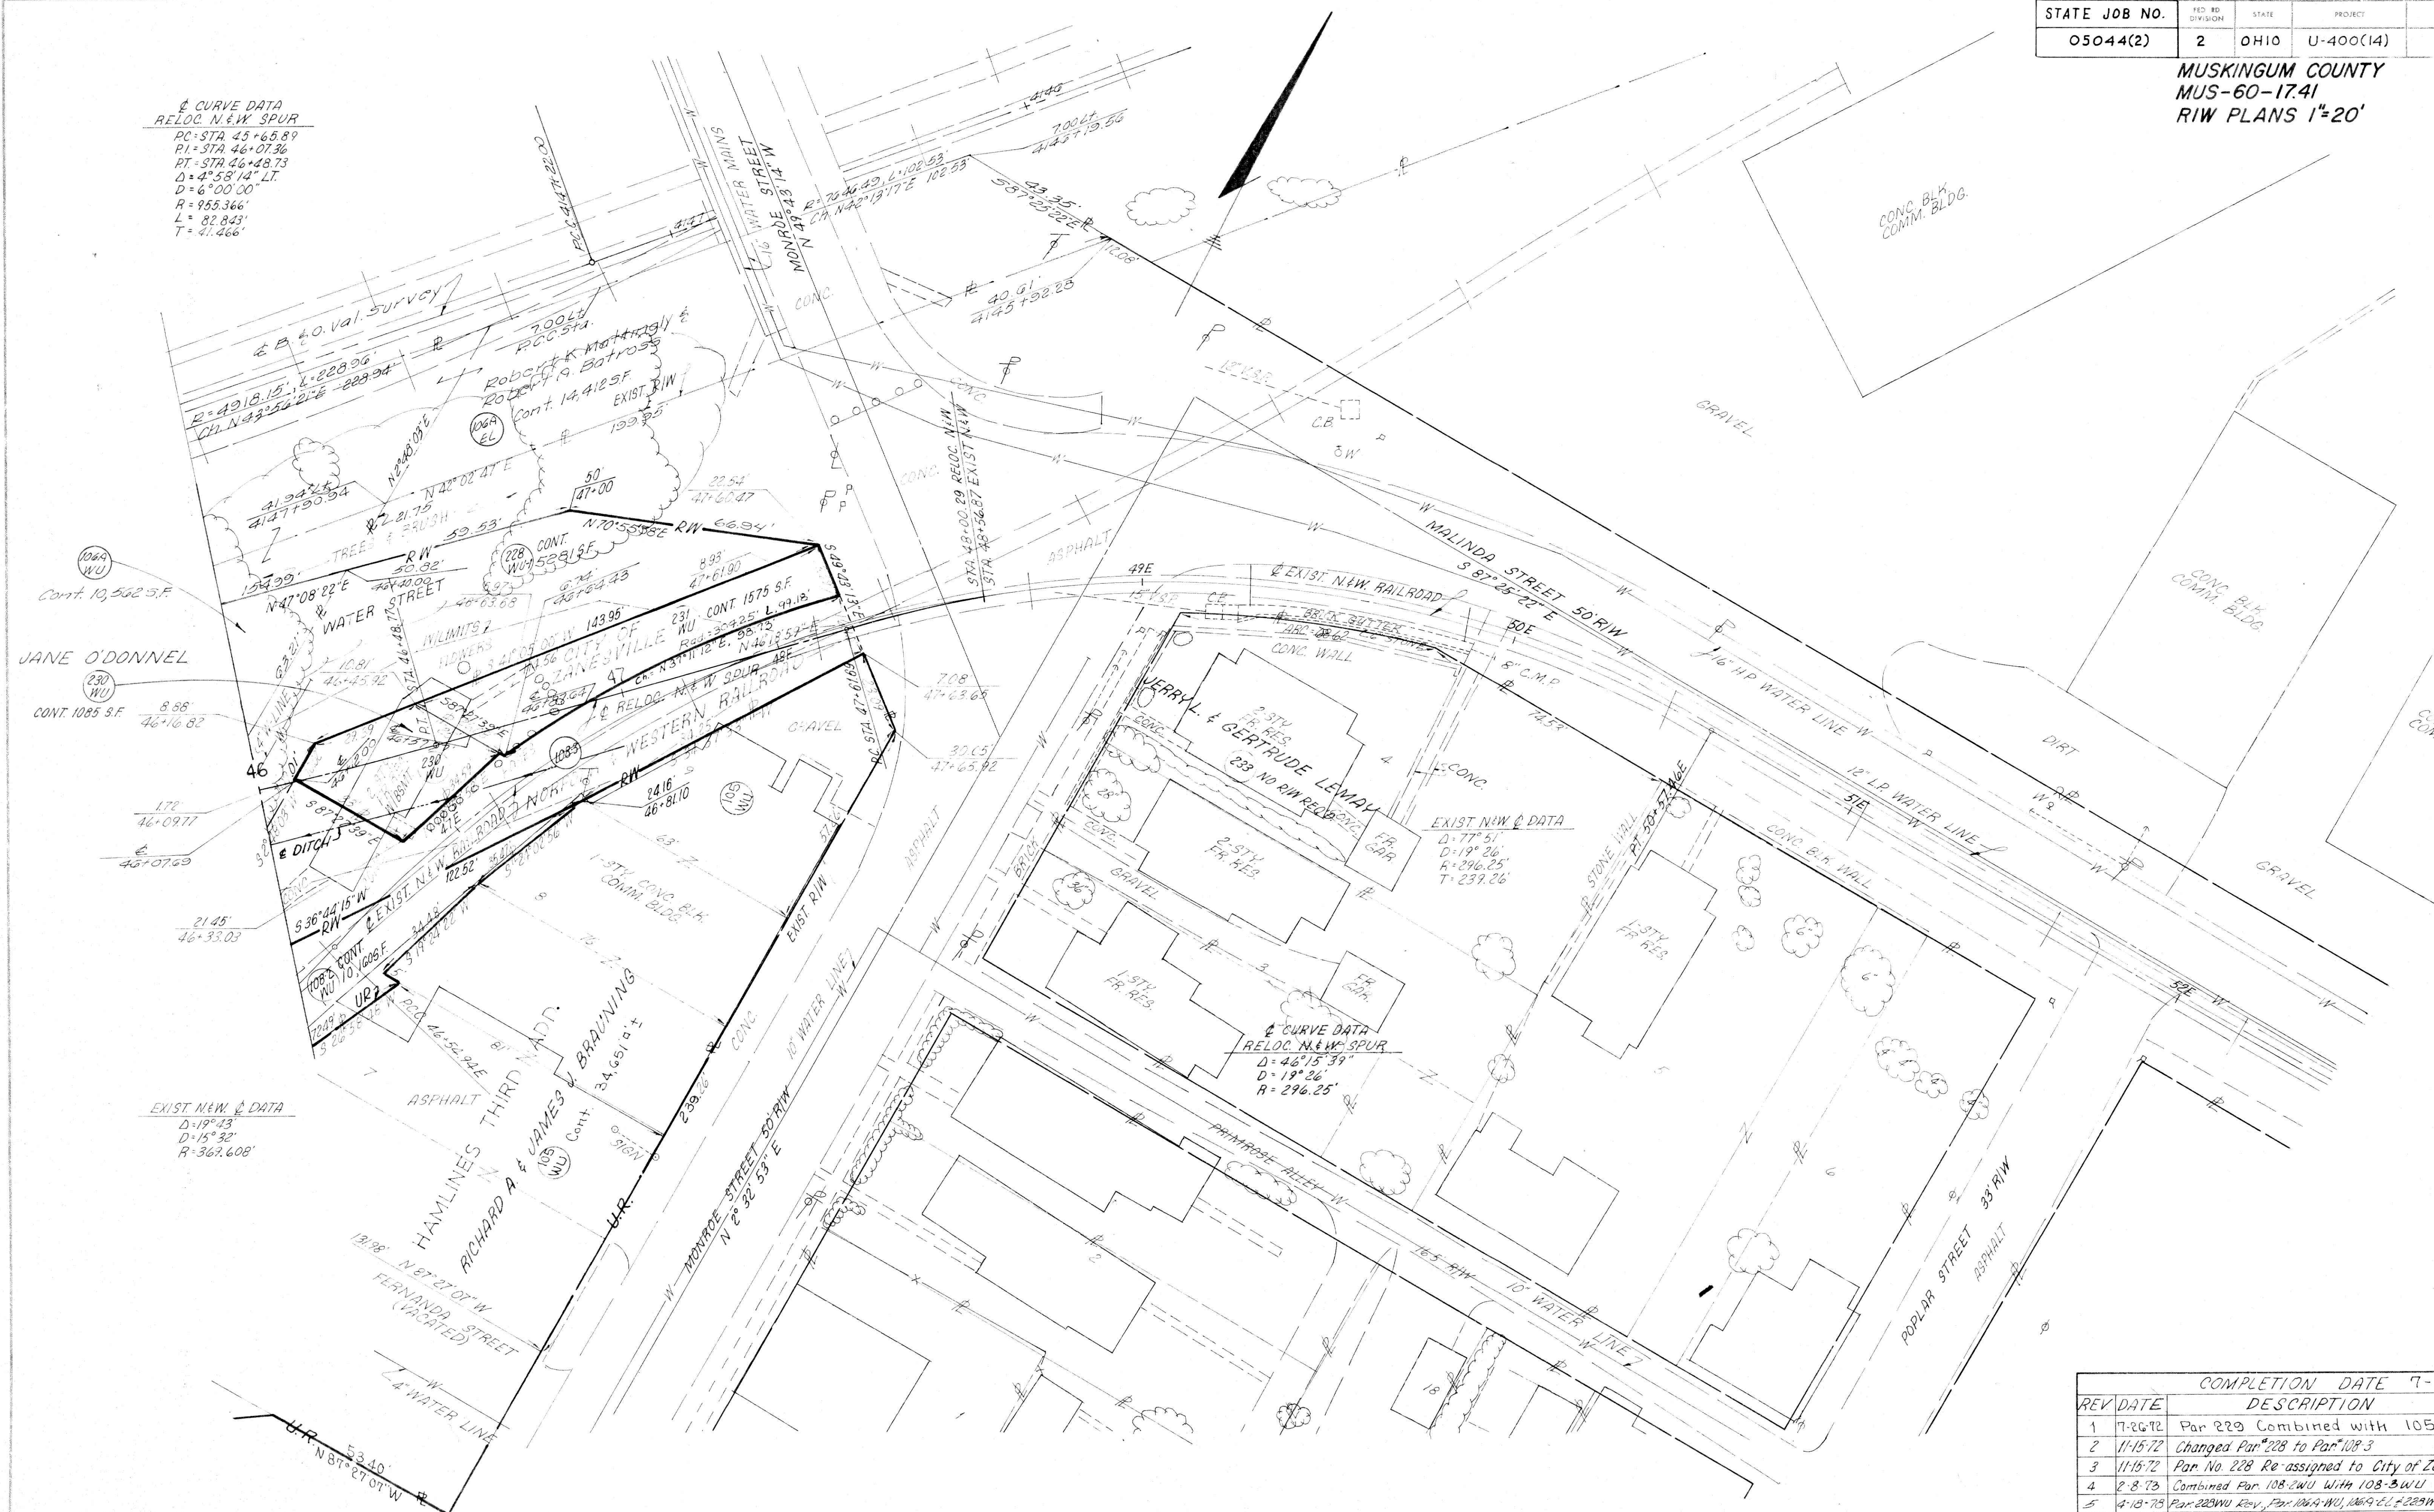

& CURVE DATA  
 RELOC. N&W SPUR  
 PC=STA 45+65.89  
 PI=STA 46+07.36  
 PT=STA 46+48.73  
 Δ=4°58'14" LT.  
 D=6°00'00"  
 R=955.366'  
 L=82.843'  
 T=41.466'

EXIST. N&W & DATA  
 D=19°43'  
 D=15°32'  
 R=367.608'

& CURVE DATA  
 RELOC. N&W SPUR  
 D=46°15'39"  
 D=19°26'  
 R=296.25'

EXIST. N&W & DATA  
 D=77°51'  
 D=19°26'  
 R=296.25'  
 T=239.26'

CITY OF ZANESVILLE, WASHINGTON TWP, T-1-N, R-7-W

| COMPLETION DATE 7-3-72 |          |                                                   |      |
|------------------------|----------|---------------------------------------------------|------|
| REV                    | DATE     | DESCRIPTION                                       | FUND |
| 1                      | 7-26-72  | Par 229 Combined with 105                         |      |
| 2                      | 11-15-72 | Changed Par 228 to Par 108.3                      |      |
| 3                      | 11-15-72 | Par No. 228 Re-assigned to City of Zanesville     |      |
| 4                      | 2-8-73   | Combined Par 108-2WU With 108-3WU                 |      |
| 5                      | 4-18-73  | Par 229WU Rev. Par 106A-WU, 106A-2C & 229WU Added |      |

RELOC. N&W SPUR STA.46+00 TO STA.52+00

RELOC. N&W SPUR STA.46+00 TO STA.52+00