

PROPERTY MAP


0 100 200 300 400 500
SCALE IN FEET

STATE JOB NO.	F.R.D.	STATE	PROJECT
05044(2)	2	OHIO	U-400(14)

MUSKINGUM COUNTY
MUS-60-1741
PROPERTY MAP

77
86

4
13

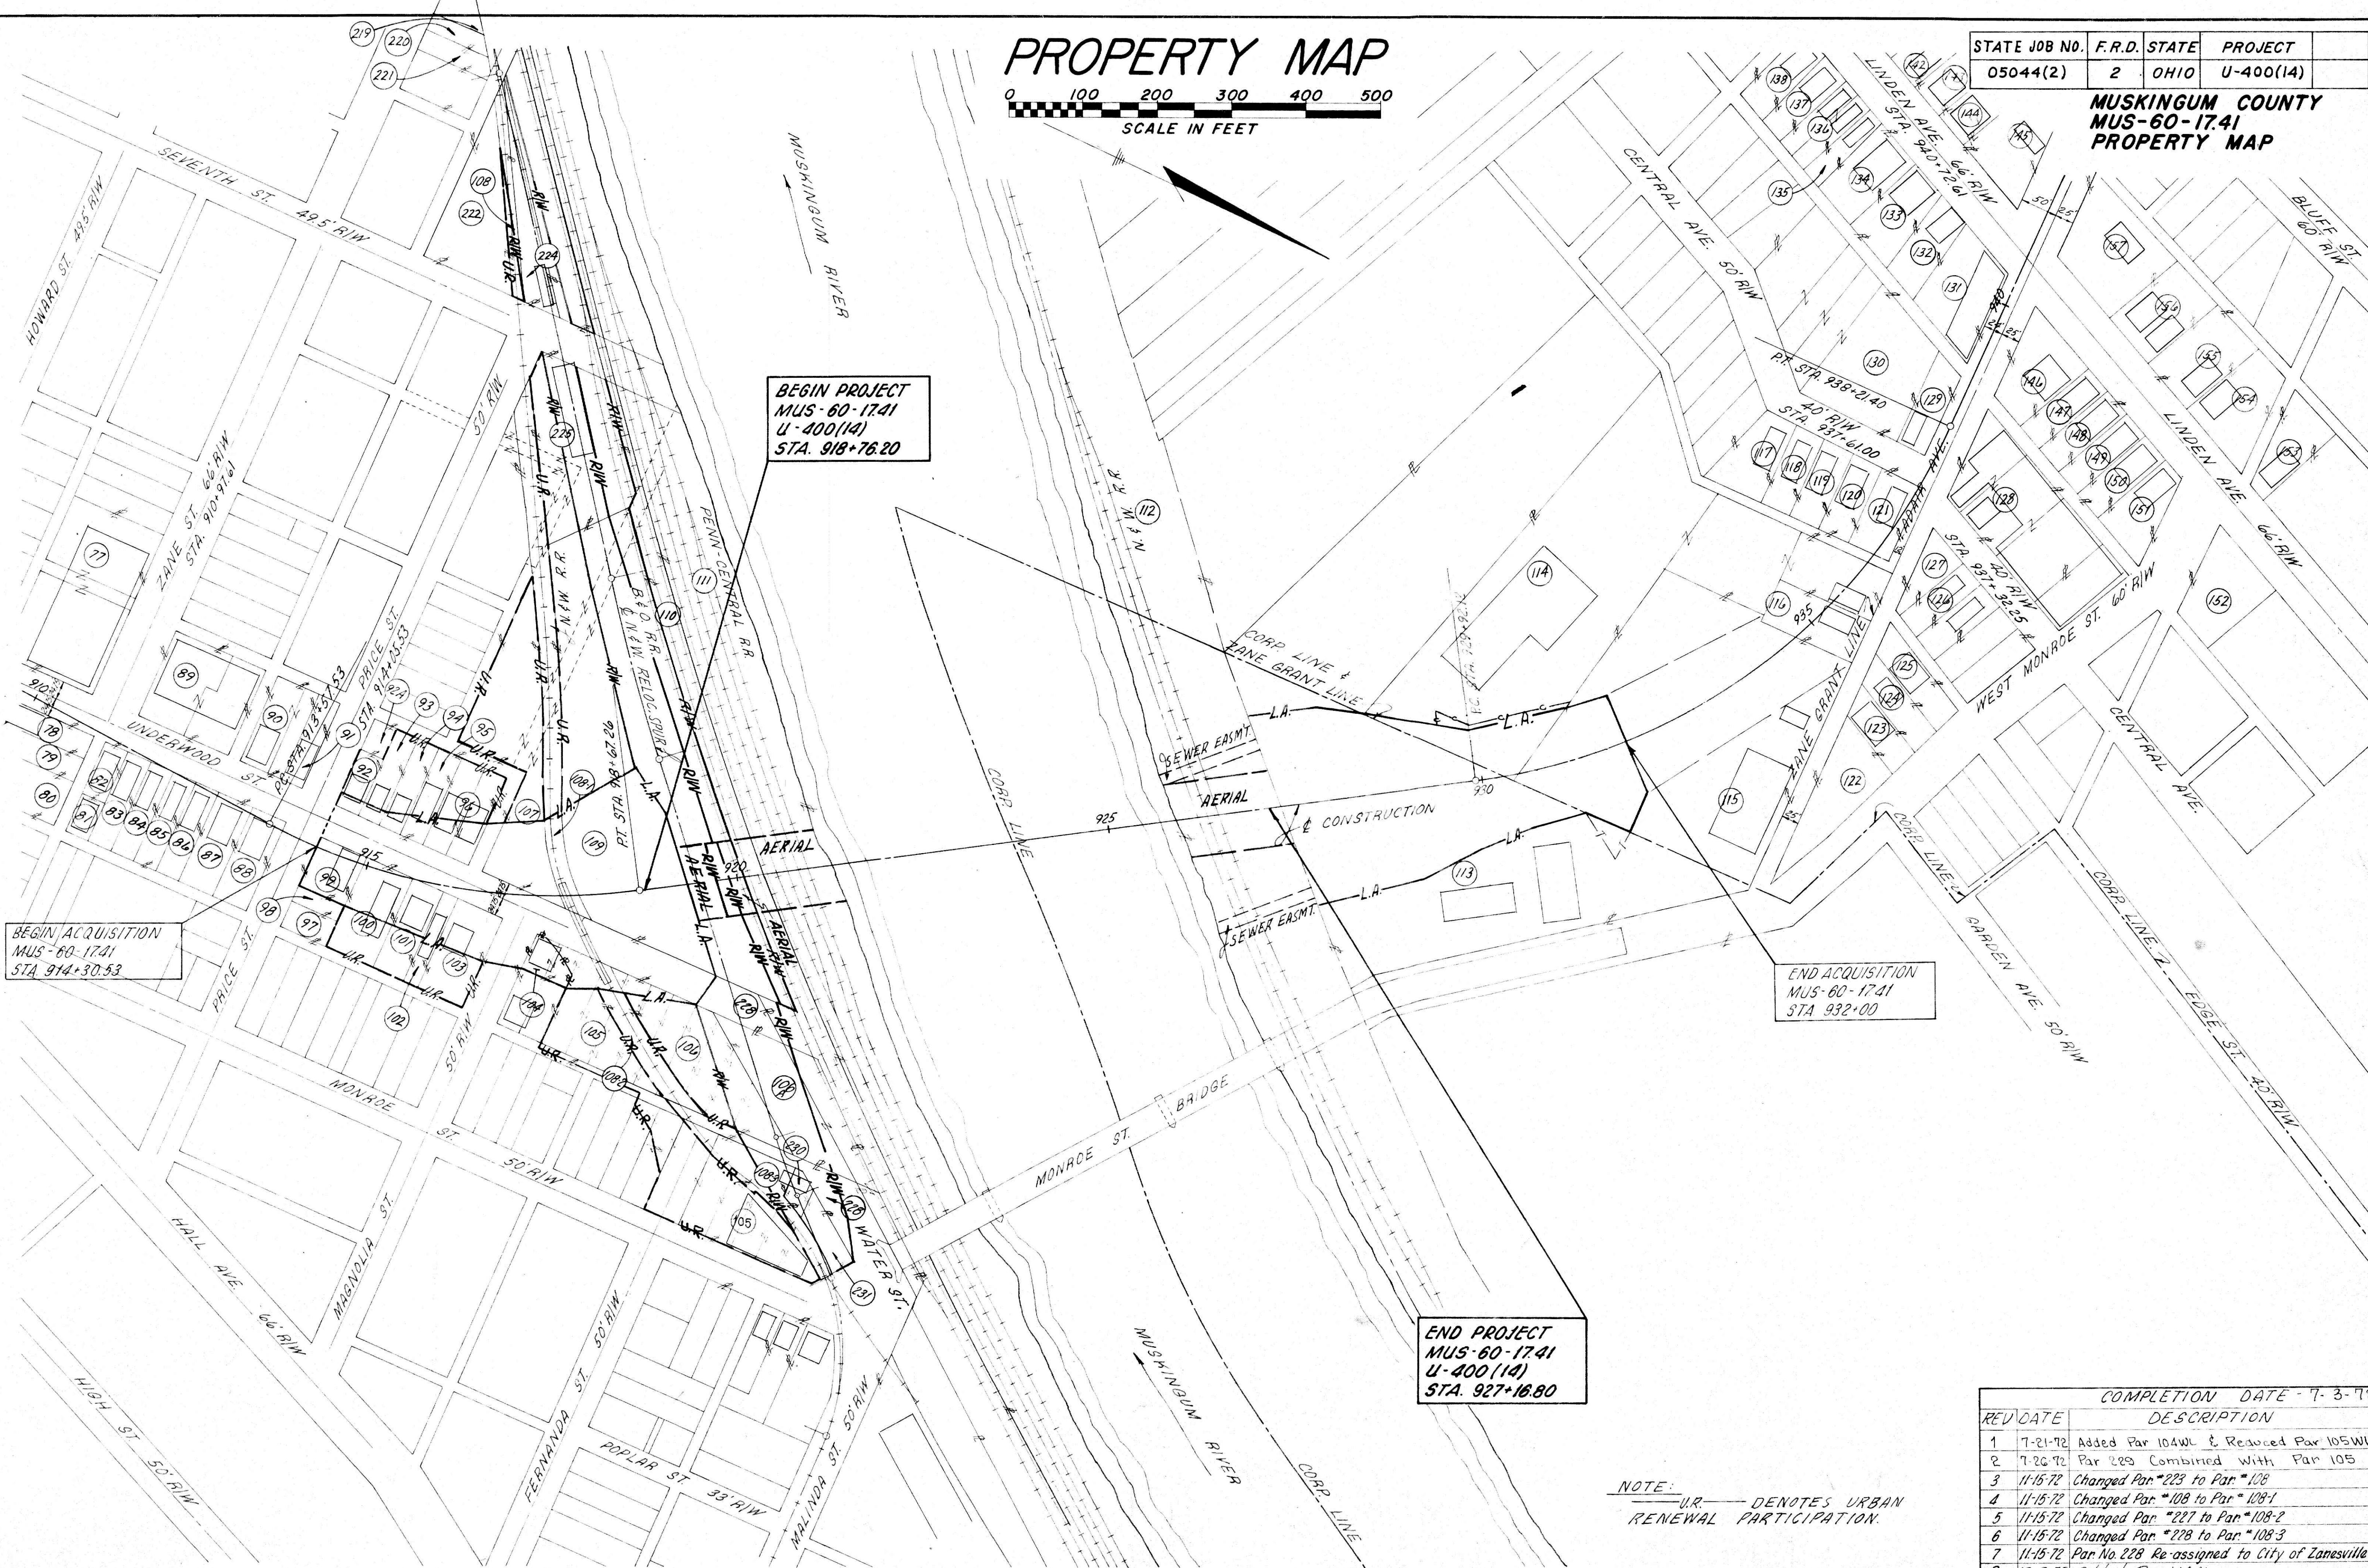

BEGIN ACQUISITION
MUS-60-1741
STA. 914+30.53

BEGIN PROJECT
MUS-60-1741
U-400(14)
STA. 918+76.20

END ACQUISITION
MUS-60-1741
STA. 932+00

END PROJECT
MUS-60-1741
U-400(14)
STA. 927+16.80

NOTE:
U.R. DENOTES URBAN
RENEWAL PARTICIPATION.

REV	DATE	DESCRIPTION	COMPLETION DATE - 7-3-72	FUND
1	7-21-72	Added Par 104WL & Reduced Par 105WL		
2	7-26-72	Par 229 Combined With Par 105		
3	11-15-72	Changed Par. *223 to Par. *108		
4	11-15-72	Changed Par. *108 to Par. *108-1		
5	11-15-72	Changed Par. *227 to Par. *108-2		
6	11-15-72	Changed Par. *228 to Par. *108-3		
7	11-15-72	Par No. 228 Re-assigned to City of Zanesville		
8	12-5-72	Added Par 114X		

MUS-60 PROPERTY MAP STA. 914+00 TO STA. 940+00 RIW
MUS-60 PROPERTY MAP STA. 914+00 TO STA. 940+00 RIW