


|               |                   |       |           |
|---------------|-------------------|-------|-----------|
| STATE JOB NO. | FED. RD. DIVISION | STATE | PROJECT   |
| 05044(2)      | 2                 | OHIO  | U-400(14) |

MUSKINGUM COUNTY  
MUS-60-1741  
RIW PLANS 1"=20'

81  
86  
8  
13

B.O. CURVE DATA  
P.C. STA 4156+22.00  
P.I. STA 4161+47.04  
P.T. STA 4166+72.00  
Δ=1°45'  
D=0°10'  
R=34,377.492  
T=525.041  
L=1050.00'

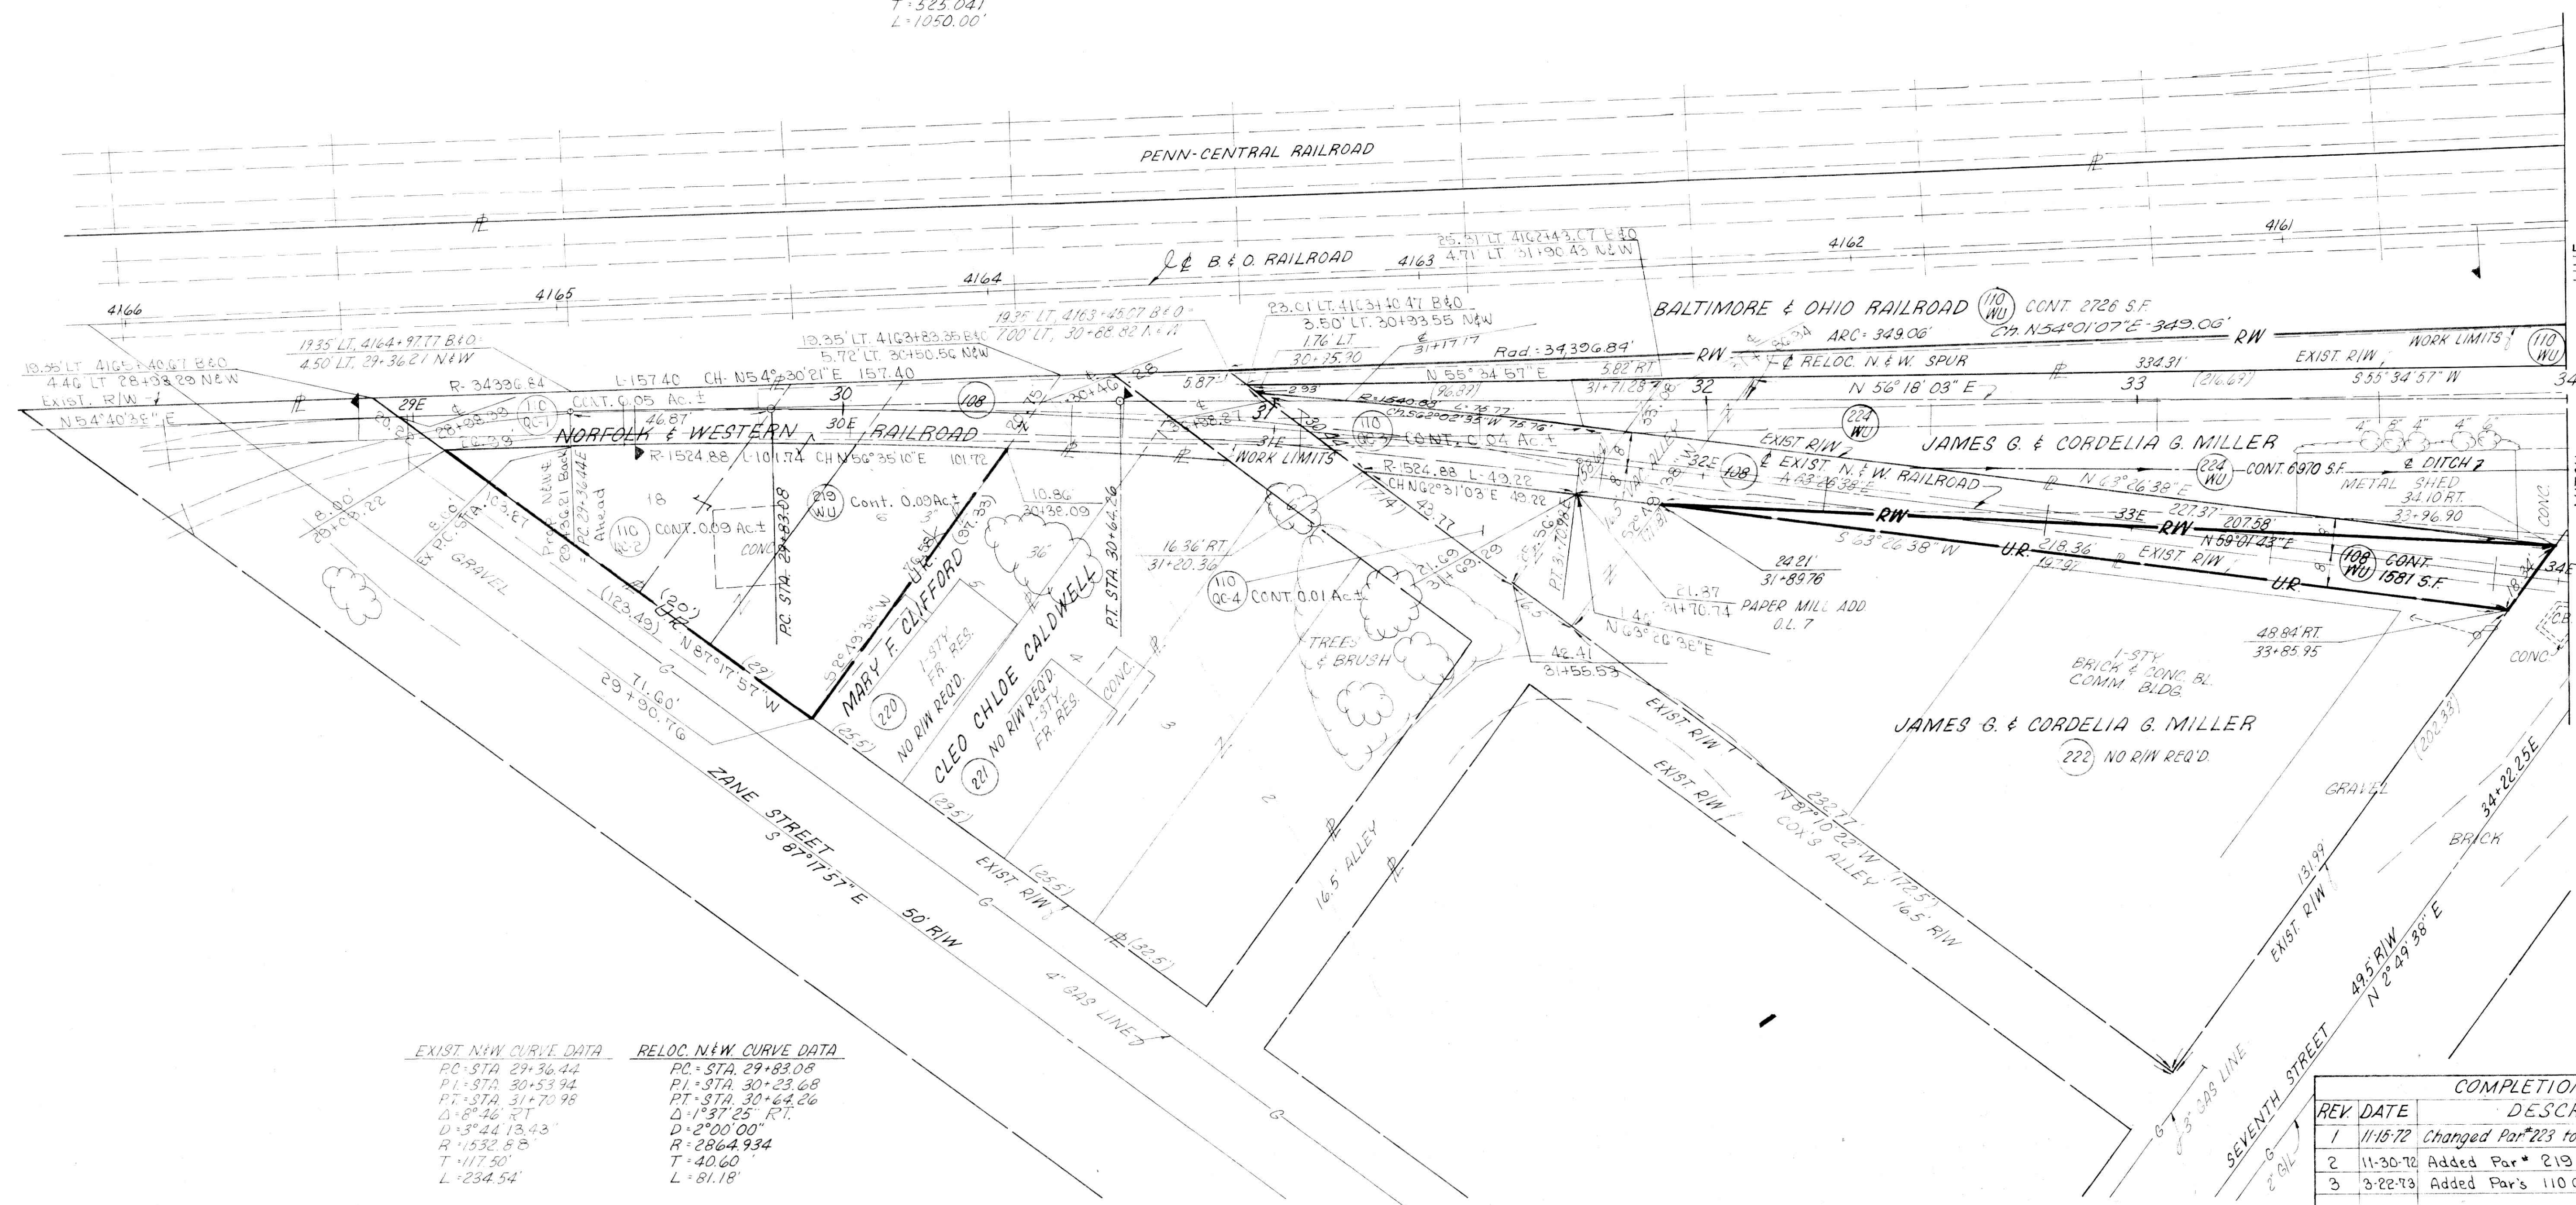

| EXIST. N.W. CURVE DATA | RELOC. N.W. CURVE DATA |
|------------------------|------------------------|
| P.C. STA 29+36.44      | P.C. STA 29+83.08      |
| P.I. STA 30+53.94      | P.I. STA 30+23.68      |
| P.T. STA 31+70.98      | P.T. STA 30+64.26      |
| Δ=8°26' RT             | Δ=1°37'25" RT          |
| D=3°24'13.43"          | D=2°00'00"             |
| R=1532.88              | R=2864.934             |
| T=117.50'              | T=40.60'               |
| L=234.54'              | L=81.18'               |

CITY OF ZANESVILLE, WASHINGTON TWP, T-1-N, R-7-W

| REV | DATE     | DESCRIPTION                  | FUND |
|-----|----------|------------------------------|------|
| 1   | 11-15-72 | Changed Par* 223 to Par* 108 |      |
| 2   | 11-30-72 | Added Par* 219 WU            |      |
| 3   | 3-22-73  | Added Par's 110 QC-1 thru 4  |      |

RELOC. N.W. SPUR STA. 28+00 TO STA. 34+00 RIW