


PROPERTY MAP

STATE JOB NUMBER	FED. RD. DIVISION	STATE	PROJECT
05431(0)	5	OHIO	F-44(14)

MUSKINGUM COUNTY
FALLS TOWNSHIP
CITY OF ZANESVILLE
MUS-60-20.57 MAPLE AVENUE



UTILITIES			
Telephone	Ohio Bell Telephone 840 Orchard Street Zanesville, Ohio 43701	Water	City of Zanesville 1084 R. Central Avenue Zanesville, Ohio 43701
Electric	Ohio Power Company Sixth and Main Zanesville, Ohio 43701	Water	East Muskingum Water Authority 3100 East Pike Zanesville, Ohio 43701
Gas	Columbia Gas of Ohio 59 North 4th Street Zanesville, Ohio 43701	Sanitary	Muskingum Co. Sanitary Engineer Muskingum County Courthouse Zanesville, Ohio 43701
		Storm	City of Zanesville 1084 R. Central Avenue Zanesville, Ohio 43701

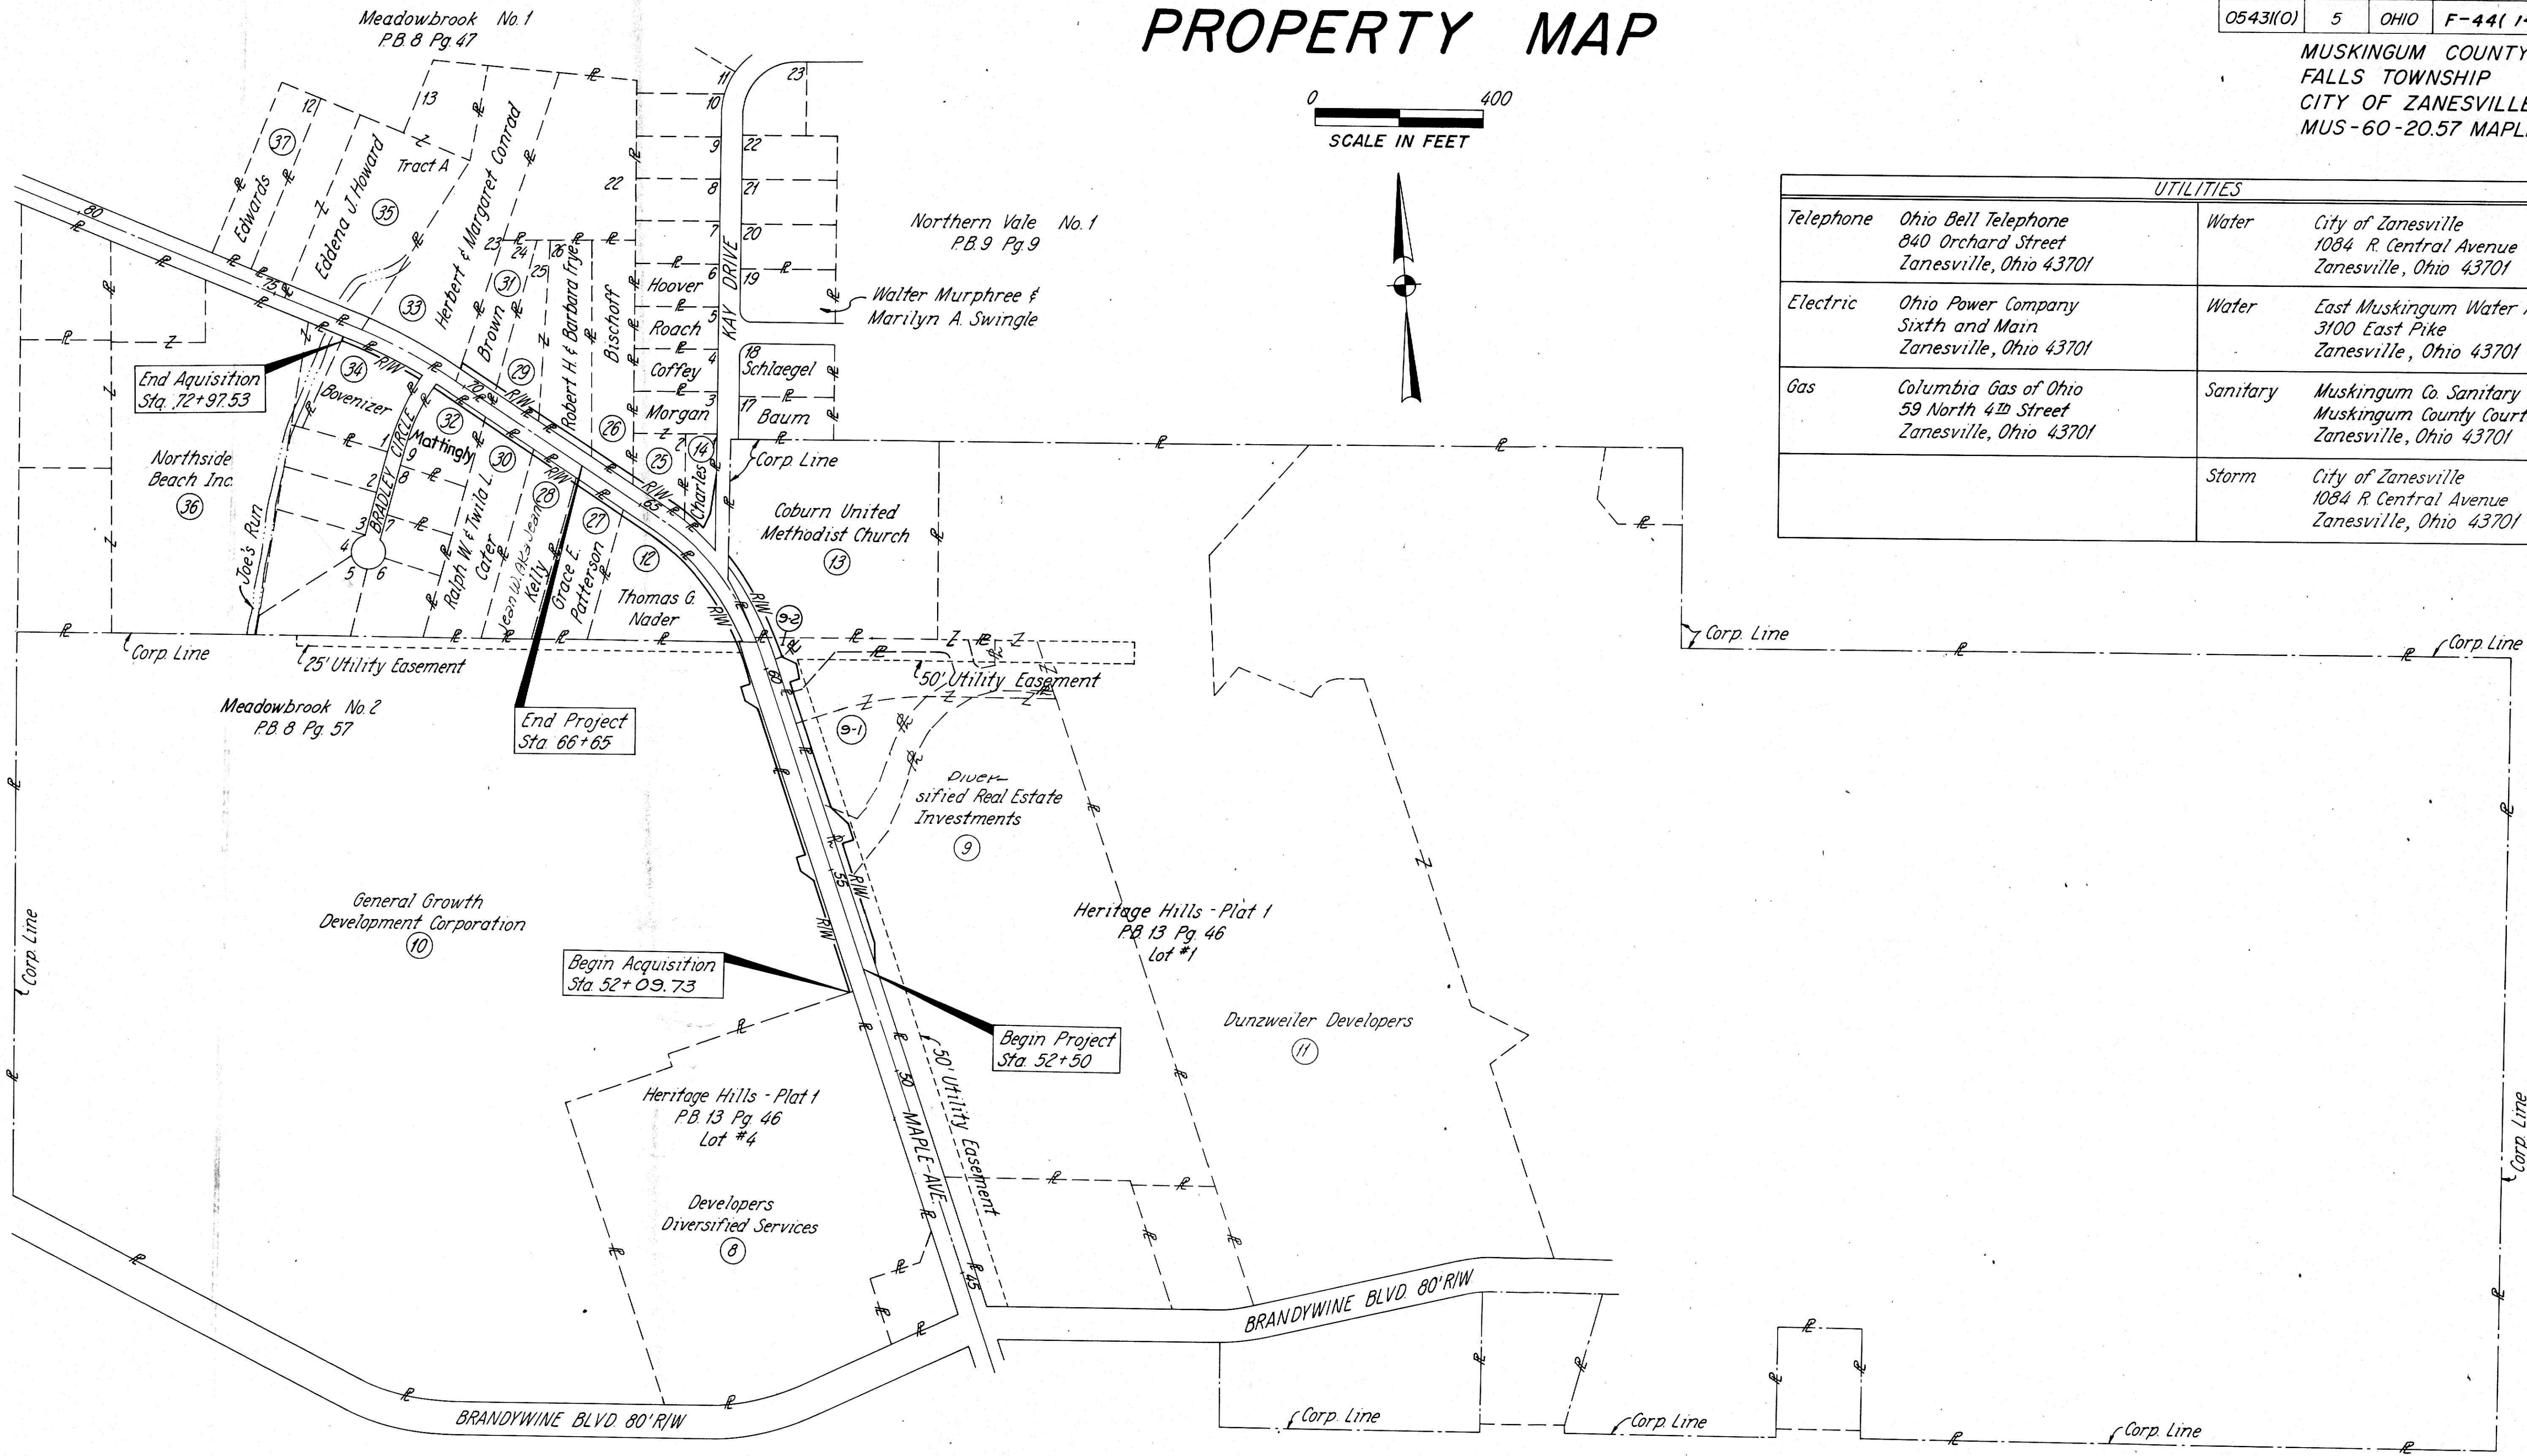

MUSKINGUM COUNTY, FALLS TWP, QUARTER 1, TOWNSHIP 1, RANGE 8

TYPE FUNDS.....F			
COMPLETION DATE 6-16-80			
REV	DATE	DESCRIPTION	FUND
1	5/22/80	Par 9 & 11 Revised; Par 9-1 Added	
2	6/16/81	Par 9, 9-1 & 11 Revised; Par 9-2 Added	

5-60