


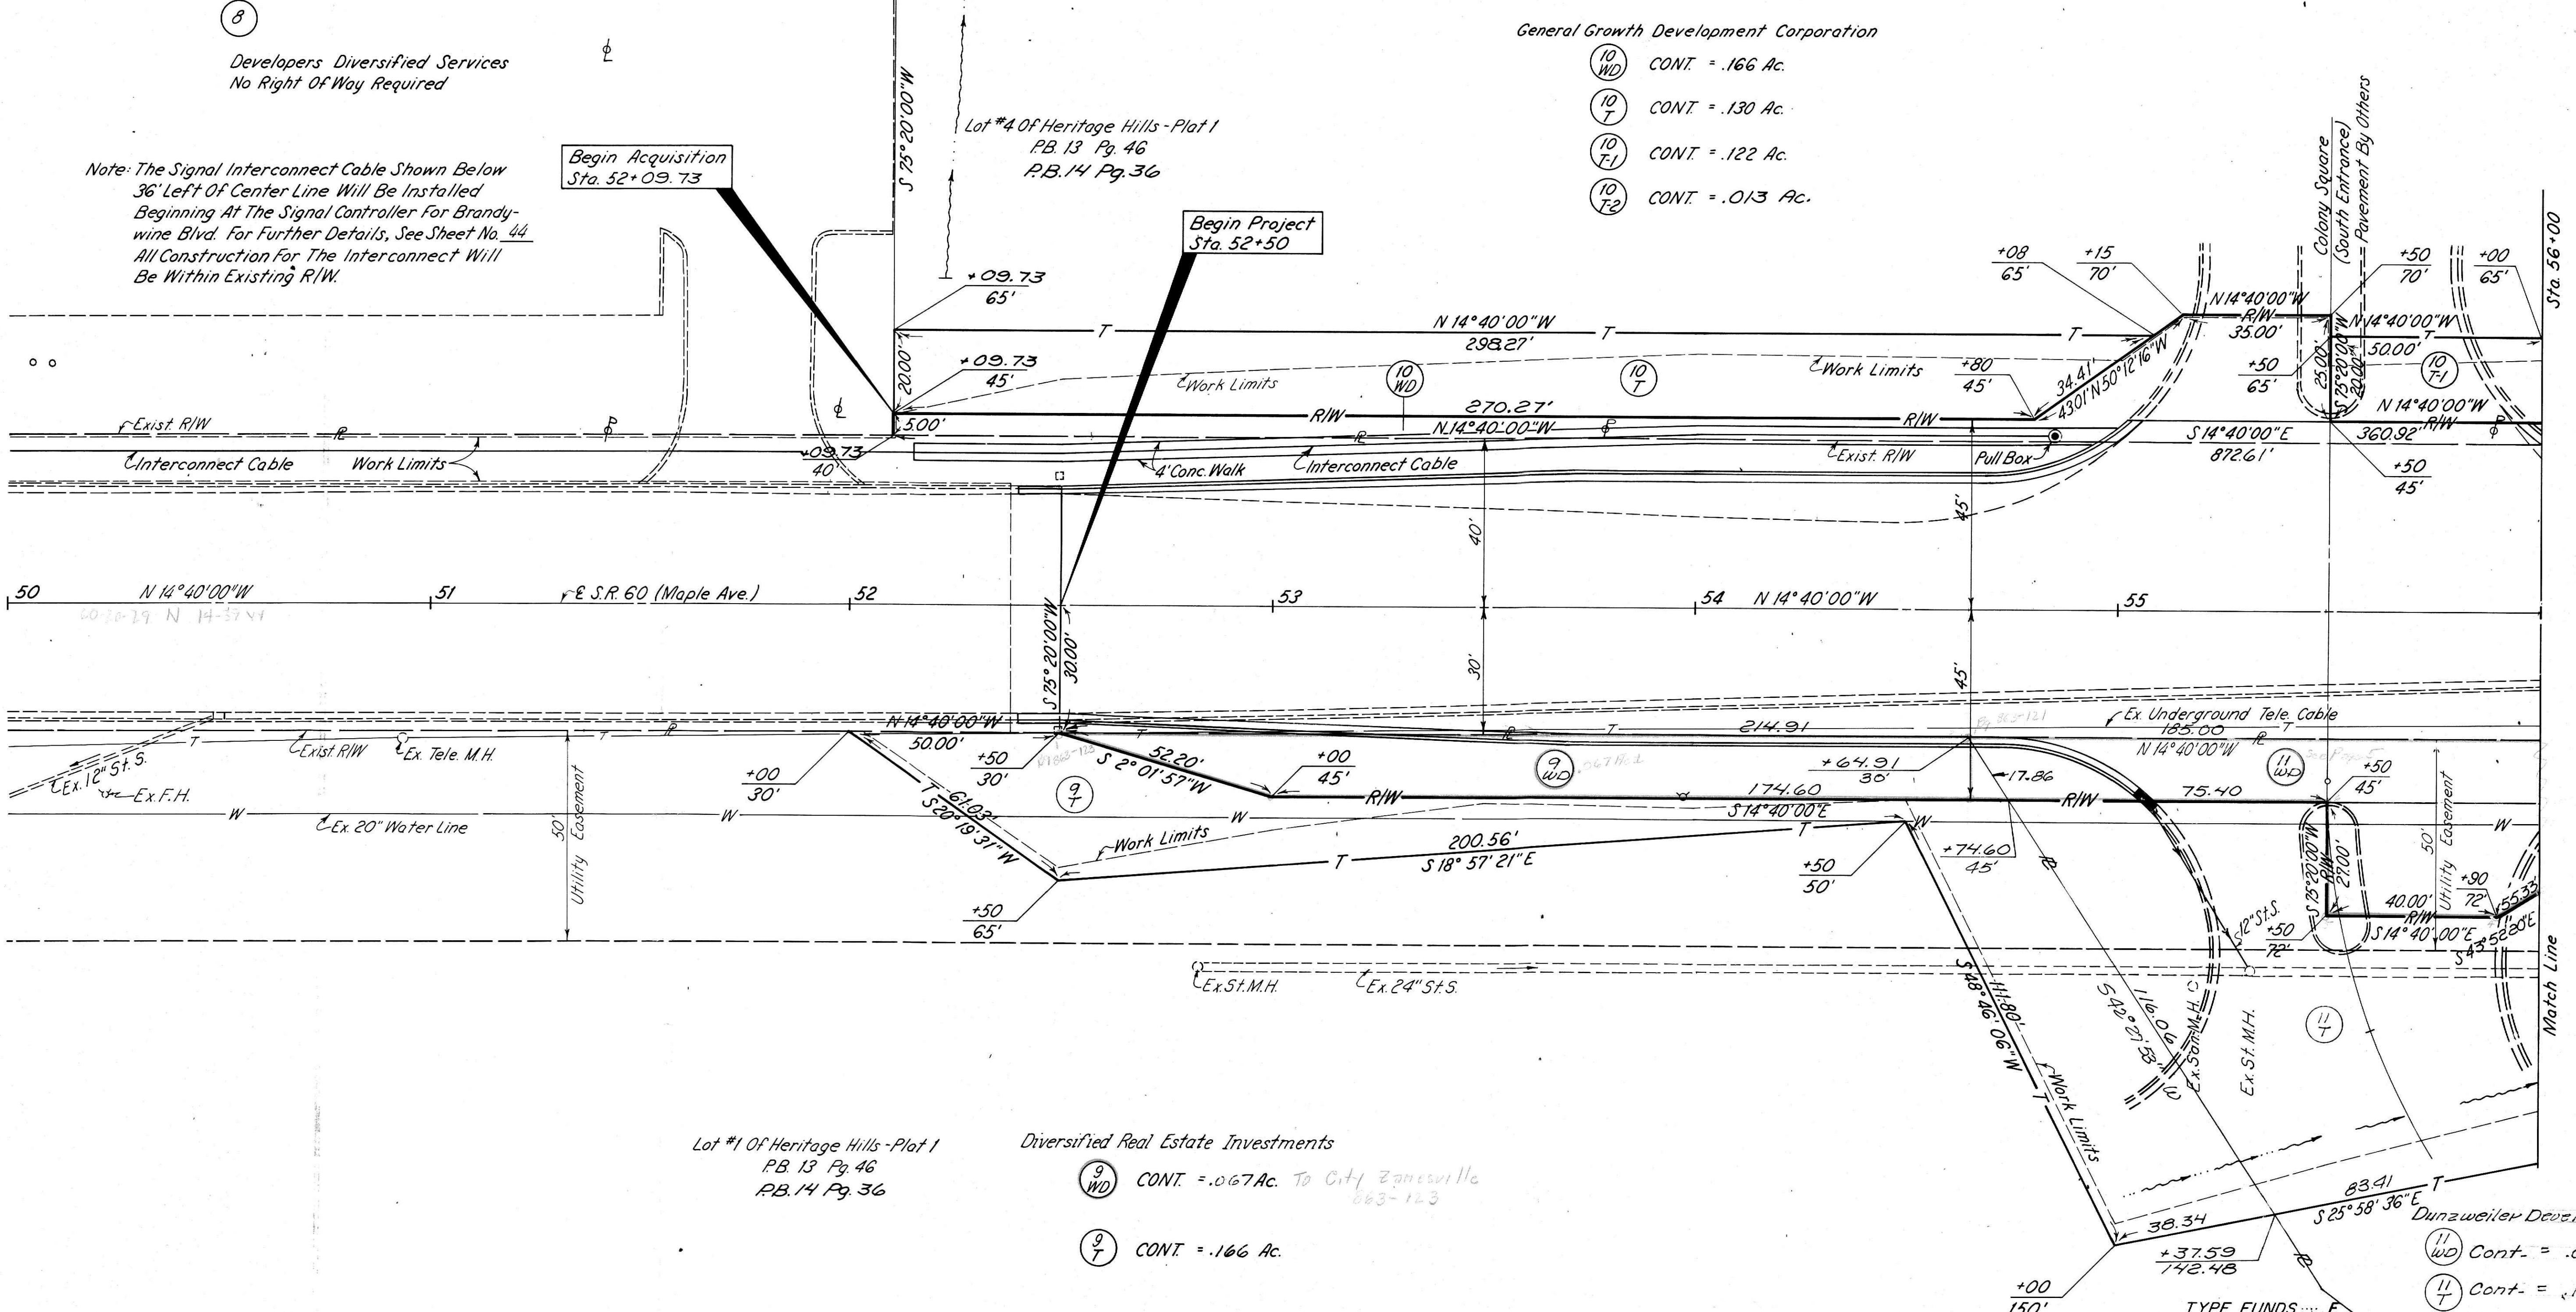

8
Developers Diversified Services
No Right Of Way Required

Note: The Signal Interconnect Cable Shown Below
36' Left Of Center Line Will Be Installed
Beginning At The Signal Controller For Brandy-
wine Blvd. For Further Details, See Sheet No. 44
All Construction For The Interconnect Will
Be Within Existing R/W.

Begin Acquisition
Sta. 52+09.73

Begin Project
Sta. 52+50

- General Growth Development Corporation
- 10 WD CONT. = .166 Ac.
 - 10 T CONT. = .130 Ac.
 - 10 T1 CONT. = .122 Ac.
 - 10 T2 CONT. = .013 Ac.

Lot #1 Of Heritage Hills-Plat 1
PB 13 Pg 46
PB 14 Pg 36

- Diversified Real Estate Investments
- 9 WD CONT. = .067 Ac. To City Zanesville 063-123
 - 9 T CONT. = .166 Ac.

TYPE FUNDS ... F			COMPLETION DATE ... 6-16-80	
REV.	DATE	DESCRIPTION		
1	5 Dec 80	Per 9WD 9T, 11WD & 11T Revised		
"	"	Per 9WD-1, 9T-1 Added		
2	6 Mar 81	Per 9WD, 9T, 10WD, 10T, 11WD, 11T Rev		