

Proposed R/W And Construction,
Maple Avenue Curve Data
 $\Delta = 37^{\circ}18'55''$
 $Dc = 7^{\circ}30'$
 $R = 763.94'$
 $T = 257.95'$
 $L = 497.54'$
 $E = 42.37'$
 $PC = Sta. 59+75.92$
 $PI = Sta. 62+33.87$
 $PT = Sta. 64+73.46$

Exist. R/W Maple Avenue
Curve Data
 $\Delta = 37^{\circ}18'55''$
 $Dc = 10'$ (Chord Definition)
 $R = 573.69'$
 $T = 193.71'$
 $L = 373.63'$ (Actual Arc Length)
 $E = 31.82'$
 $PC = Sta. 60+40.16$
 $PI = Sta. 62+33.87$
 $PT = Sta. 64+13.79$

STATE JOB NUMBER	F.H.W.A. DISTRICT	STATE	PROJECT	
05431(0)	5	OHIO	F-44 (14)	


MUSKINGUM COUNTY
FALLS TOWNSHIP
CITY OF ZANESVILLE
MUS-60-20.57 MAPLE AVE.
R/W PLANS 0 40

Ralph W. Cater And
Twila L. Cater
 (30 WD) CONT. = 2100 S.F.
 1 Sty. Sandstone Res.
 (30 T) CONT. = 700 S.F.

Grace E. Patterson
 (27 WD) CONT. = 1986 S.F.
 (27 T) CONT. = 993 S.F.

Jean W. Kelly AKA
Jean Kelly
 (28 WD) CONT. = 1800 S.F.
 (28 T) CONT. = 972 S.F.

Thomas G. Nader
 (12 WD) CONT. = .201 Ac.
 (12 T) CONT. = .045 Ac.

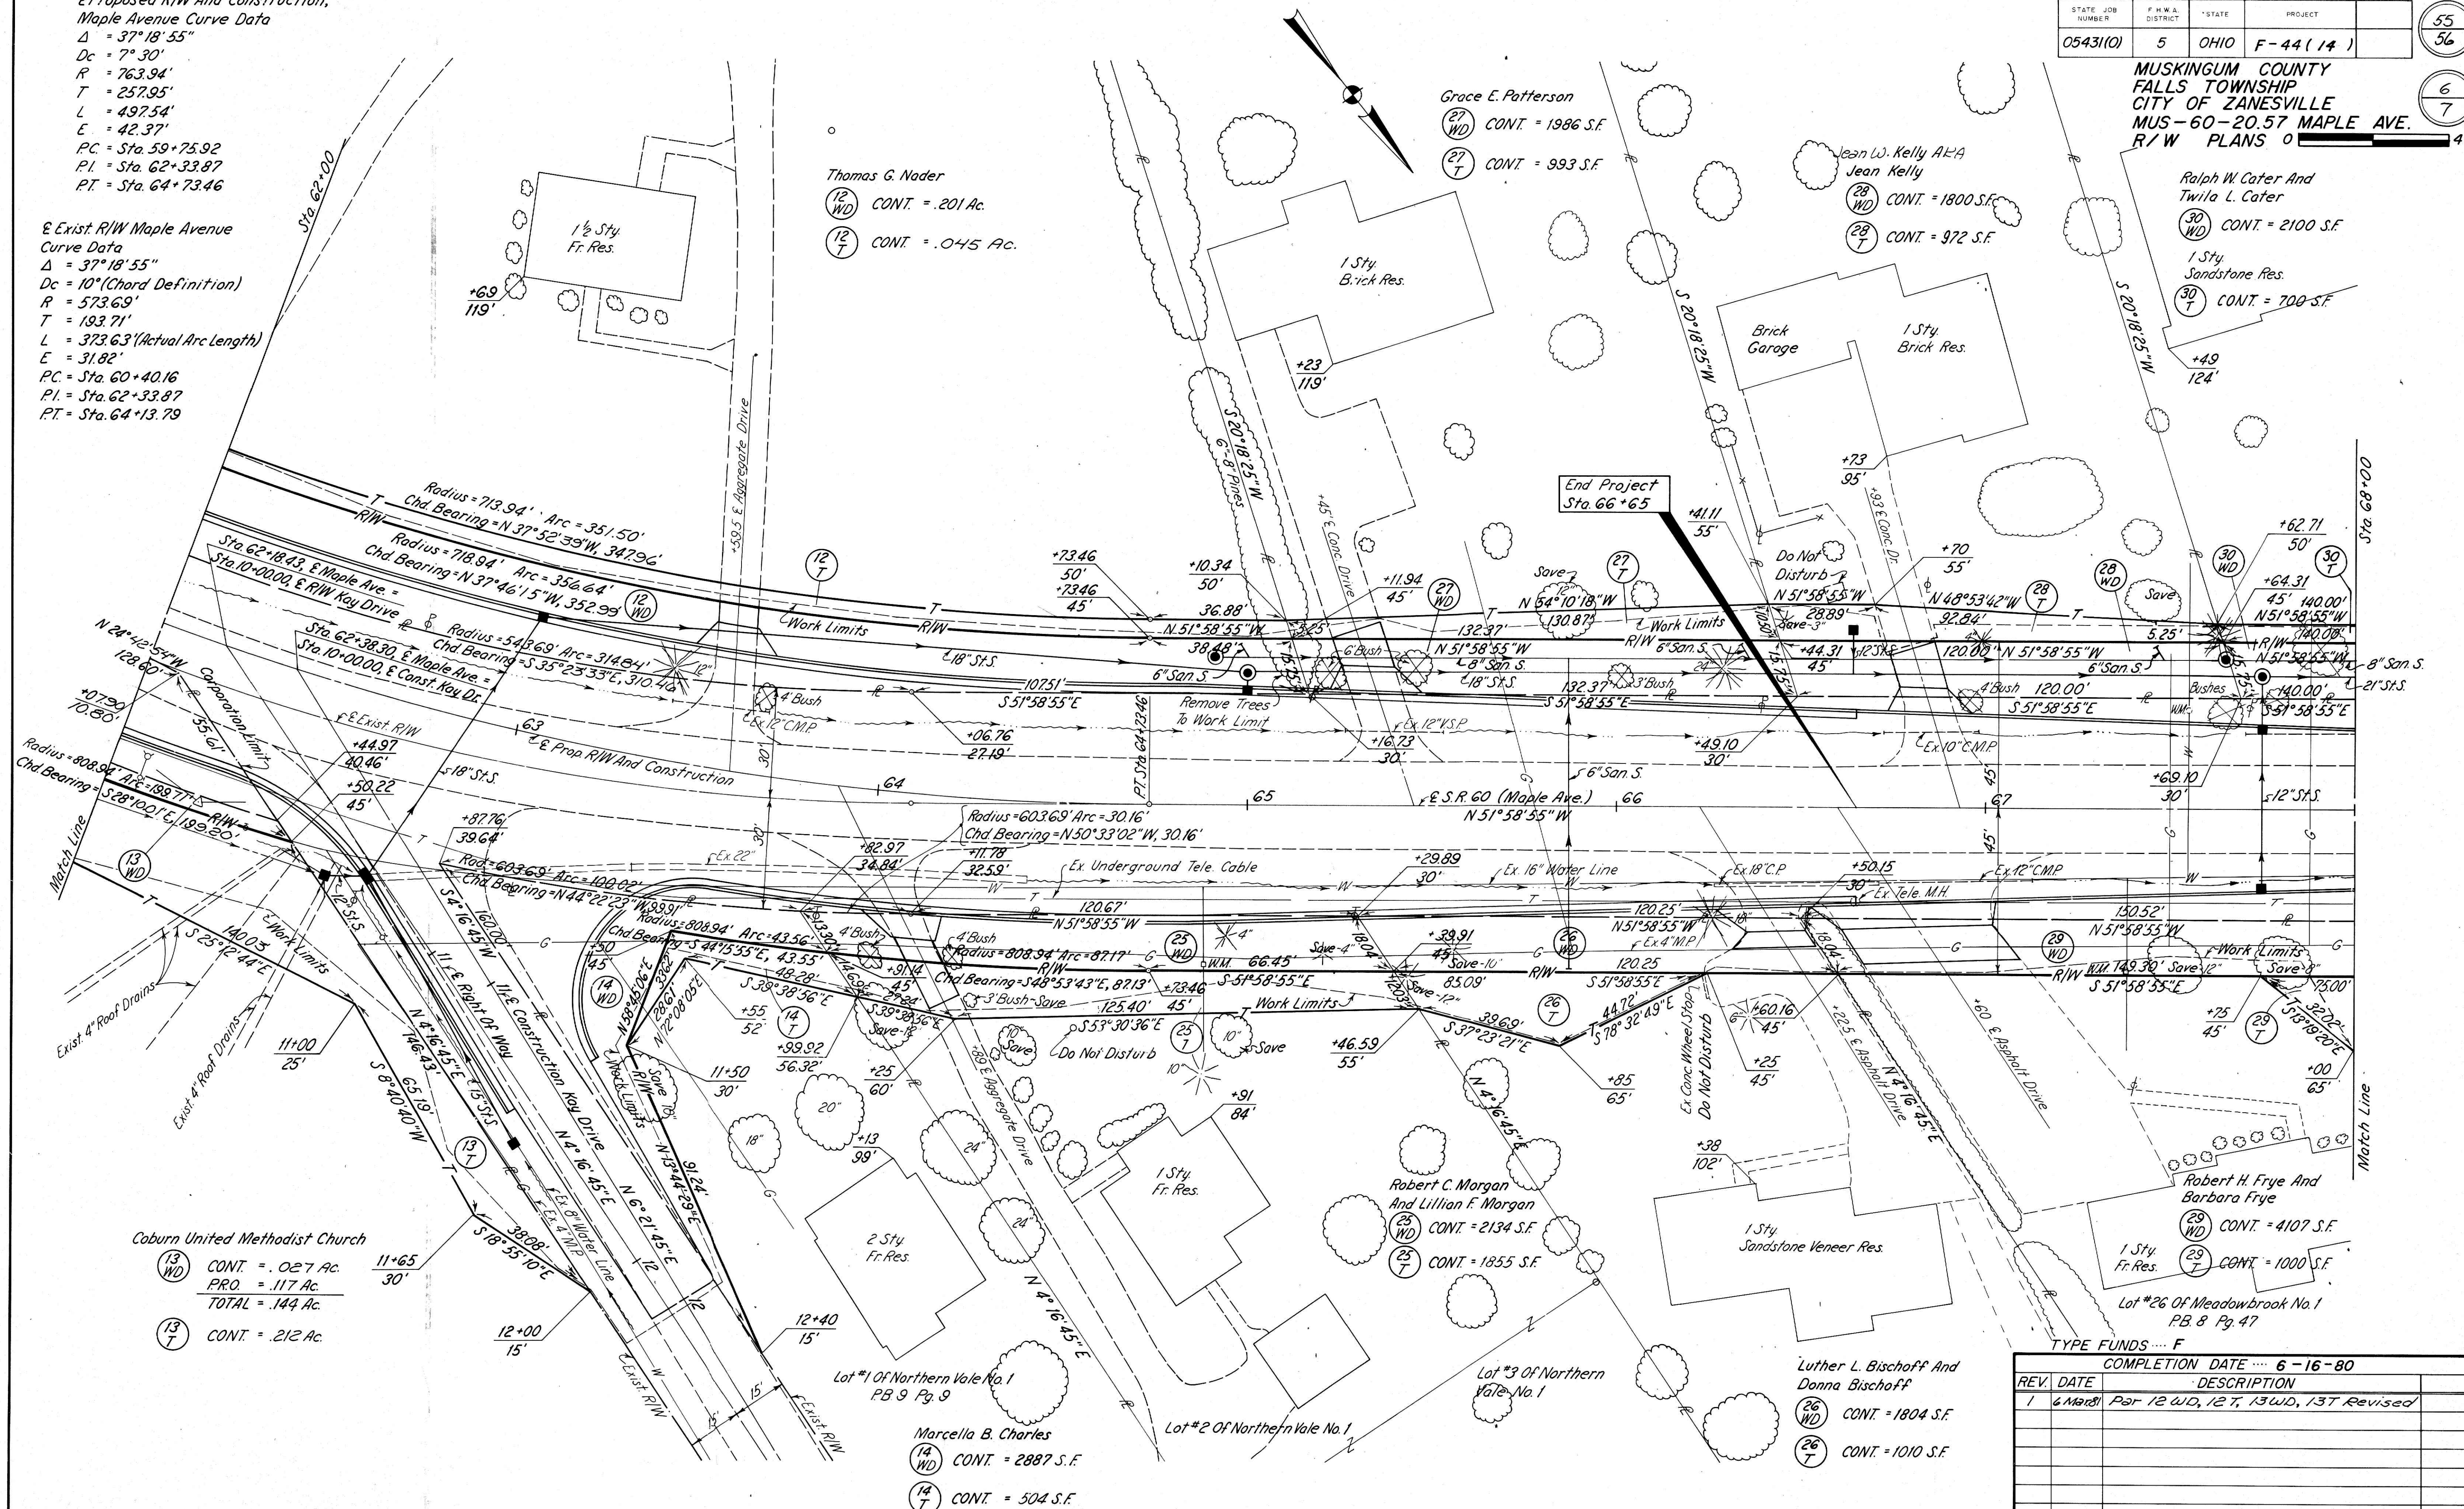

Coburn United Methodist Church
 (13 WD) CONT. = .027 Ac.
 PRO. = .117 Ac.
 TOTAL = .144 Ac.
 (13 T) CONT. = .212 Ac.

Lot #1 Of Northern Vale No. 1
PB. 9 Pg. 9
 Marcella B. Charles
 (14 WD) CONT. = 2887 S.F.
 (14 T) CONT. = 504 S.F.

Robert C. Morgan
And Lillian F. Morgan
 (25 WD) CONT. = 2134 S.F.
 (25 T) CONT. = 1855 S.F.

Luther L. Bischoff And
Donna Bischoff
 (26 WD) CONT. = 1804 S.F.
 (26 T) CONT. = 1010 S.F.

Robert H. Frye And
Barbara Frye
 (29 WD) CONT. = 4107 S.F.
 (29 T) CONT. = 1000 S.F.
 Lot #26 Of Meadowbrook No. 1
PB. 8 Pg. 47

TYPE FUNDS F			COMPLETION DATE 6-16-80	
REV.	DATE	DESCRIPTION		
1	6 Mar 81	Per 12 WD, 12 T, 13 WD, 13 T Revised		