

MADINGER ALLOTMENT



5
Ralph L & Jessie E Boal
(36) WA

4
C.R. & Anne Peyton
(37) WA

3
Julia Madinger Hayes & Keith B Hayes
(39) WA

2
Lilly Rittberger
(41) WA

1
Stanley & Lillian Pavlock
(43) WA

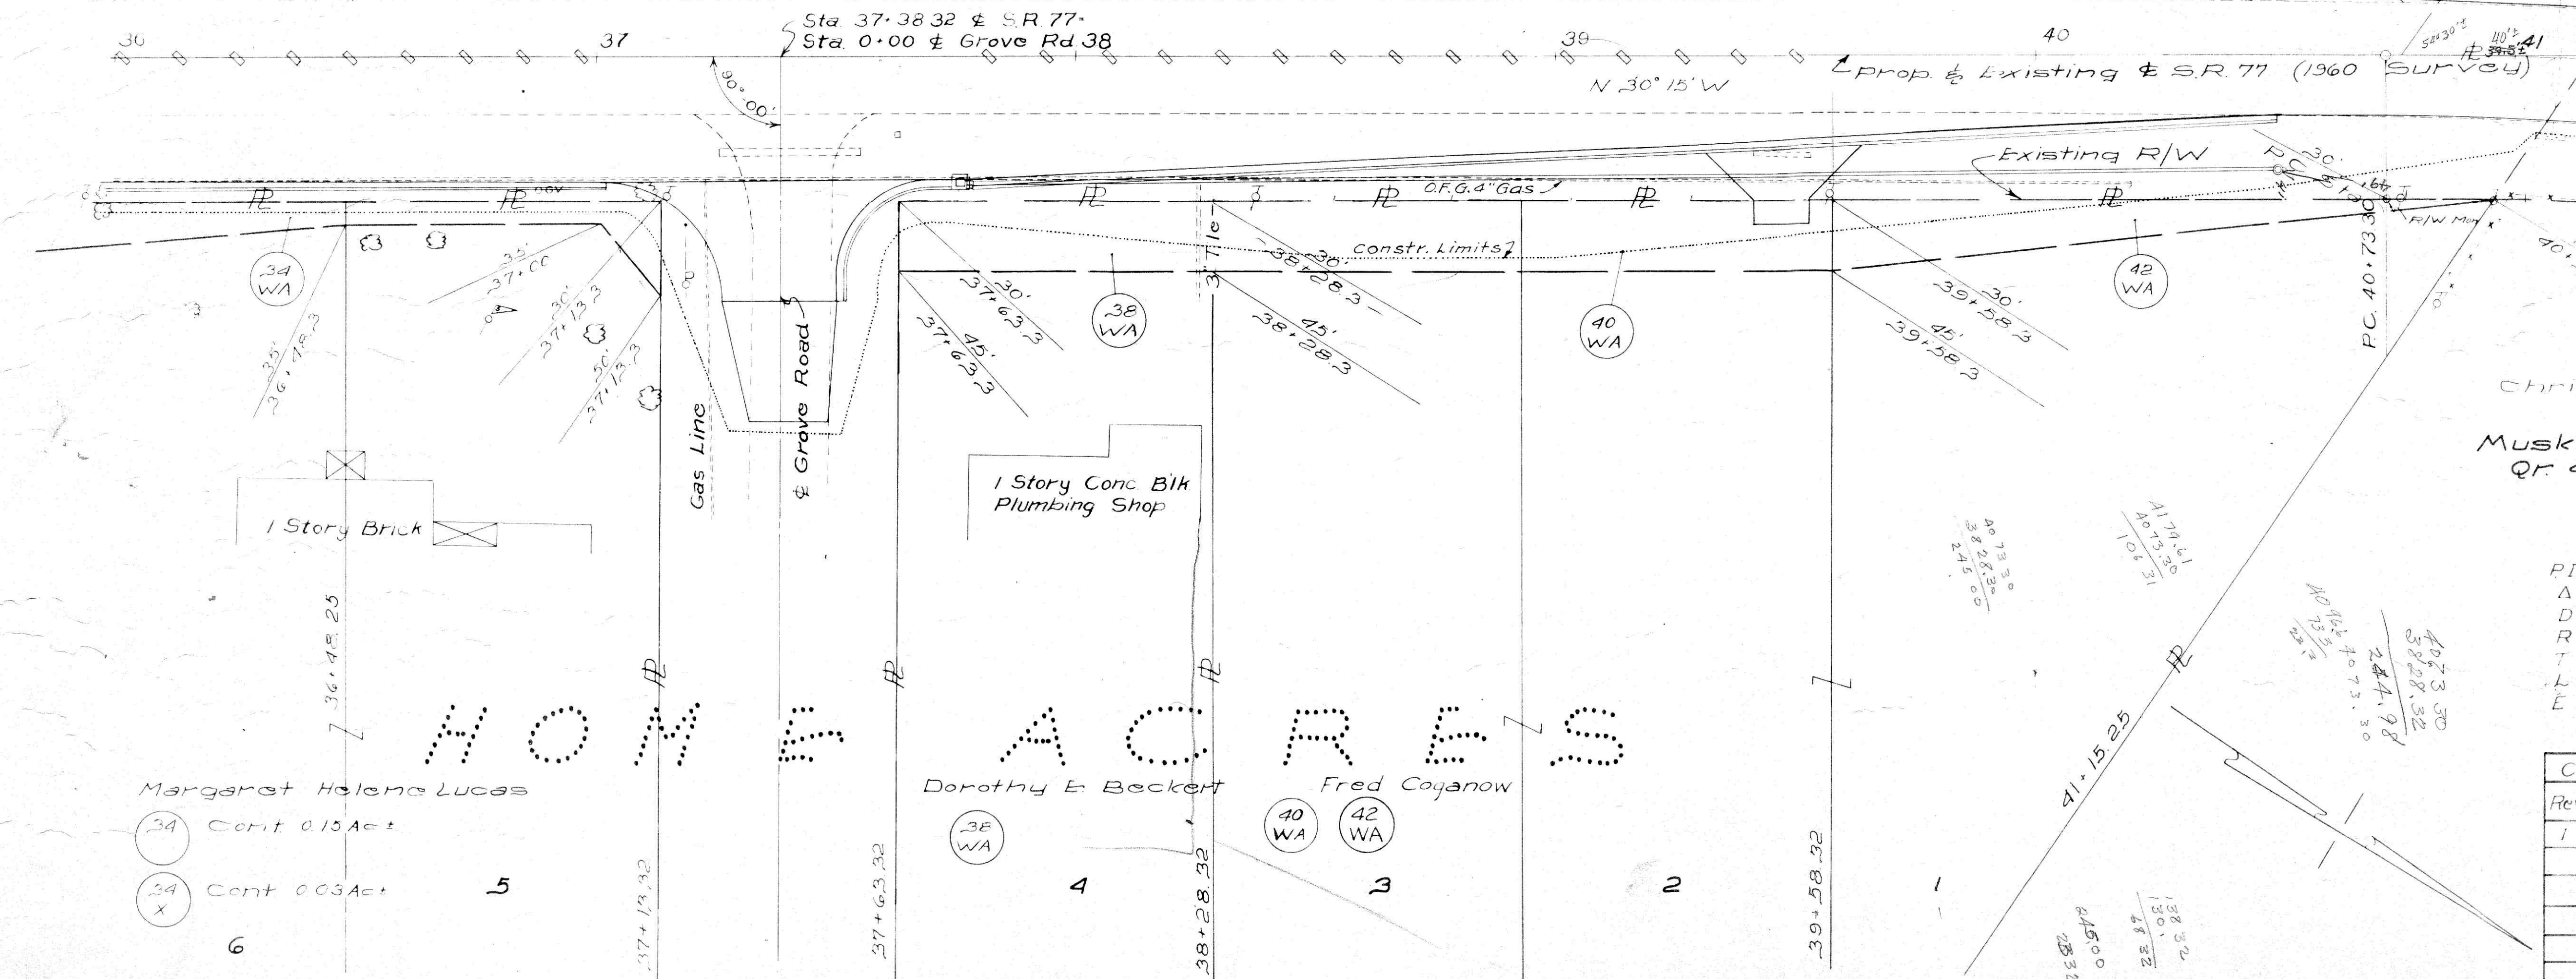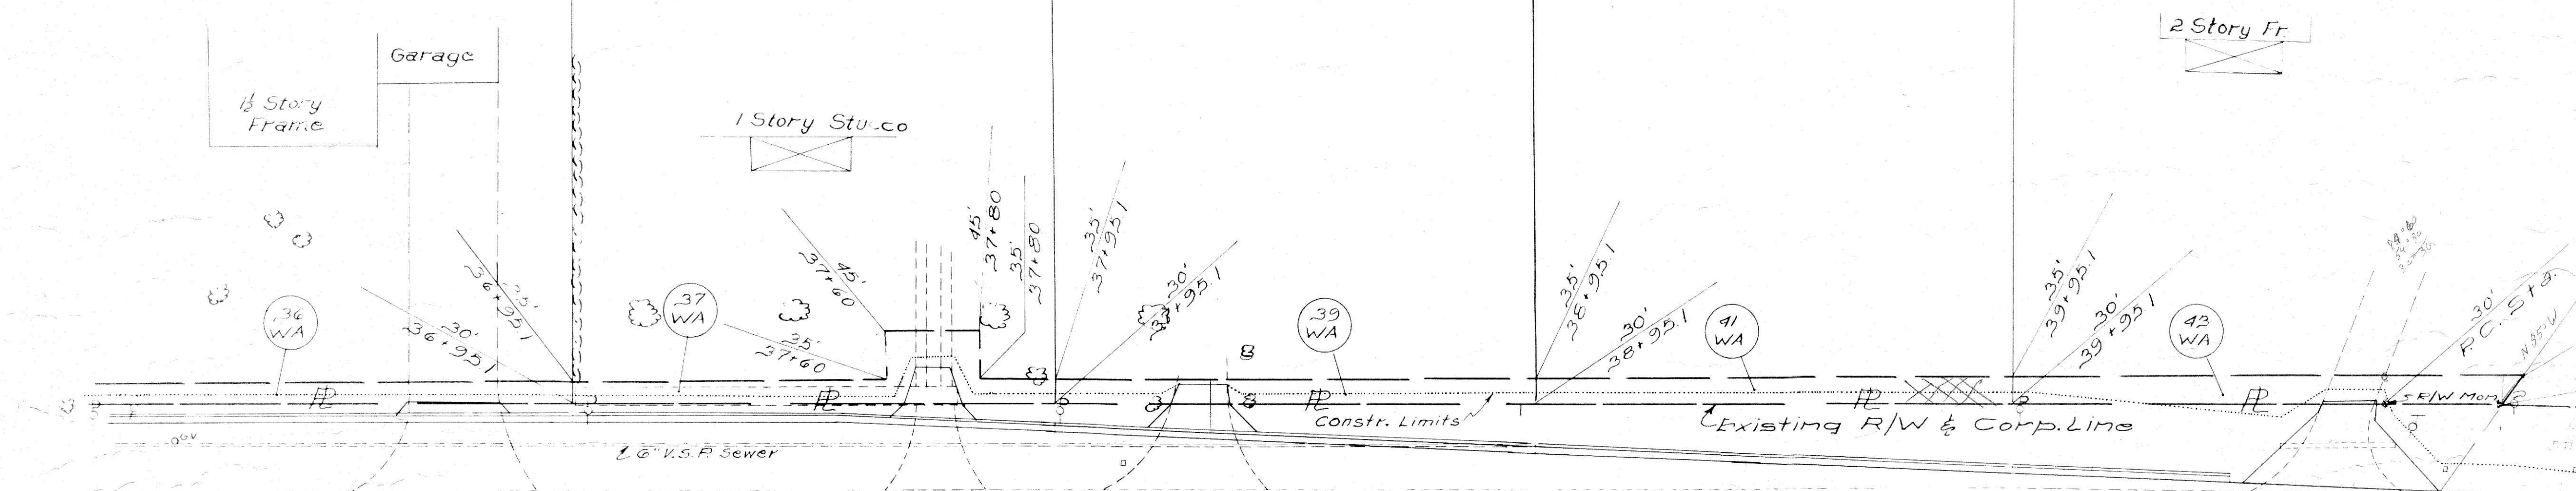

Christopher J. Mattingly
Muskingum County - Falls Twp.
Qr. 4 T. 1 R. 8 U.S.M.L.
City of Zanesville

PI = 41+79.61
Δ = 15° 34' Rt
D = 7° 22'
R = 777.77
T = 106.31
L = 211.31
E = 7.23

Rev	Date	Description
1	8/19/60	Changed name parcels 40-WA 42-WA