

The foregoing survey of road was made by me, on the 27th & 28th December last under the superintendance & direction of Lewis Spang & John Shutt viewers (present) in pursuance of an order of the Commissioners of Washington county, issued at their session in December last. Give under my hand this 15th Jan^y 1842.

William Anderson

Confirmed by the Commissioners at their December session 1842.

Wm. H. Jones
Wm. H. Jones Alteration of county road leading from Margando's Mill to Peter Bonds.

The undersigned having been appointed by the Commissioners of Washington county their March session to view a proposed alteration in the county road leading from Margando's Mill to Peter Bonds, which alteration was prayed for by Andrew W. Henderson and others; met first on the 1st day of April 1842, and after being duly sworn, proceeded with the assistance of W. R. Bond, surveyor, to view and lay out said alteration according to the plat & notes of said survey, herewith returned, and are fully of opinion that said alteration ought to be granted, both because the ground is better for a road upon the alteration, and because the alteration is nearly level, while the old road is very hilly, and because the proposed alteration is found by measurement to be two chains & sixty three links shorter than the old route. All of which I respectfully submitted, on this 1st day of April 1842.

James Garred
 Ephraim Hancock
 Jacob Shively

By the County Commissioners of Washington County, Ohio.


Survey of A. R. Henderson's Alteration of road agreeably to an order of the Commissioners of Washington county, Ohio, made at their March session 1842.

Field Notes

- 1 S. 39° W. 2.61 chained to a stake
- 2 S. 58° W. 4.00 "
- 3 S. 28½° W. 2.79 "
- 4 S. 64° W. 9.31 "
- 5 S. ½° E. 13.95 " to a tree
- 6 S. 4½° W. 13.60 " to a small ash tree

Notes Distances 46.26 ^{near the head of Spring in the old road}

Notes Distances of the old road, 45.89 chs.

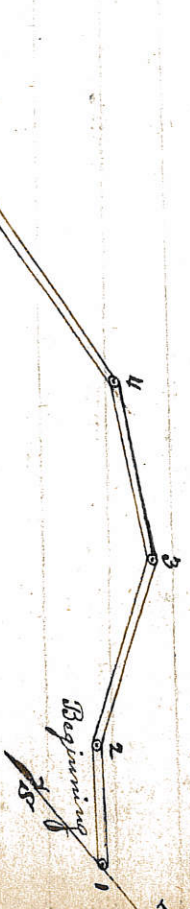

I certify that the accompanying Plat and field notes are correct.

Done 1st A. R. 1842.

W. R. Bond,
 Surveyor