

Monroe Twp

Arthur Hamilton's Addition

SURVEYOR'S REPORT.


To the Board of Commissioners of Muskingum County, Ohio:

The undersigned, in obedience to your order dated Jan 1875, proceeded, on the 23-24 day of August-1875 to survey and mark the Arthur Hamilton's Addition described in said order, under the direction of the viewers therein named, and respectfully submits the following return of said survey:

Beginning in the Survey of Oleg in said County at the intersection of Hamilton road thence as per the following field notes

Field Notes

Line	Course	Angle	Remarks
1	N 31° E	3 13	At center Hamilton road
2	N 17° E	3 93	along state road
3	N 21° E	28 40	"
4	N 30° W	11 75	Gas Palmer's land
5	N 30° W	11 00	Perimeter line
6	N 41° W	4 23	Range line
7	N 28° W	2 20	West side
8	N 32° W	1 06	"
9	N 39° W	4 28	"
10	N 22° W	1 06	"
11	N 12° W	1 00	.50 broad ravine
12	N 11° W	1 00	159 to ravine
13	N 15° W	2 57	N 13 to 307.1 mile post
14	N 11° W	4 73	200 to ravine
15	N 7° W	3 75	Clark's line & Hamilton line
16	N 13° W	9 17	x 150 to ravine opposite house
17	N 11° W	5 52	.50 to Coal Bank
18	N 14° W	1 95	"
19	N 11° W	6 00	Samuel's line
20	N 8° W	2 50	South side ravine
21	N 20° W	1 25	"
22	N 20° W	1 75	"
23	N 16° W	3 55	"
24	N 19° W	2 00	"
25	N 2° W	2 70	"
26	N 1° E	1 23	"
27	N 4° W	3 50	Along Hamilton line
28	N 6° W	3 90	Opposite Hamilton house
29	N 5° W	2 33	"
30	N 1° E	2 63	"
31	N 25° E	2 50	"
32	N 52° E	4 20	"
33	N 32° E	1 95	"
34	N 13° W	2 43	"
35	N 7° E	2 72	"
36	N 15° E	1 30	"
37	N 28° E	2 00	"
38	N 29° E	2 20	"
39	N 1° E	2 59	"
40	N 11° W	9 00	10 + 2.12 2 mile post
41	N 47° W	7 68	County Road
42	N 49° W	5 44	"
43	N 47° W	2 00	"
44	N 55° W	1 04	Jan. Hamilton line
45	N 63° W	1 37	"
46	N 32° W	4 38	To County line
47	N 13° W	9 85	"
199 45			= 2 miles and 39.50 chains

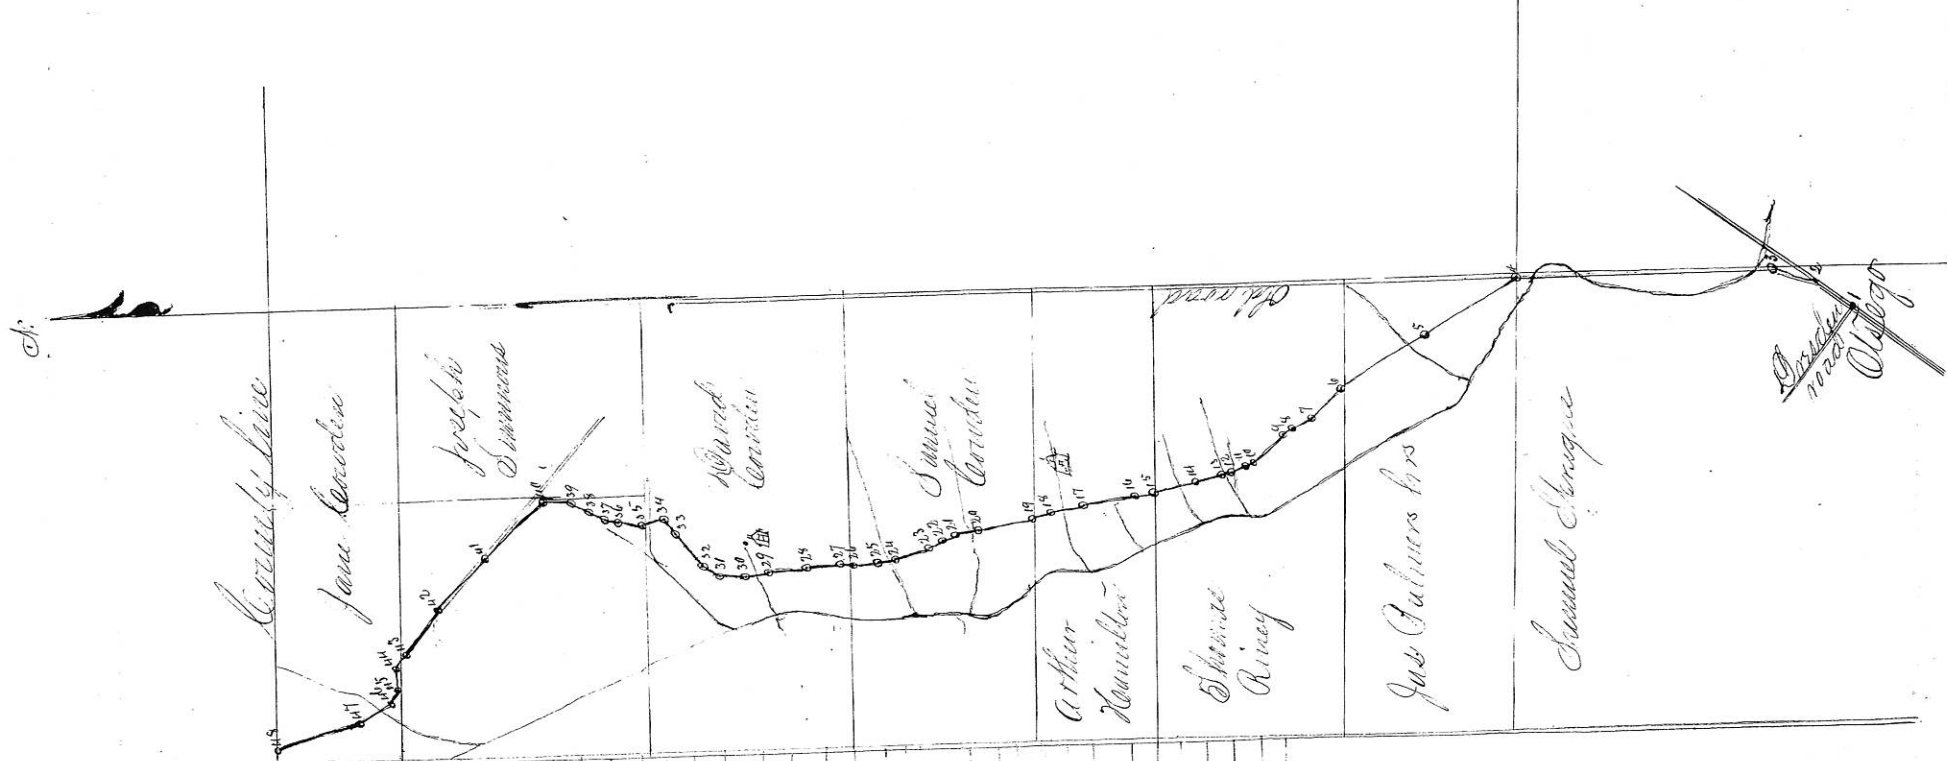

I Certify that the above is a correct plat and return of the survey of the Arthur Hamilton's Addition named above

A. P. O'Connell

Surveyor

REPORT OF VIEWERS.

Surveyor's Report Record
p. 15

the Board of Commissioners of Muskingum County, Ohio:

In obedience to your order, issued at your June session, A. D. 1873, we, the undersigned, viewers pointed under said order, met with J. P. Cogan Surveyor, at Chillicothe on Aug. 25th 1875 and were severally sworn to discharge, faithfully and impartially, the duties required of us in said order.

W. B. Carter having failed to appear at 2 O'clock on the 25th day of Aug 1875 John Bell was appointed to fill the vacancy

John A. Jacobson and James Sprague were selected by us as chain carriers, and Frank Clark as a marker, who were also duly sworn.

We then proceeded to view said proposed County road on the line described in your order, and caused the same to be surveyed "as prayed for in the petition, or as near the same as in our opinion a good road can be made at a reasonable expense, taking into consideration the utility, convenience, and inconvenience and expense which will result to individuals as well as the public," by the Alteration of said road, as follows:

Beginning in Chillicothe and following the present graded road to the north east corner of Samuel Sprague land, thence in a north westerly direction through the lands of James Palmer hrs. Thomas Vining. Arthur Hamilton. Samuel Cowden. David Cowden. William Struble. & Joseph Simmons to County road. thence along the said road a short distance thence in a north westerly direction through the land of Mrs Jane Cowden to the County line.

We would respectfully report that the said County road ought to be established, for the following reasons: The old road as now graded passes over such high rough and stony hills that a good road cannot be had. The proposed road will lay along a valley making a reasonable straight road and reasonable grade. And that the public require a good road in that direction

We have also determined that the public convenience requires that such County road shall be established

Eighty feet in width.
All of which is respectfully submitted,
Aug 26th 1875

E. M. Spahr
W. J. Weaver
John Bell

VIEWERS

675-0258
S1A