
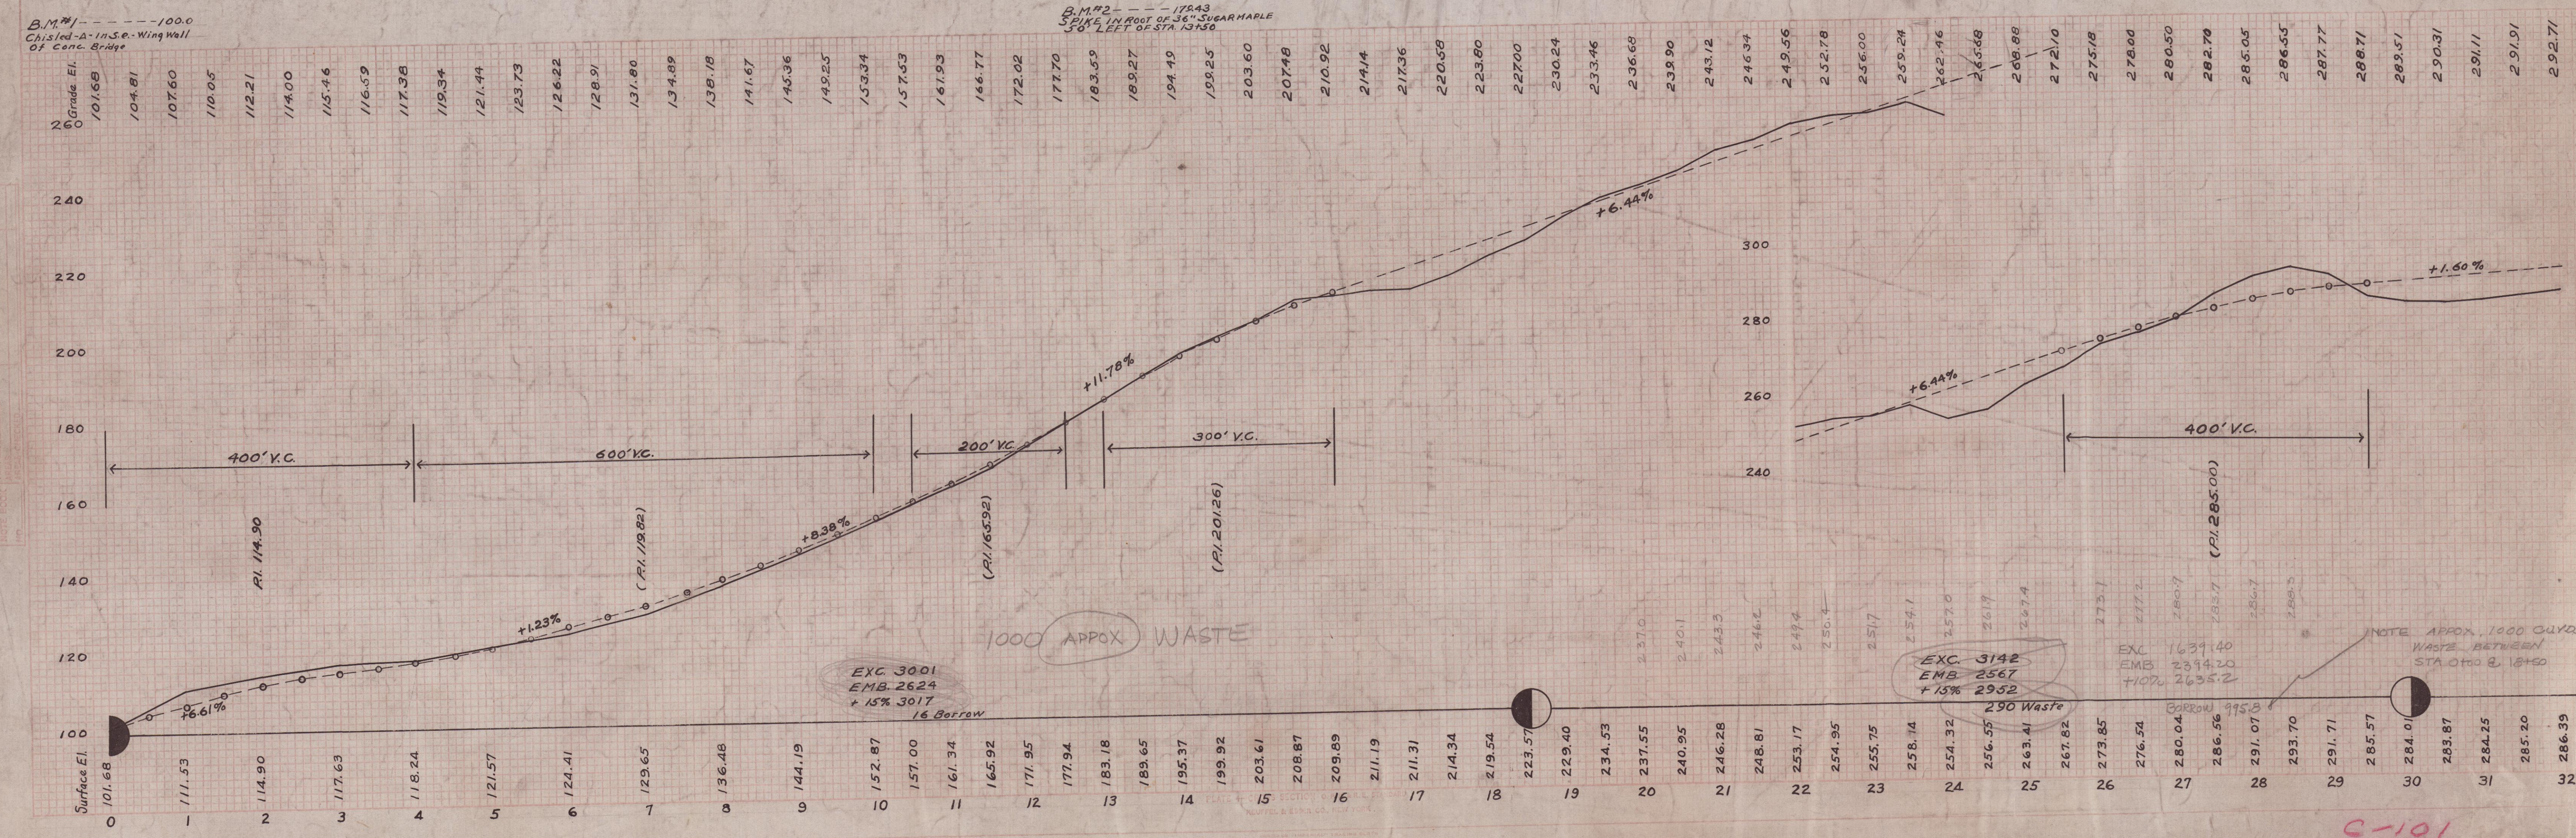


A-14

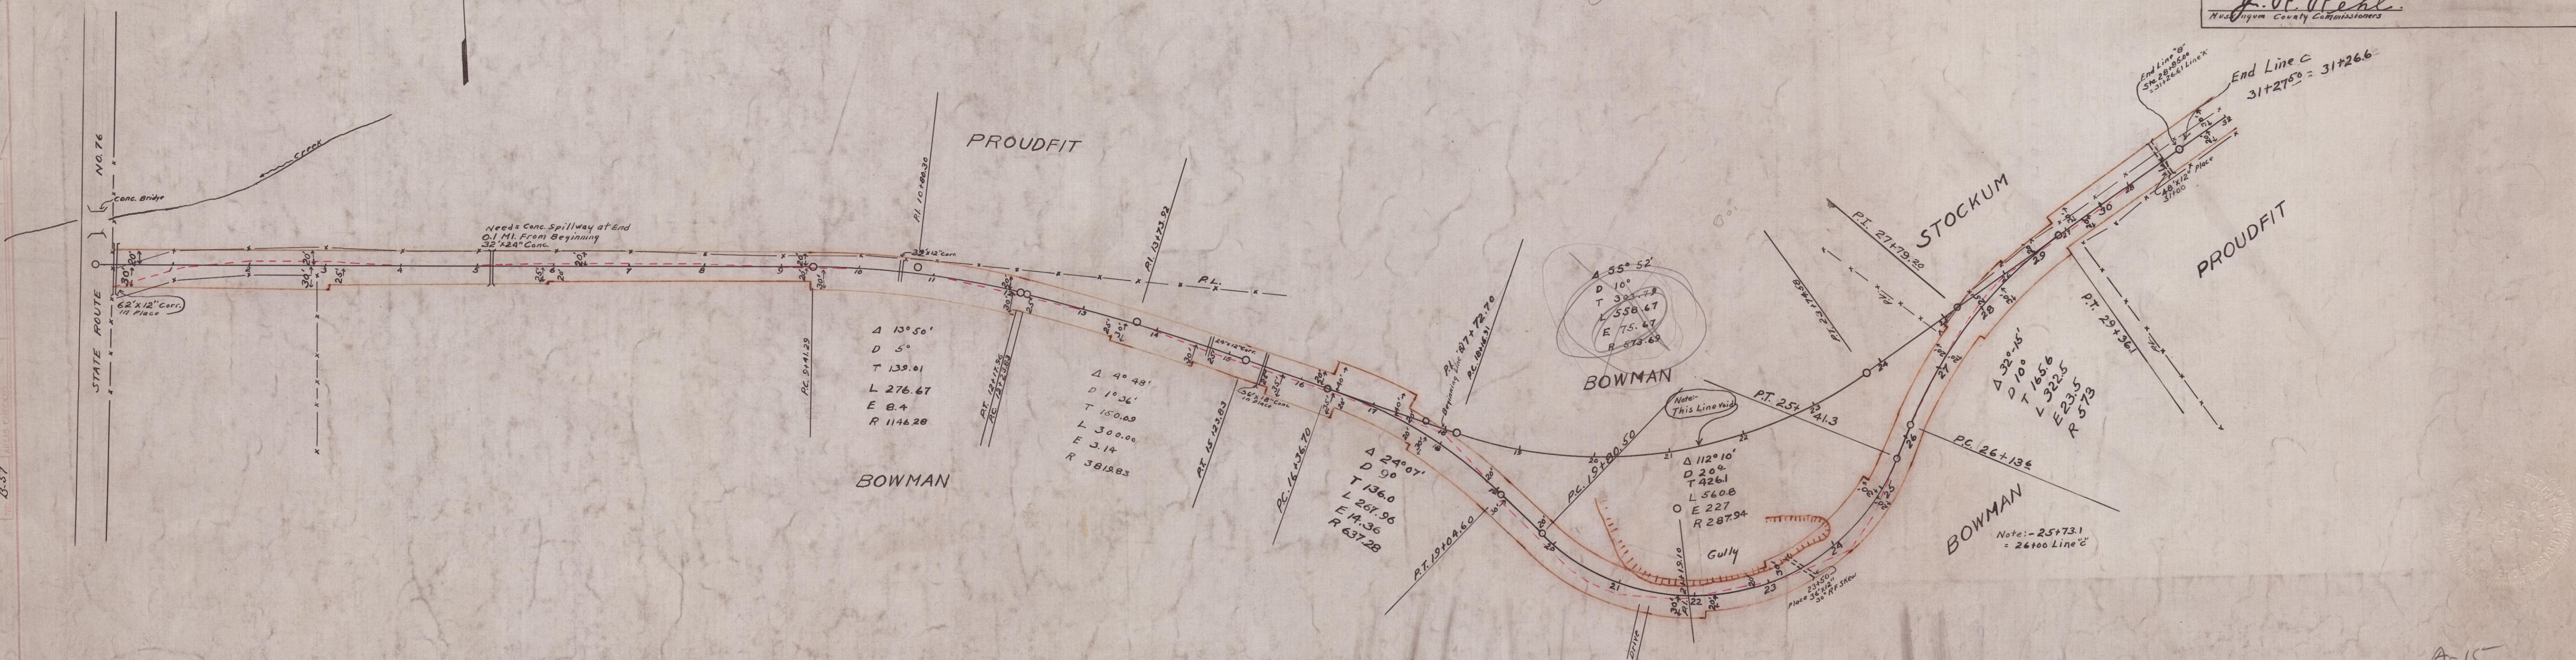

A-15

C-101