


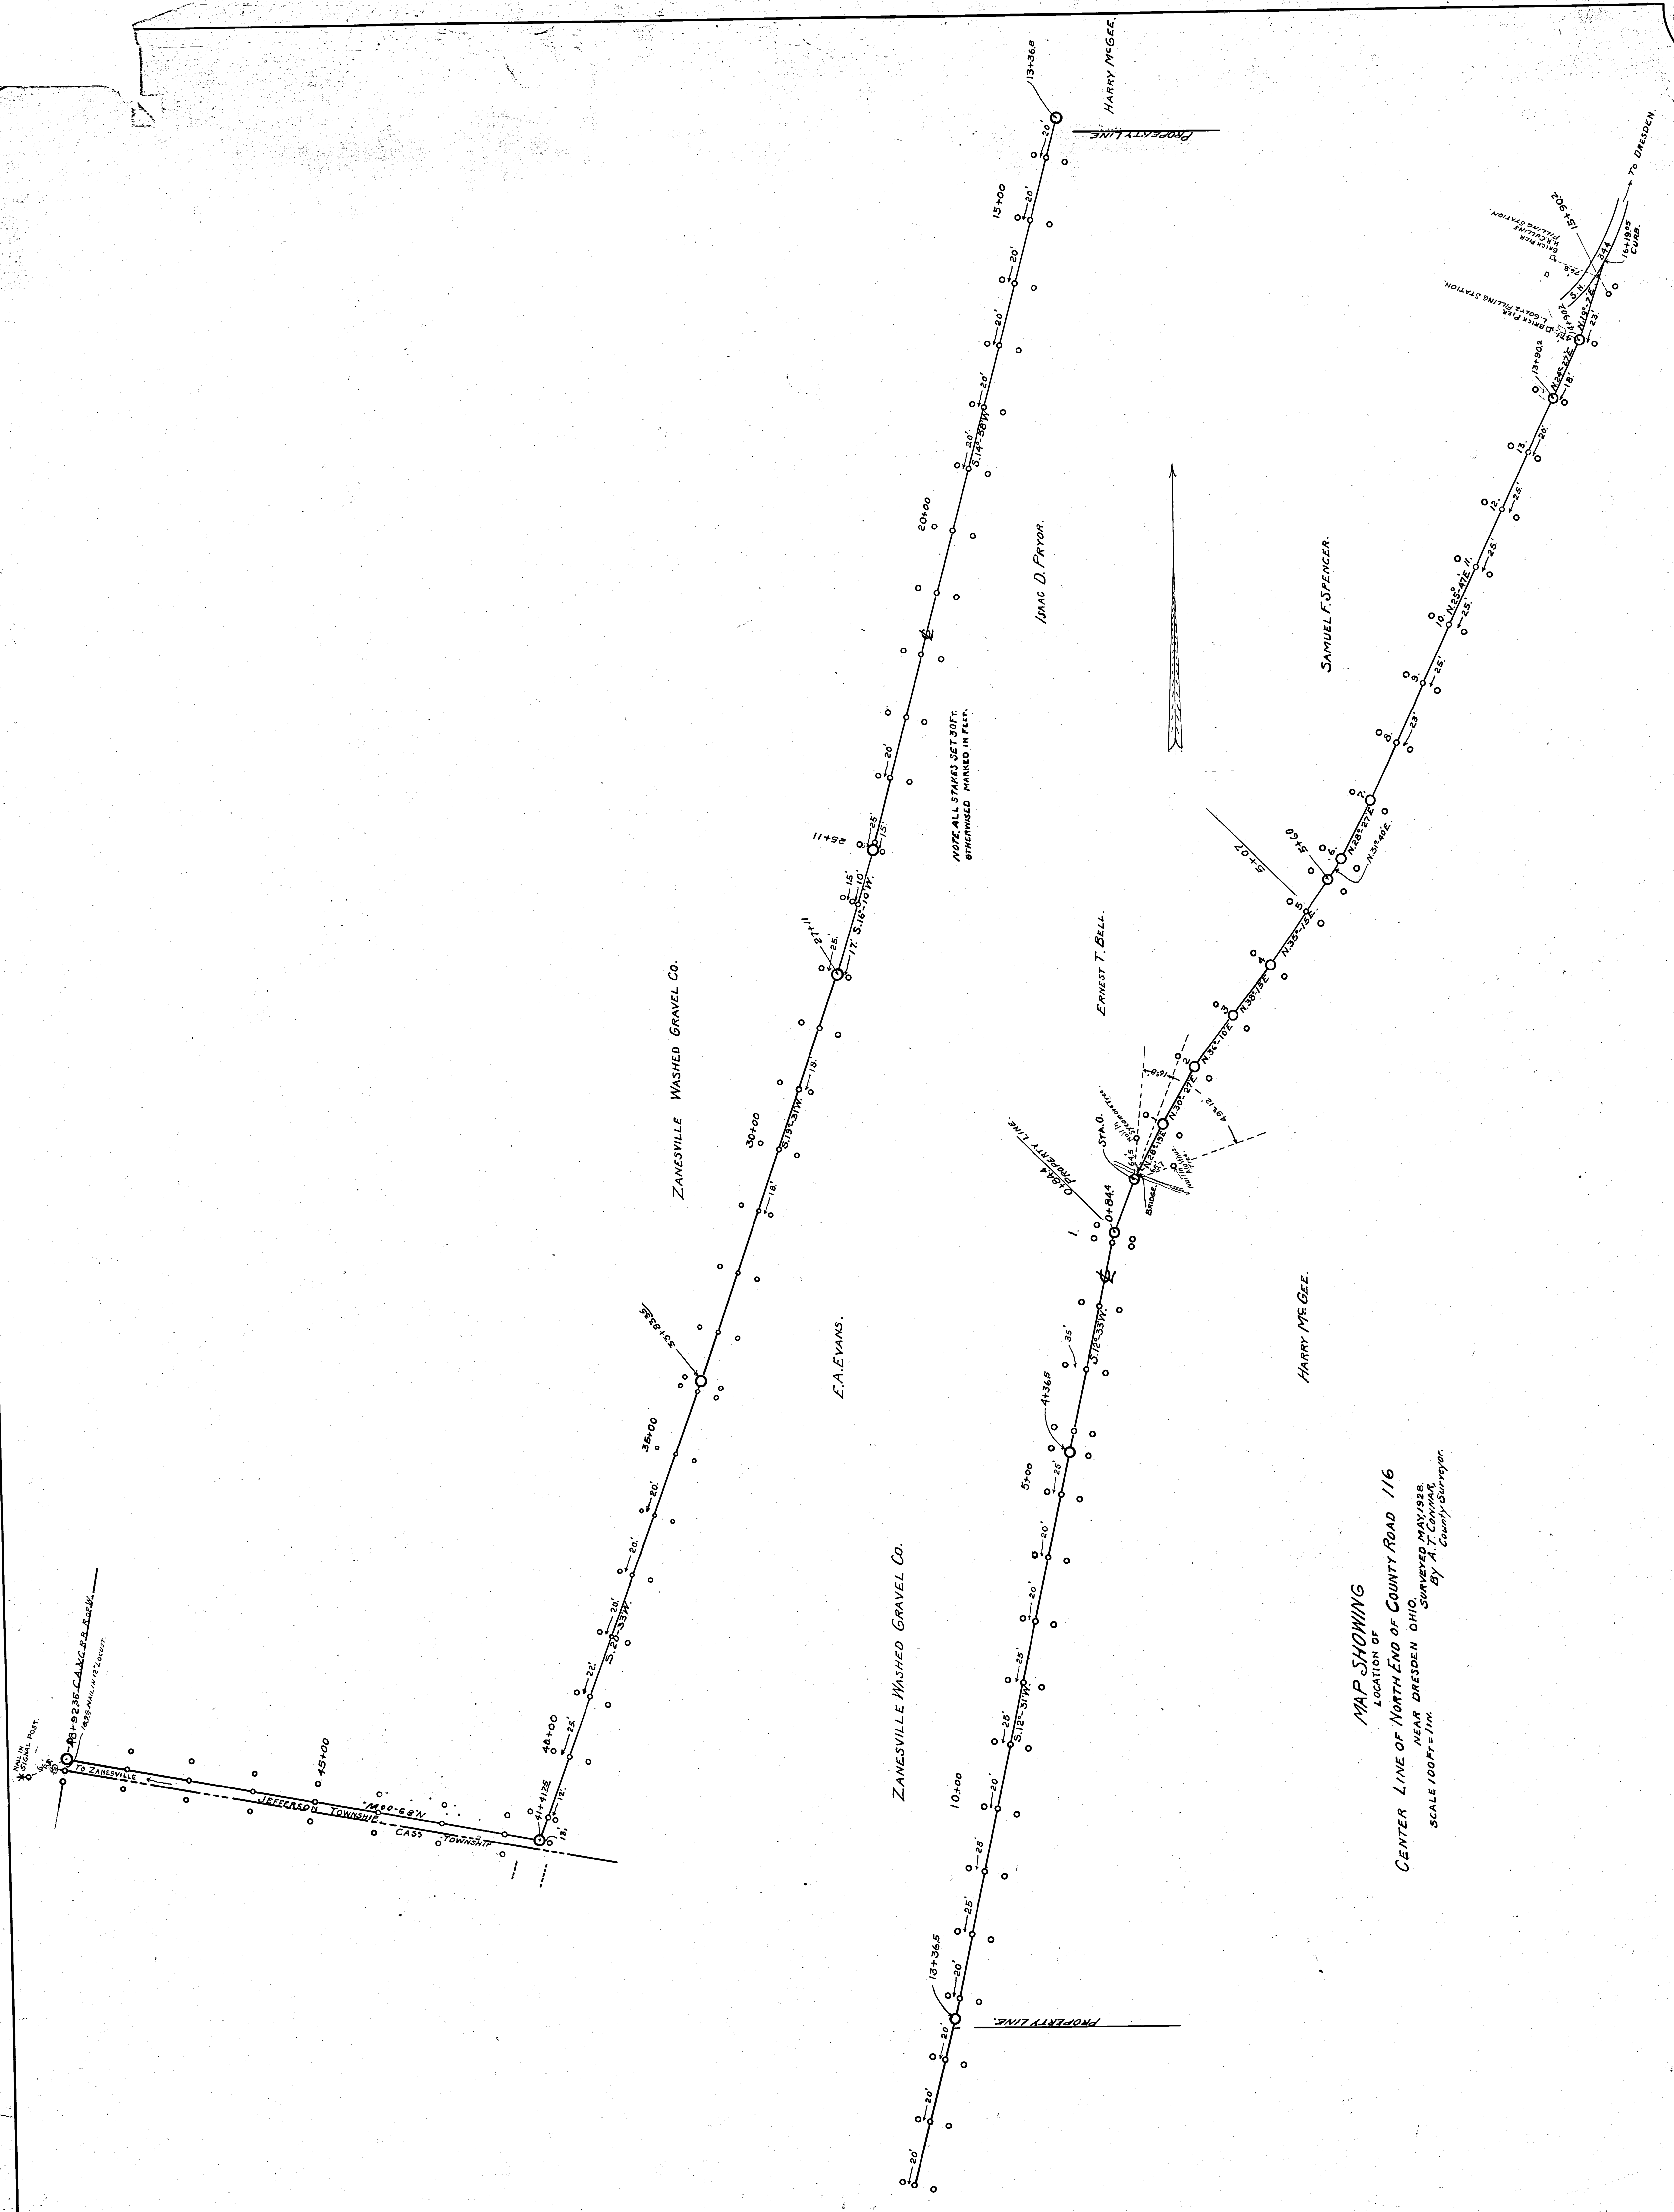

MAP SHOWING
LOCATION OF
CENTER LINE OF NORTH END OF COUNTY ROAD 116
NEAR DRESDEN OHIO
SURVEYED MAY 1928
BY H. T. CONNOR,
COUNTY SURVEYOR.