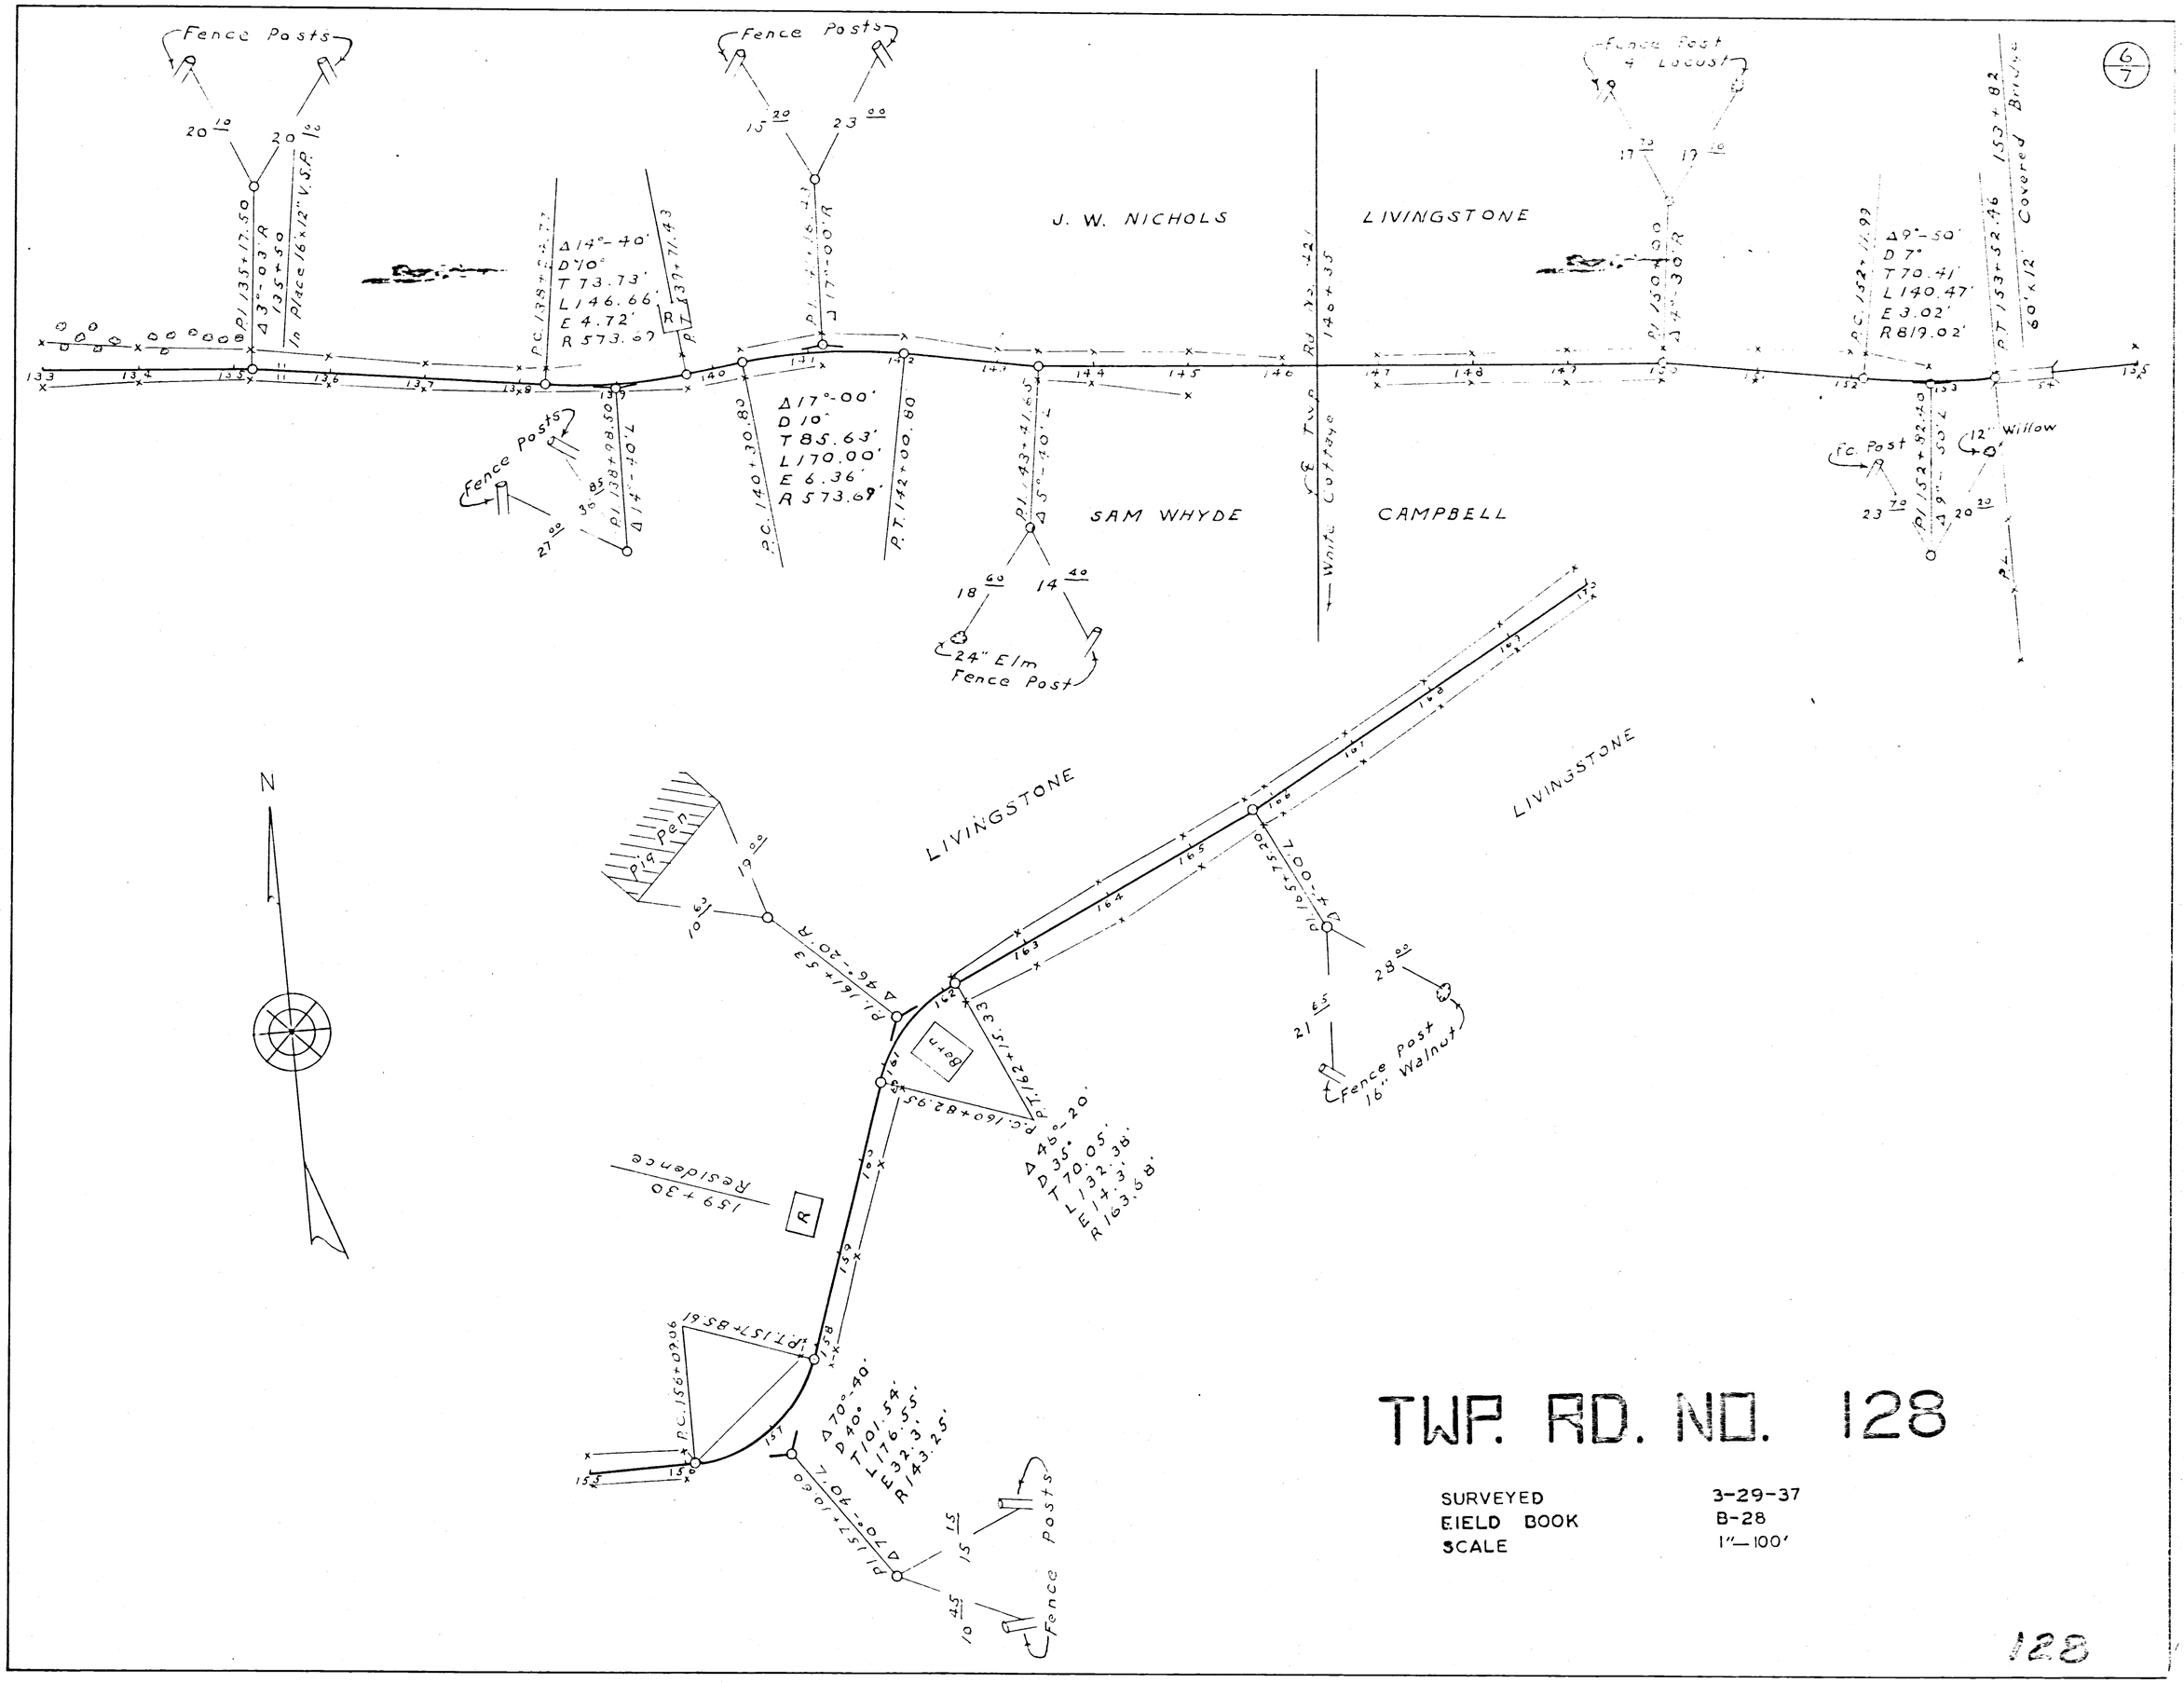

TWP. RD. NO. 128

SURVEYED	3-29-37
FIELD BOOK	B-28
SCALE	1"—100'

128