
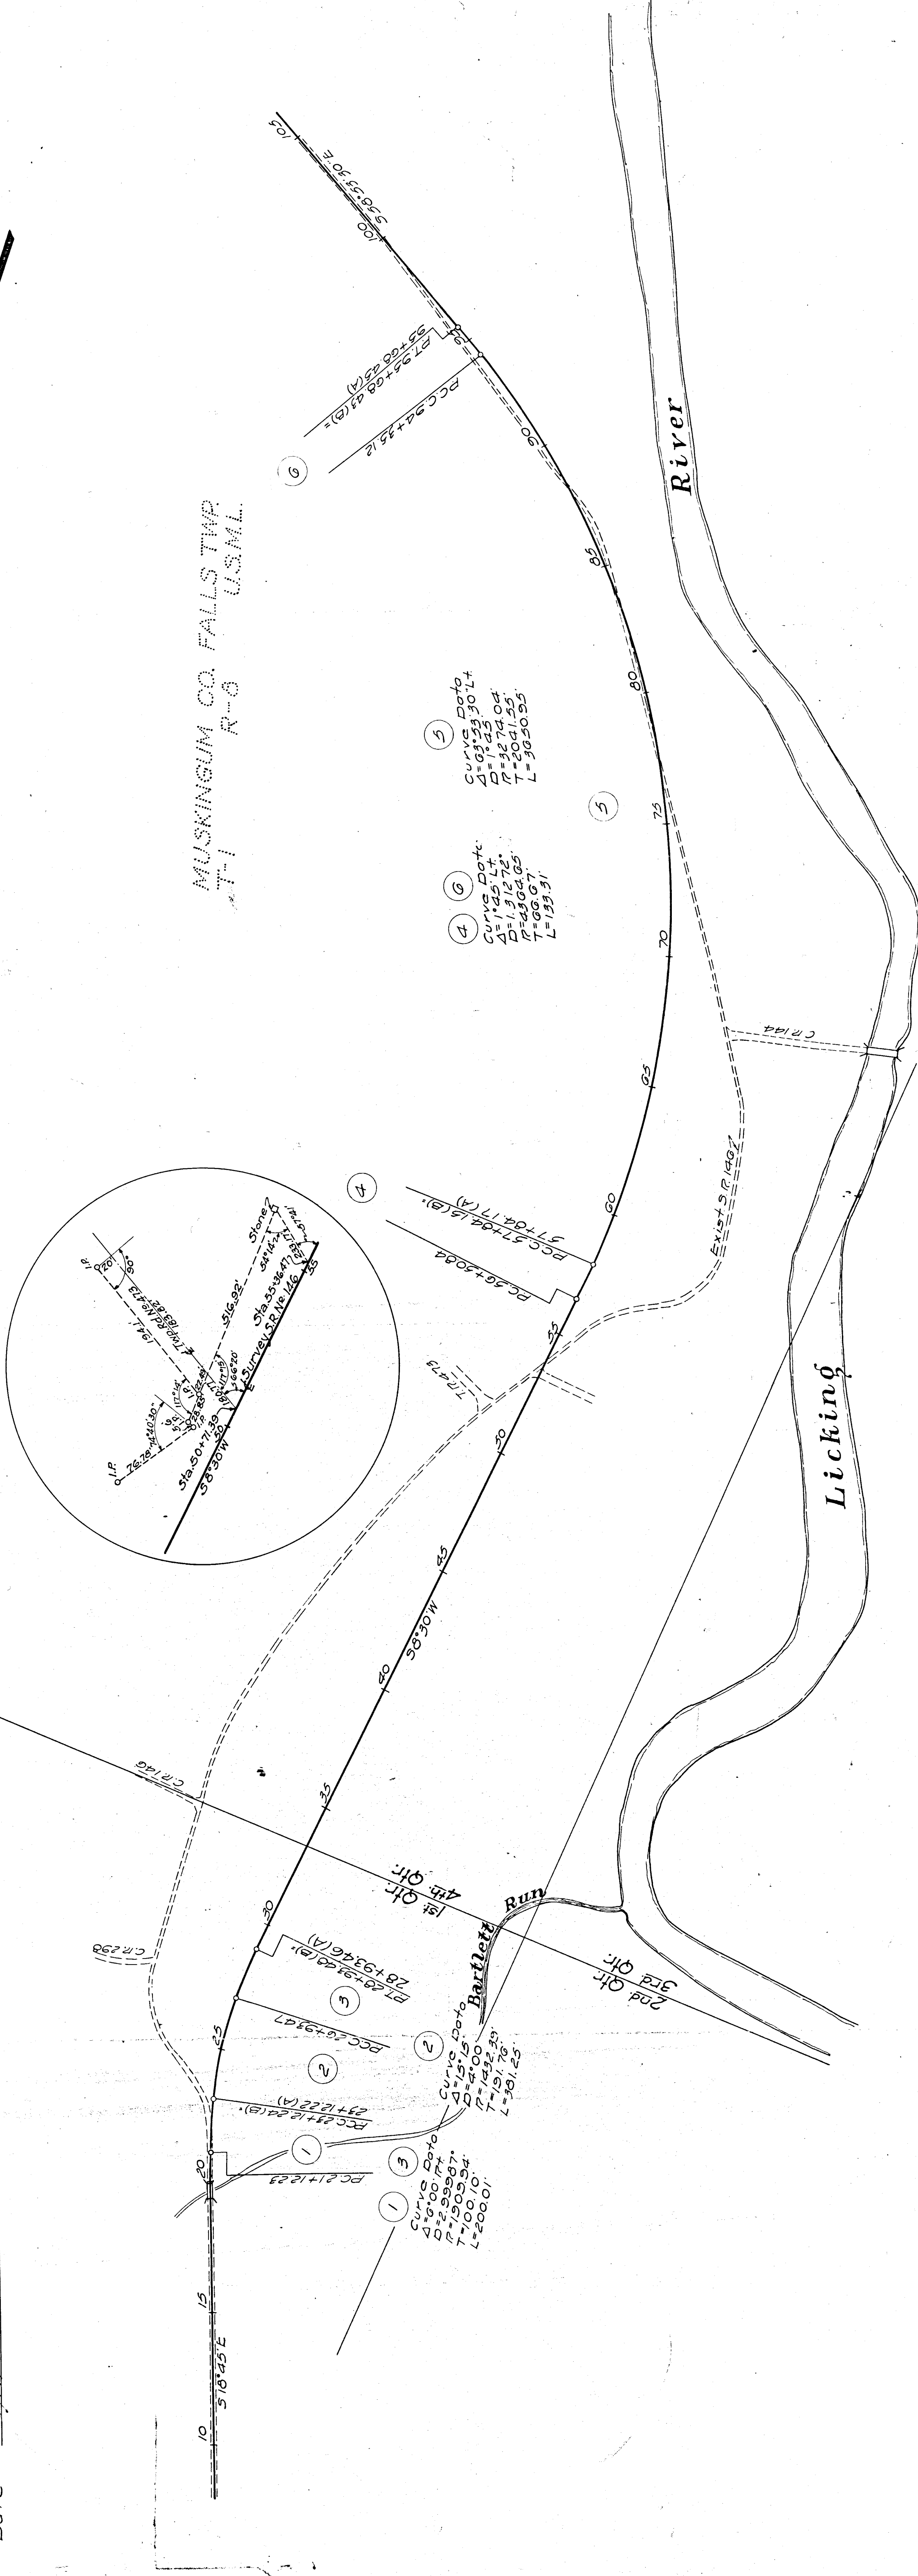
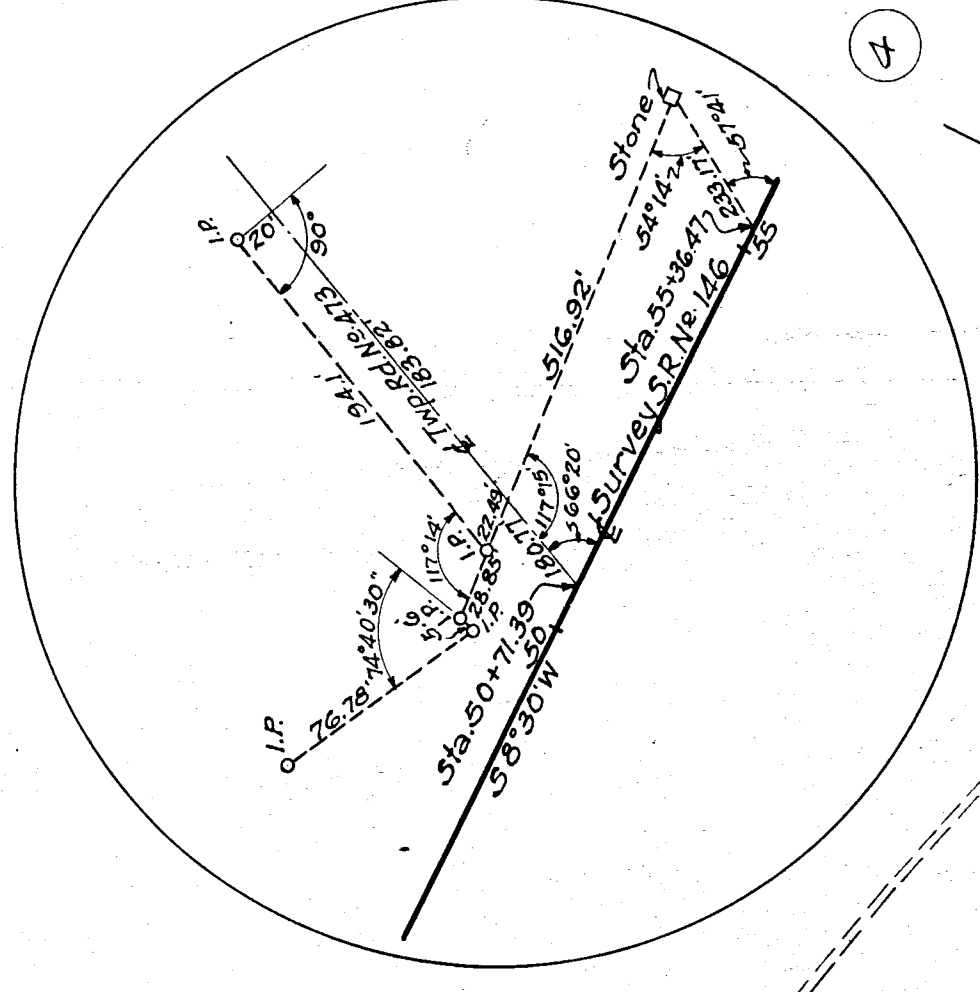


LOCATION PLAN

Received _____ Time _____
 Recorded May 17th 1858
 Put Book 7 Page 63
 Signed Annexed W. B. B. B. Recorder Mus.
 For _____ Paid _____

Note: This Instrument Prepared by the Ohio Dept. of Hwys. under the supervision of E.B. Chas. Anclear. PE No. 9347

Signed W. H. Thompson
Registered Surveyor No. 1560
Resident Division Deputy Director
5/10/58

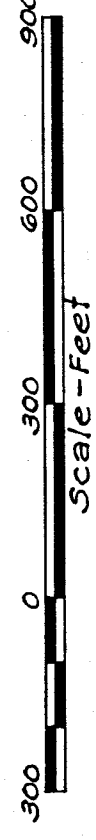

Memo - Center line reference monuments consisting of 1" iron pins set in April, 1959 under supervision of Dwight L. Moorehead. April 14, 1959.

CENTER LINE REFERENCE MONUMENTS WILL BE SET AFTER CONSTRUCTION

CENTER LINE REFERENCE MONUMENTS WILL BE SET AT 100' INTERVALS									
Mon. 31.75'	Mon. 51.96'	Mon. 77.94'	Mon. 60.63'	Mon. 54.85'	Mon. 98.15'	Mon. 32.31'	Mon. 51.96'	Mon. 72.75'	Mon.
Tan. $\frac{1}{4}$	Tan. $\frac{1}{4}$	Tan. $\frac{1}{4}$	Tan. $\frac{1}{4}$	Tan. $\frac{1}{4}$	Tan. $\frac{1}{4}$	Tan. $\frac{1}{4}$	Tan. $\frac{1}{4}$	Tan. $\frac{1}{4}$	Tan. $\frac{1}{4}$
Curve $\frac{1}{4}$	Curve $\frac{1}{4}$	Curve $\frac{1}{4}$	Curve $\frac{1}{4}$	Curve $\frac{1}{4}$	Curve $\frac{1}{4}$	Curve $\frac{1}{4}$	Curve $\frac{1}{4}$	Curve $\frac{1}{4}$	Curve $\frac{1}{4}$
P.O.T. STA. 19+03.8	P.C. STA. 21+12.23	P.C.C. STA. 23+12.22 (B) P.C. STA. 23+12.22 (A)	P.C.C. STA. 26+93.47	P.T. STA. 28+93.48 (B) STA. 28+93.46 (A)	P.O.T. STA. 35+00	P.O.T. STA. 40+00	P.O.T. STA. 45+00	P.O.T. STA. 50+00	P.O.C. STA. 55+00
Mon. 65.24'	Mon. 103.92'	Mon. 56.58'	Mon. 77.94'	Mon. 98.15'	Mon. 138.56'	Mon. 51.96'	Mon. 57.74'	Mon. 51.96'	Mon. 51.96'
Tan. $\frac{1}{4}$	Tan. $\frac{1}{4}$	Tan. $\frac{1}{4}$	Tan. $\frac{1}{4}$	Tan. $\frac{1}{4}$	Tan. $\frac{1}{4}$	Tan. $\frac{1}{4}$	Tan. $\frac{1}{4}$	Tan. $\frac{1}{4}$	Tan. $\frac{1}{4}$
Curve $\frac{1}{4}$	Curve $\frac{1}{4}$	Curve $\frac{1}{4}$	Curve $\frac{1}{4}$	Curve $\frac{1}{4}$	Curve $\frac{1}{4}$	Curve $\frac{1}{4}$	Curve $\frac{1}{4}$	Curve $\frac{1}{4}$	Curve $\frac{1}{4}$
P.O.T. STA. 55+00	P.C. STA. 56+50.84	P.C.C. STA. 57+84.15 (B) STA. 57+84.17 (A)	P.O.C. STA. 60+00	P.O.C. STA. 65+00	P.O.C. STA. 70+00	P.O.C. STA. 75+00	P.O.C. STA. 80+00	P.O.C. STA. 85+00	P.O.C. STA. 90+00