


SH. NO. 575, SEC. B-PH
MUSKINGUM COUNTY

TYPICAL SECTIONS

TYPE T-10

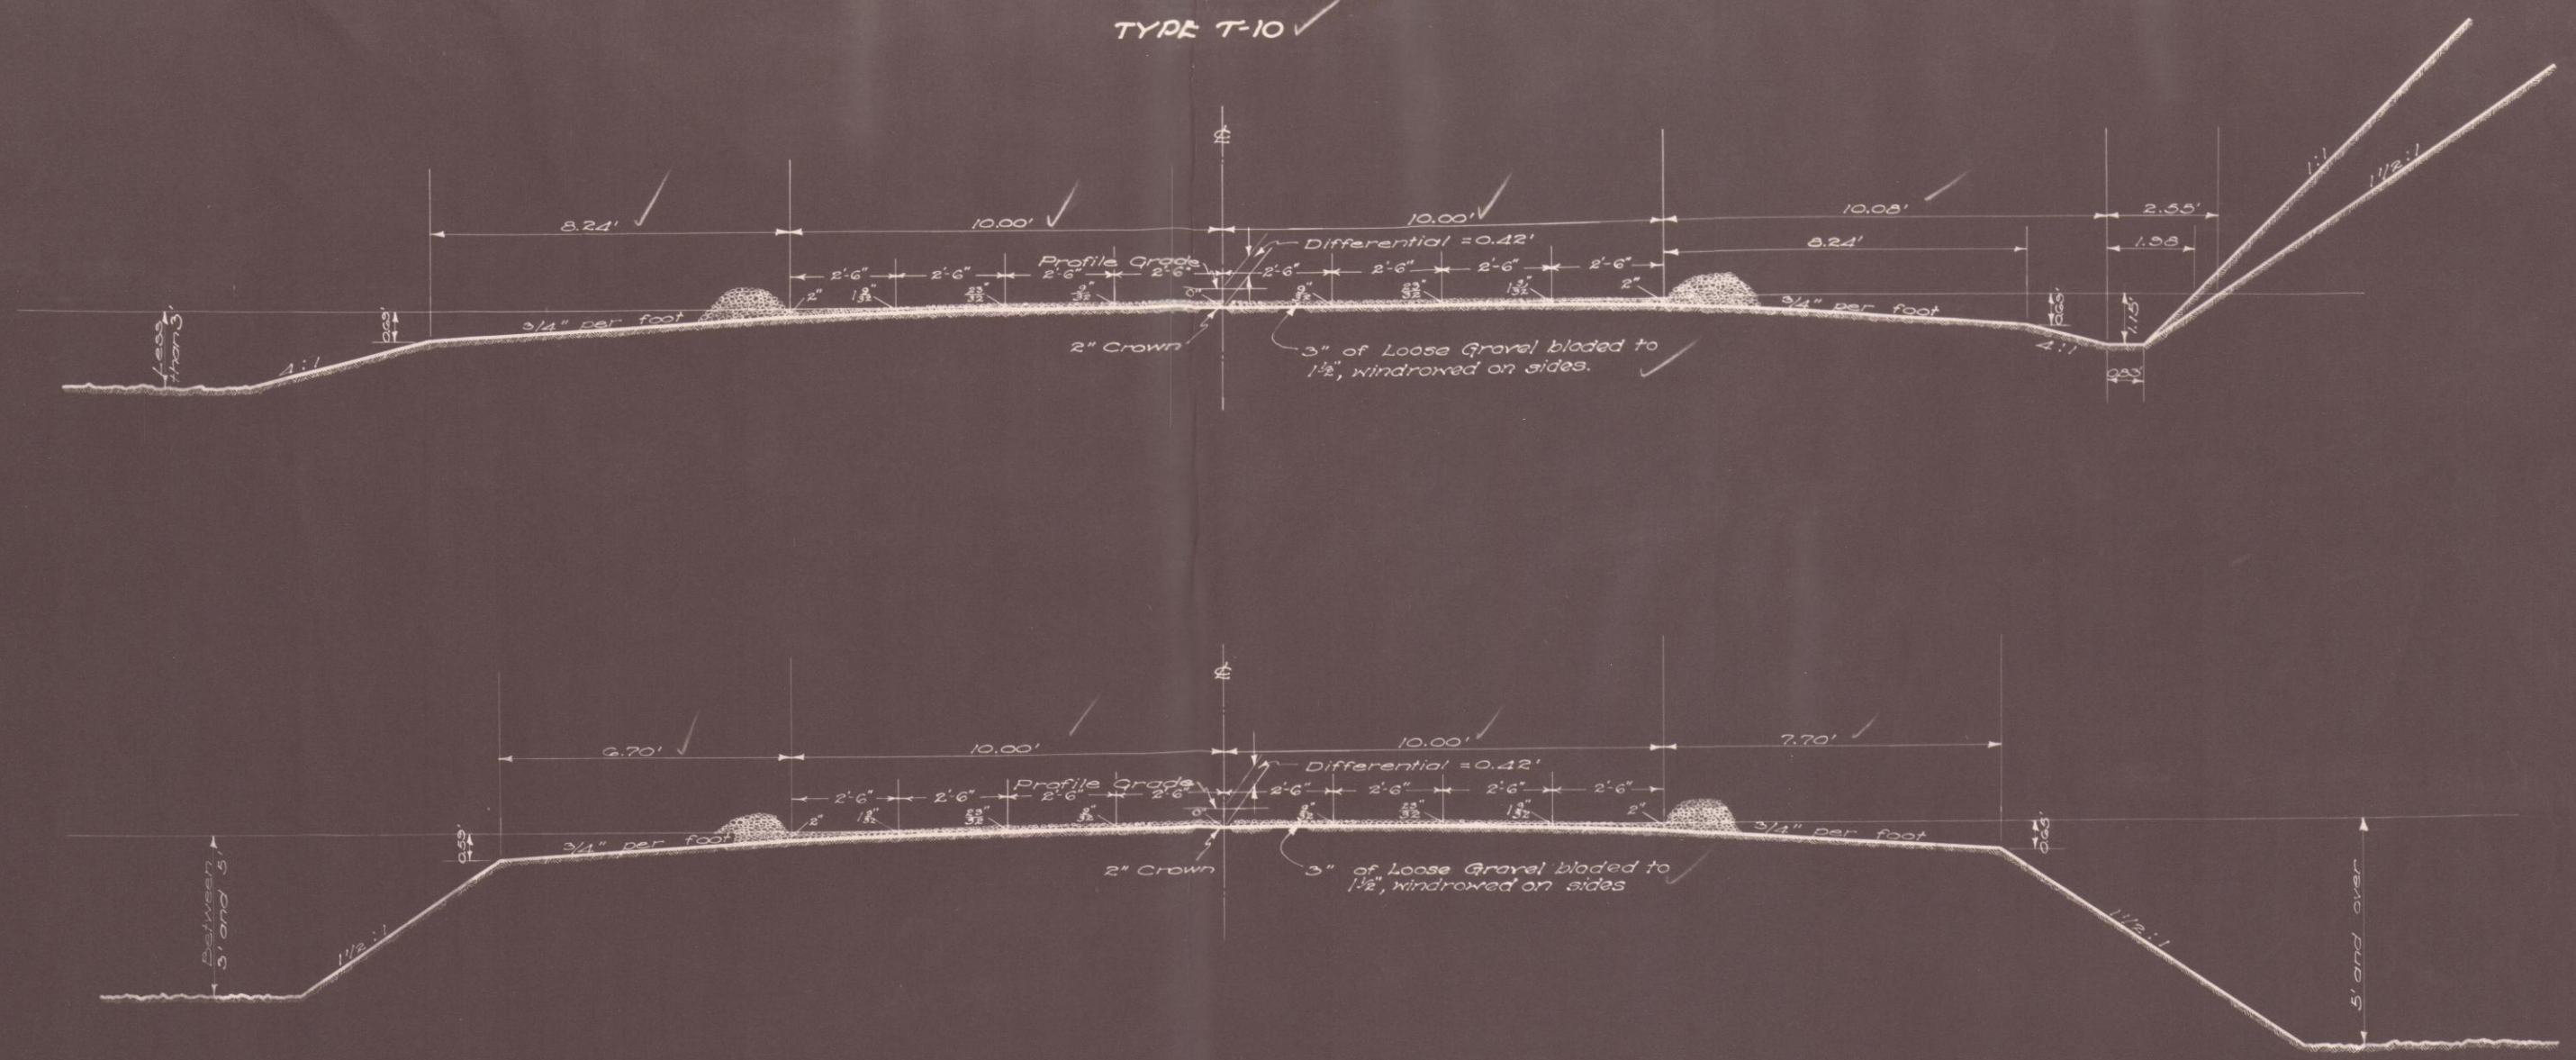

NOTE:- FOR CULVERT JOINT DESIGN
SEE SHEET NO. 55.

NOTE:-

Regarding the clause in the specifications for the above project which reads as follows:-
"The work covered by this contract shall be conducted in such a manner that maximum employment of labor is afforded so far as is practicable during the life of the contract."
The contractor shall commence construction operations immediately upon execution of the contract and will prosecute during the winter months the work pertaining to side drainage and structures, and perform such work of grading, paving, and finishing of berms as may be permitted or requested by the Director.

NOTE:-

In lieu of the provisions for the backfilling of pipe for roadway drainage as set forth in Item I-3.05 in the General Specifications, requiring tamping of backfilling in four inch layers. Such tamping will be required only up to a point in the trench equal to two thirds of the diameter of the pipe, and a pneumatic tumber will not be required.

DIFFERENTIAL =
Assuming average width of berm = 6' and neglecting shoulder Δs, lower profile grade 0.42' from that shown on cross sections. Berm excavation, 12 x 0.42 = 5.04 sq. ft. Embankment, 20 x (.67 - .42) = 5.00 " " Excavation quantities remain the same.