


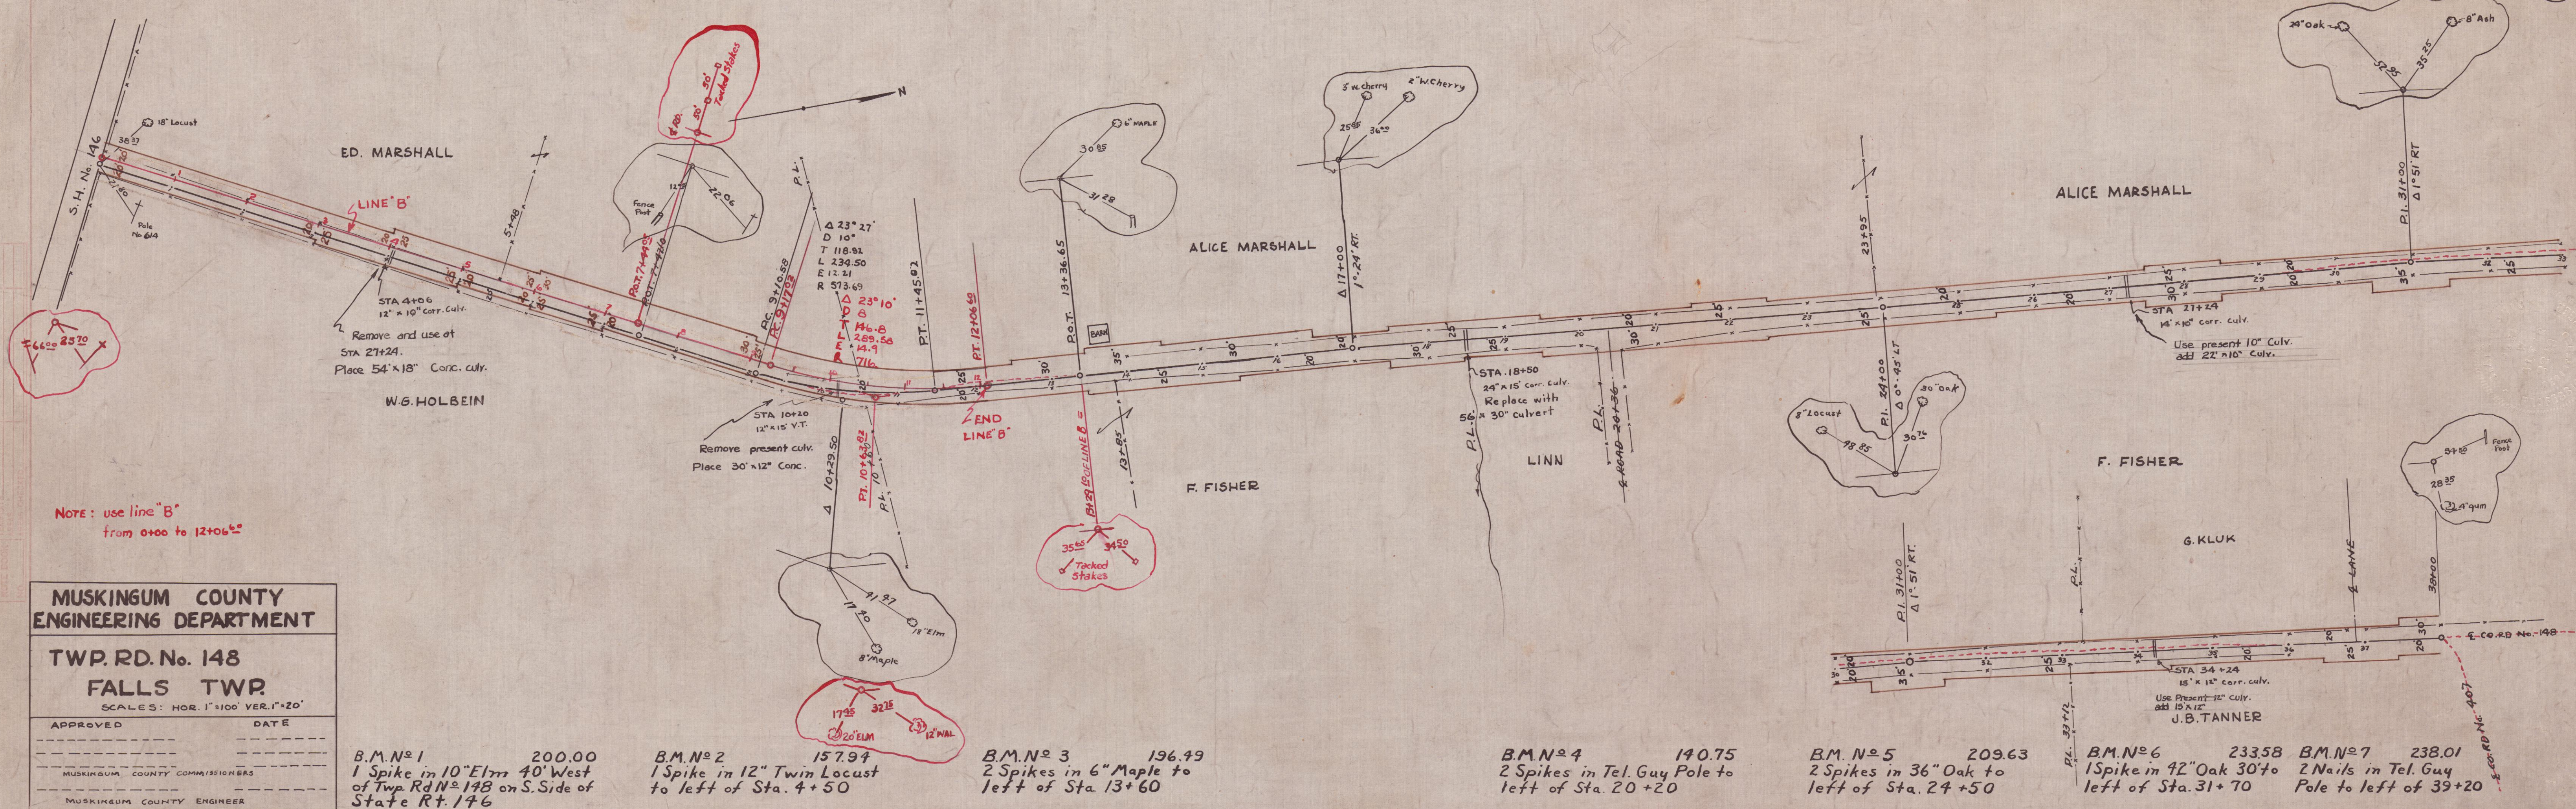

MUSKINGUM COUNTY
ENGINEERING DEPARTMENT

TWP. RD. No. 148
FALLS TWP.

SCALE: HOR. 1"=100' VER. 1"=20'

APPROVED _____ DATE _____

MUSKINGUM COUNTY COMMISSIONERS

MUSKINGUM COUNTY ENGINEER

B.M. No. 1 200.00
1 Spike in 10" Elm 40' West
of Twp. Rd. No. 148 on S. Side of
State Rt. 146

B.M. No. 2 157.94
1 Spike in 12" Twin Locust
to left of Sta. 4+50

B.M. No. 3 196.49
2 Spikes in 6" Maple to
left of Sta. 13+60

B.M. No. 4 140.75
2 Spikes in Tel. Guy Pole to
left of Sta. 20+20

B.M. No. 5 209.63
2 Spikes in 36" Oak to
left of Sta. 24+50

B.M. No. 6 233.58
1 Spike in 42" Oak 30' to
left of Sta. 31+70

B.M. No. 7 238.01
2 Nails in Tel. Guy
Pole to left of 39+20

