163-429

TRAVERSE OF TOWNSHIP ROADS 163 & 429

ADAMS TOWNSHIP

Scale: 1 in=400 ft

Book-C-5

Surveyed 8-22-41

File, A-13

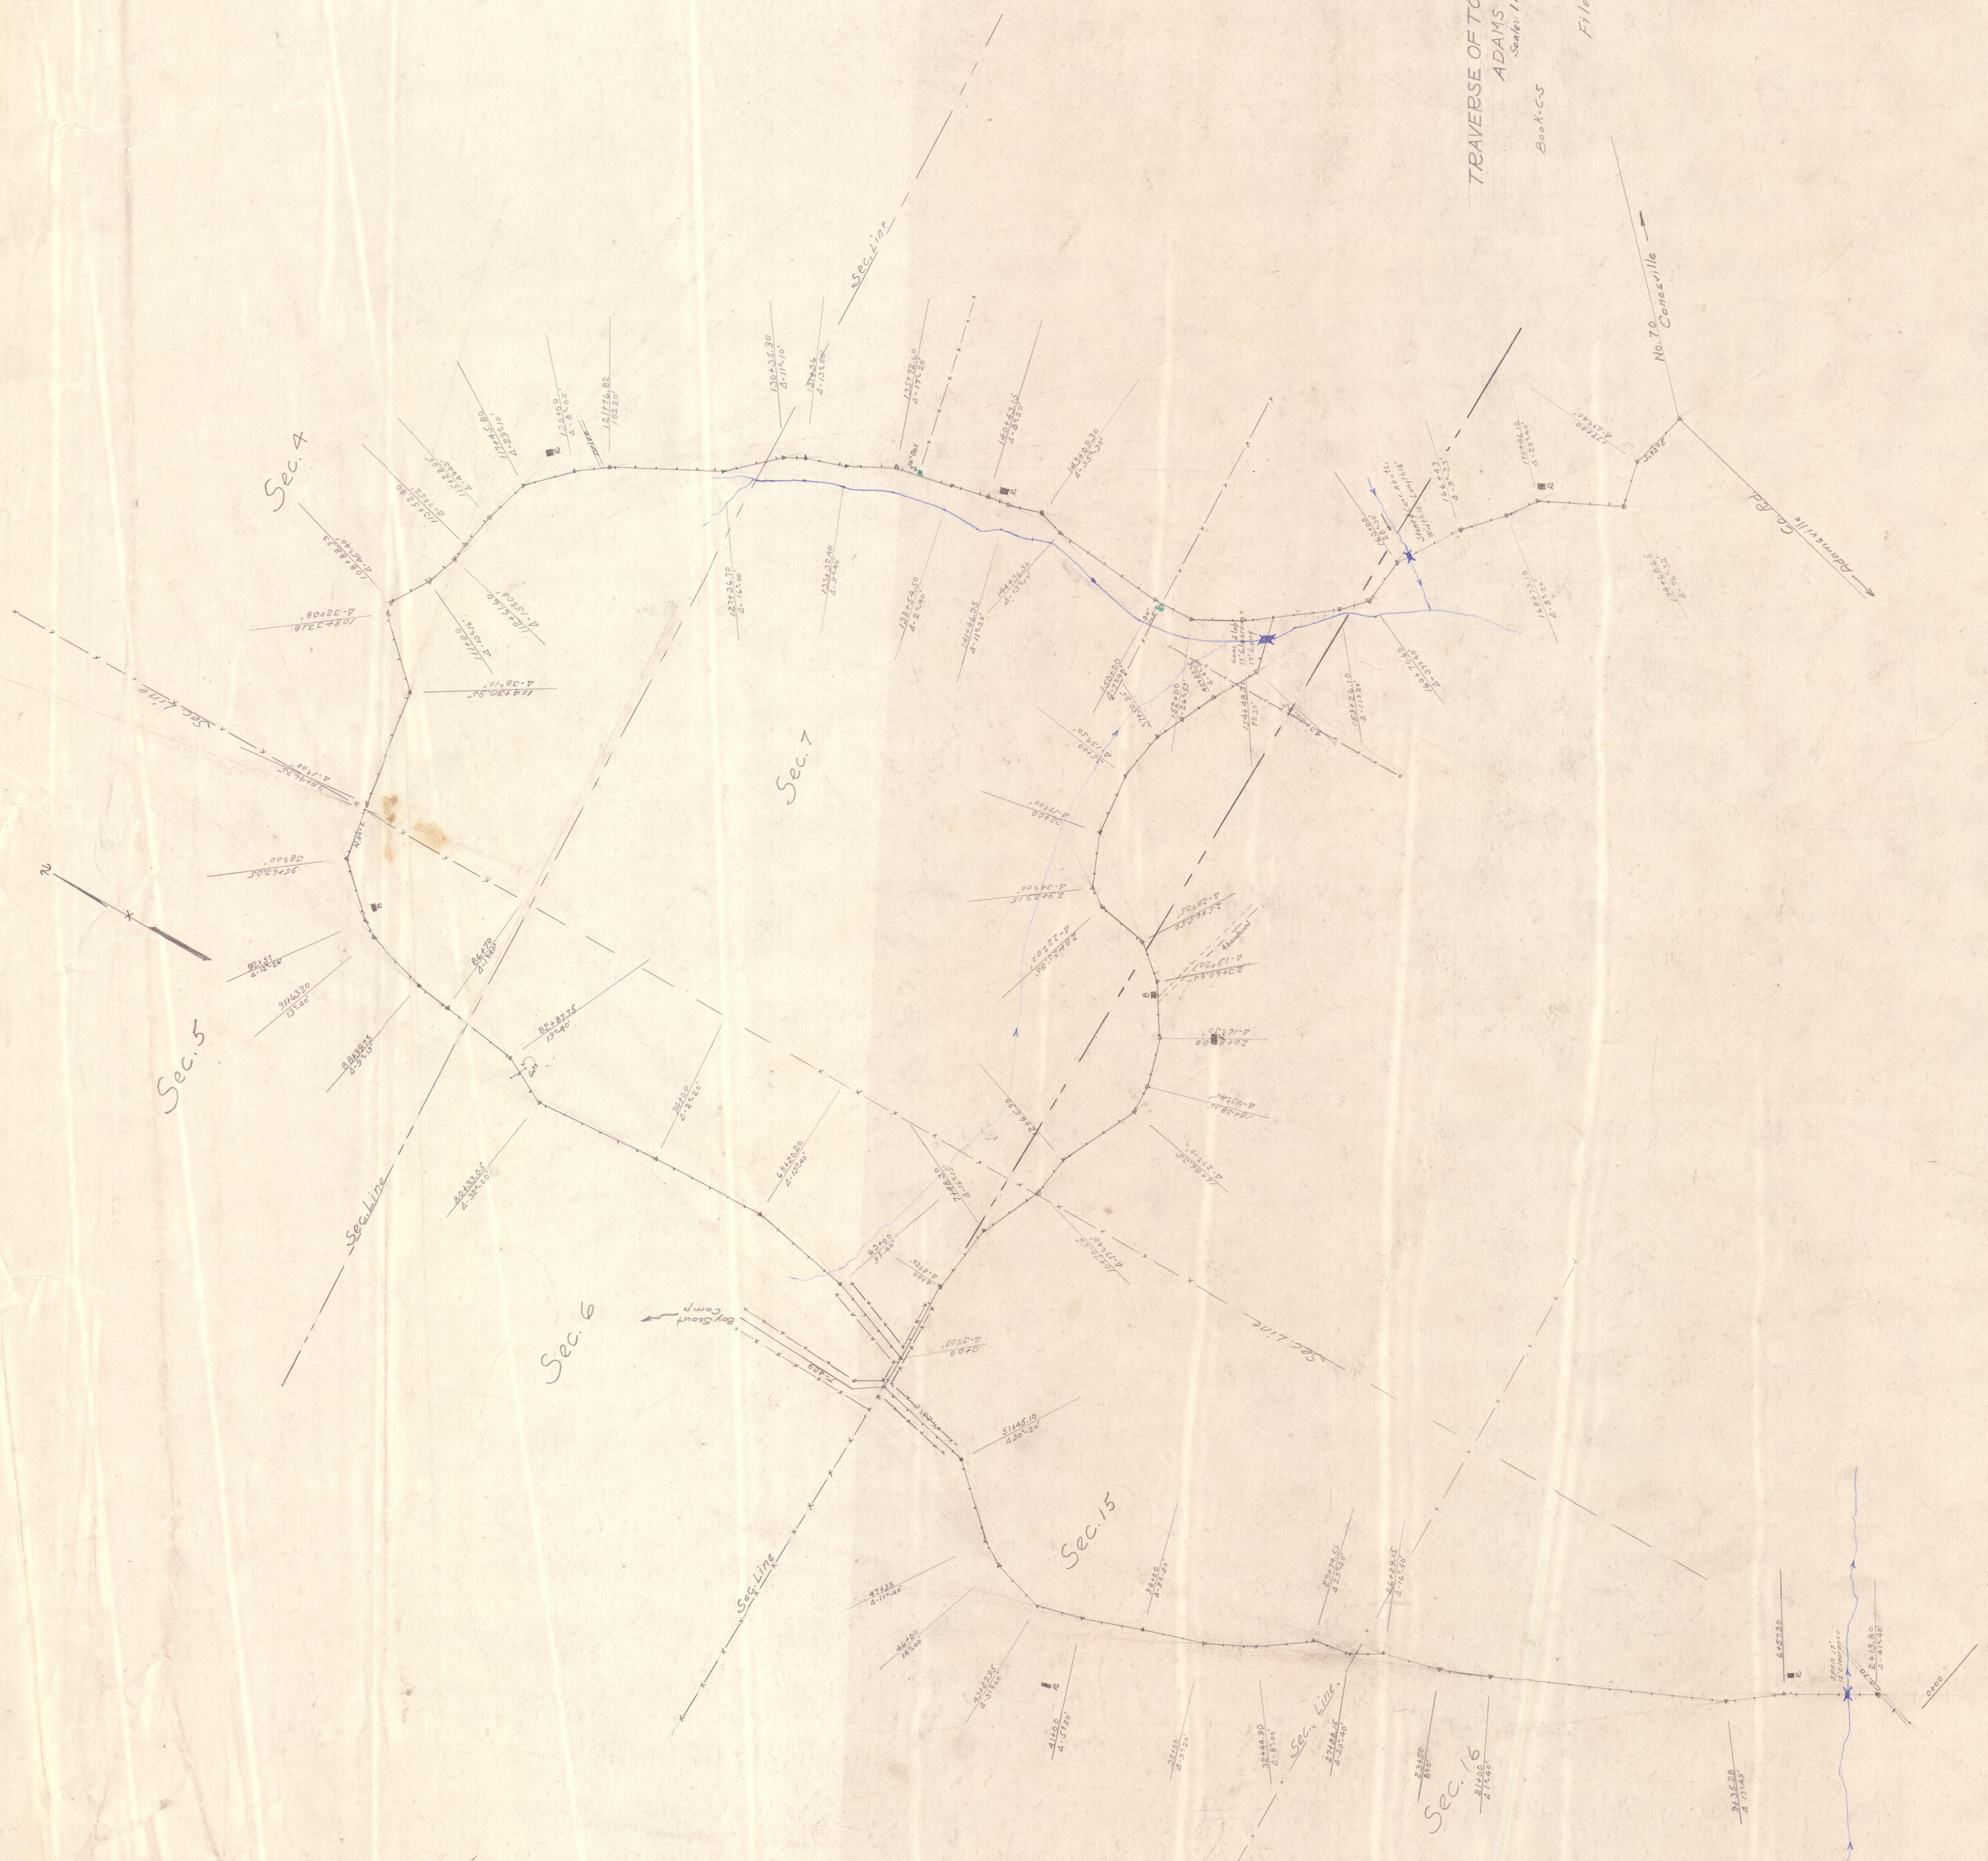

N
Sec. 4
Sec. 5
Sec. 6
Sec. 7
Sec. 15
Sec. 16
Sec. Line
Sec. Line
Sec. Line
Sec. Line
Sec. Line
Sec. Line
No. 70 Conesville
Adamsville Co. Rd.
Boy Scout Camp
T-429
Abandoned
Gate
Drive
24" Oak
R
B
Conc. Slab 11' Clearance 17' Long
Stone & Conc. Abuts. Width 12 Length 18'
Span 17' 8' Clearance
108+33.18 Δ-32°38'
108+88.93 Δ-45°40'
113+52.80 Δ-7°45'
115+28.85 Δ-48°45'
117+45.80 Δ-29°10'
120+00 Δ-8°05'
121+76.82 10°20'
111+00 Δ-15°15'
112+61.60 Δ-15°08'
104+30.95 Δ-38°10'
98+46.75 Δ-12°00'
95+63.05 38°00'
92+51 Δ-12°26'
91+63.20 13°40'
88+39.75 Δ-9°15'
86+70 Δ-18°40'
82+87.75 19°40'
80+33.05 Δ-32°00'
74+00 Δ-2°20'
68+20.20 Δ-13°40'
63+00 9°40'
4+00 Δ-8°20'
0+00 Δ-35°20'
51+45.10 Δ30°20'
47+38 Δ-11°40'
46+00 14°40'
43+27.95 Δ-31°00'
41+00 Δ-5°20'
38+00 Δ-28°20'
35+00 Δ-9°20'
32+44.90 Δ-8°00'
29+74.55 Δ-25°20'
27+88.15 Δ-20°40'
26+29.15 Δ-16°40'
23+50 8°0'
21+00 Δ12°40'
9+35.28 Δ13°49'
6+57.30
2+13.80 Δ-41°40'
0+00
130+35.90 Δ-11°10'
131+36 Δ-13°00'
135+72.60 Δ-17°20'
127+36.70 Δ-16°00'
133+32.40 Δ-9°40'
138+54.50 Δ-2°40'
141+46.35 Δ-11°20'
140+43.15 Δ-8°20'
143+09.30 Δ-35°30'
144+36.30 Δ-13°10'
150+00 Δ-7°20'
152+00 Δ-26°53'
154+48.30 72°30'
159+26.10 Δ-11°20'
160+70.60 Δ-21°30'
162+00 28°00'
166+43 Δ-9°23'
168+73.10 Δ-8°20'
170+26.12 Δ-29°40'
172+00 Δ-29°40'
174+68.65 Δ-16°32'
35+00 Δ-13°50'
32+00 Δ-17°00'
29+29.15 Δ-34°00'
28+35.30 Δ-22°00'
25+63.50 Δ-28°35'
23+60.65 Δ-15°20'
20+00 Δ-16°30'
18+38.15 Δ-43°45'
14+86.35 Δ-27°10'
12+65.90
10+70.55 Δ-17°40'
7+48.30 Δ-16°15'
0+00 Δ-35°20'