MUSKINGUM COUNTY ENGINEERING DEPT. COUNTY RD. NO. 307 MUSKINGUM TWP.

FINAL SURVEY	BY	DATE
SURVEYED		
PLOTTED		
TEMPLATE		
AREAS		
AREAS CHECKED		
NOTE BOOK		
NO.		

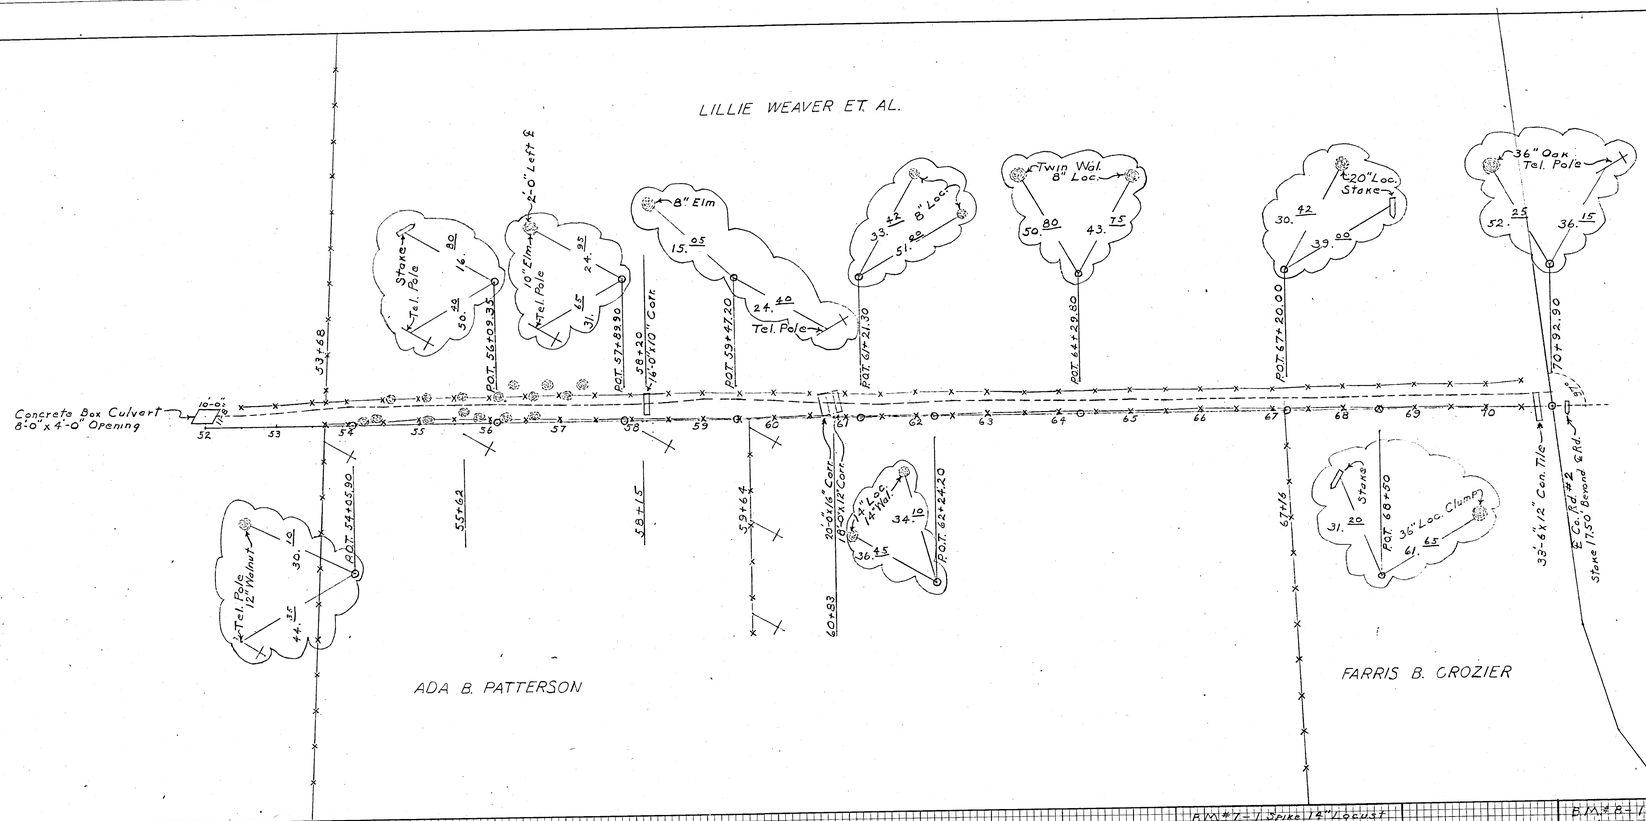

ORIGINAL SURVEY	BY	DATE
SURVEYED		
PLOTTED		
TEMPLATE		
AREAS		
AREAS CHECKED		
NOTE BOOK		
NO. B-7		

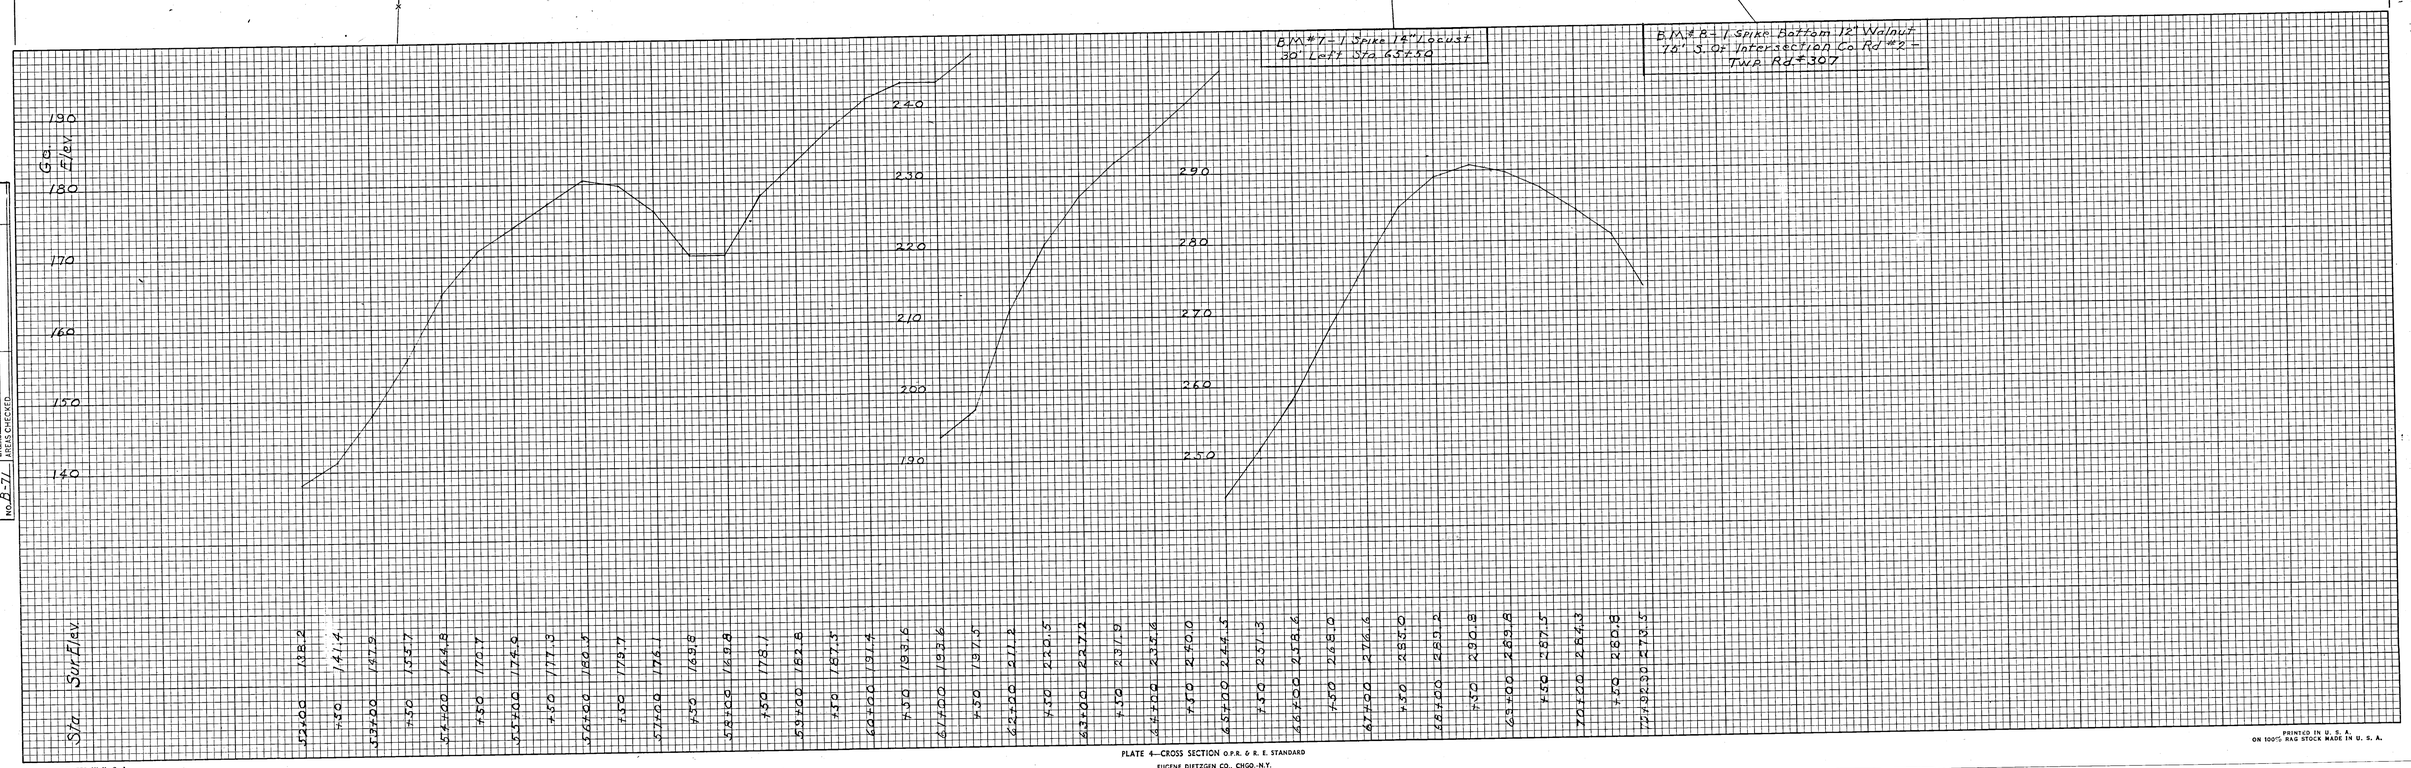

PLATE 4—CROSS SECTION O.P.R. & R. E. STANDARD

EUGENE DIETZGEN CO., CHGO.-N.Y.

PRINTED IN U. S. A. ON 100% RAG STOCK MADE IN U. S. A.

PRINTED IN U. S. A. ON 100% RAG STOCK MADE IN U. S. A.