


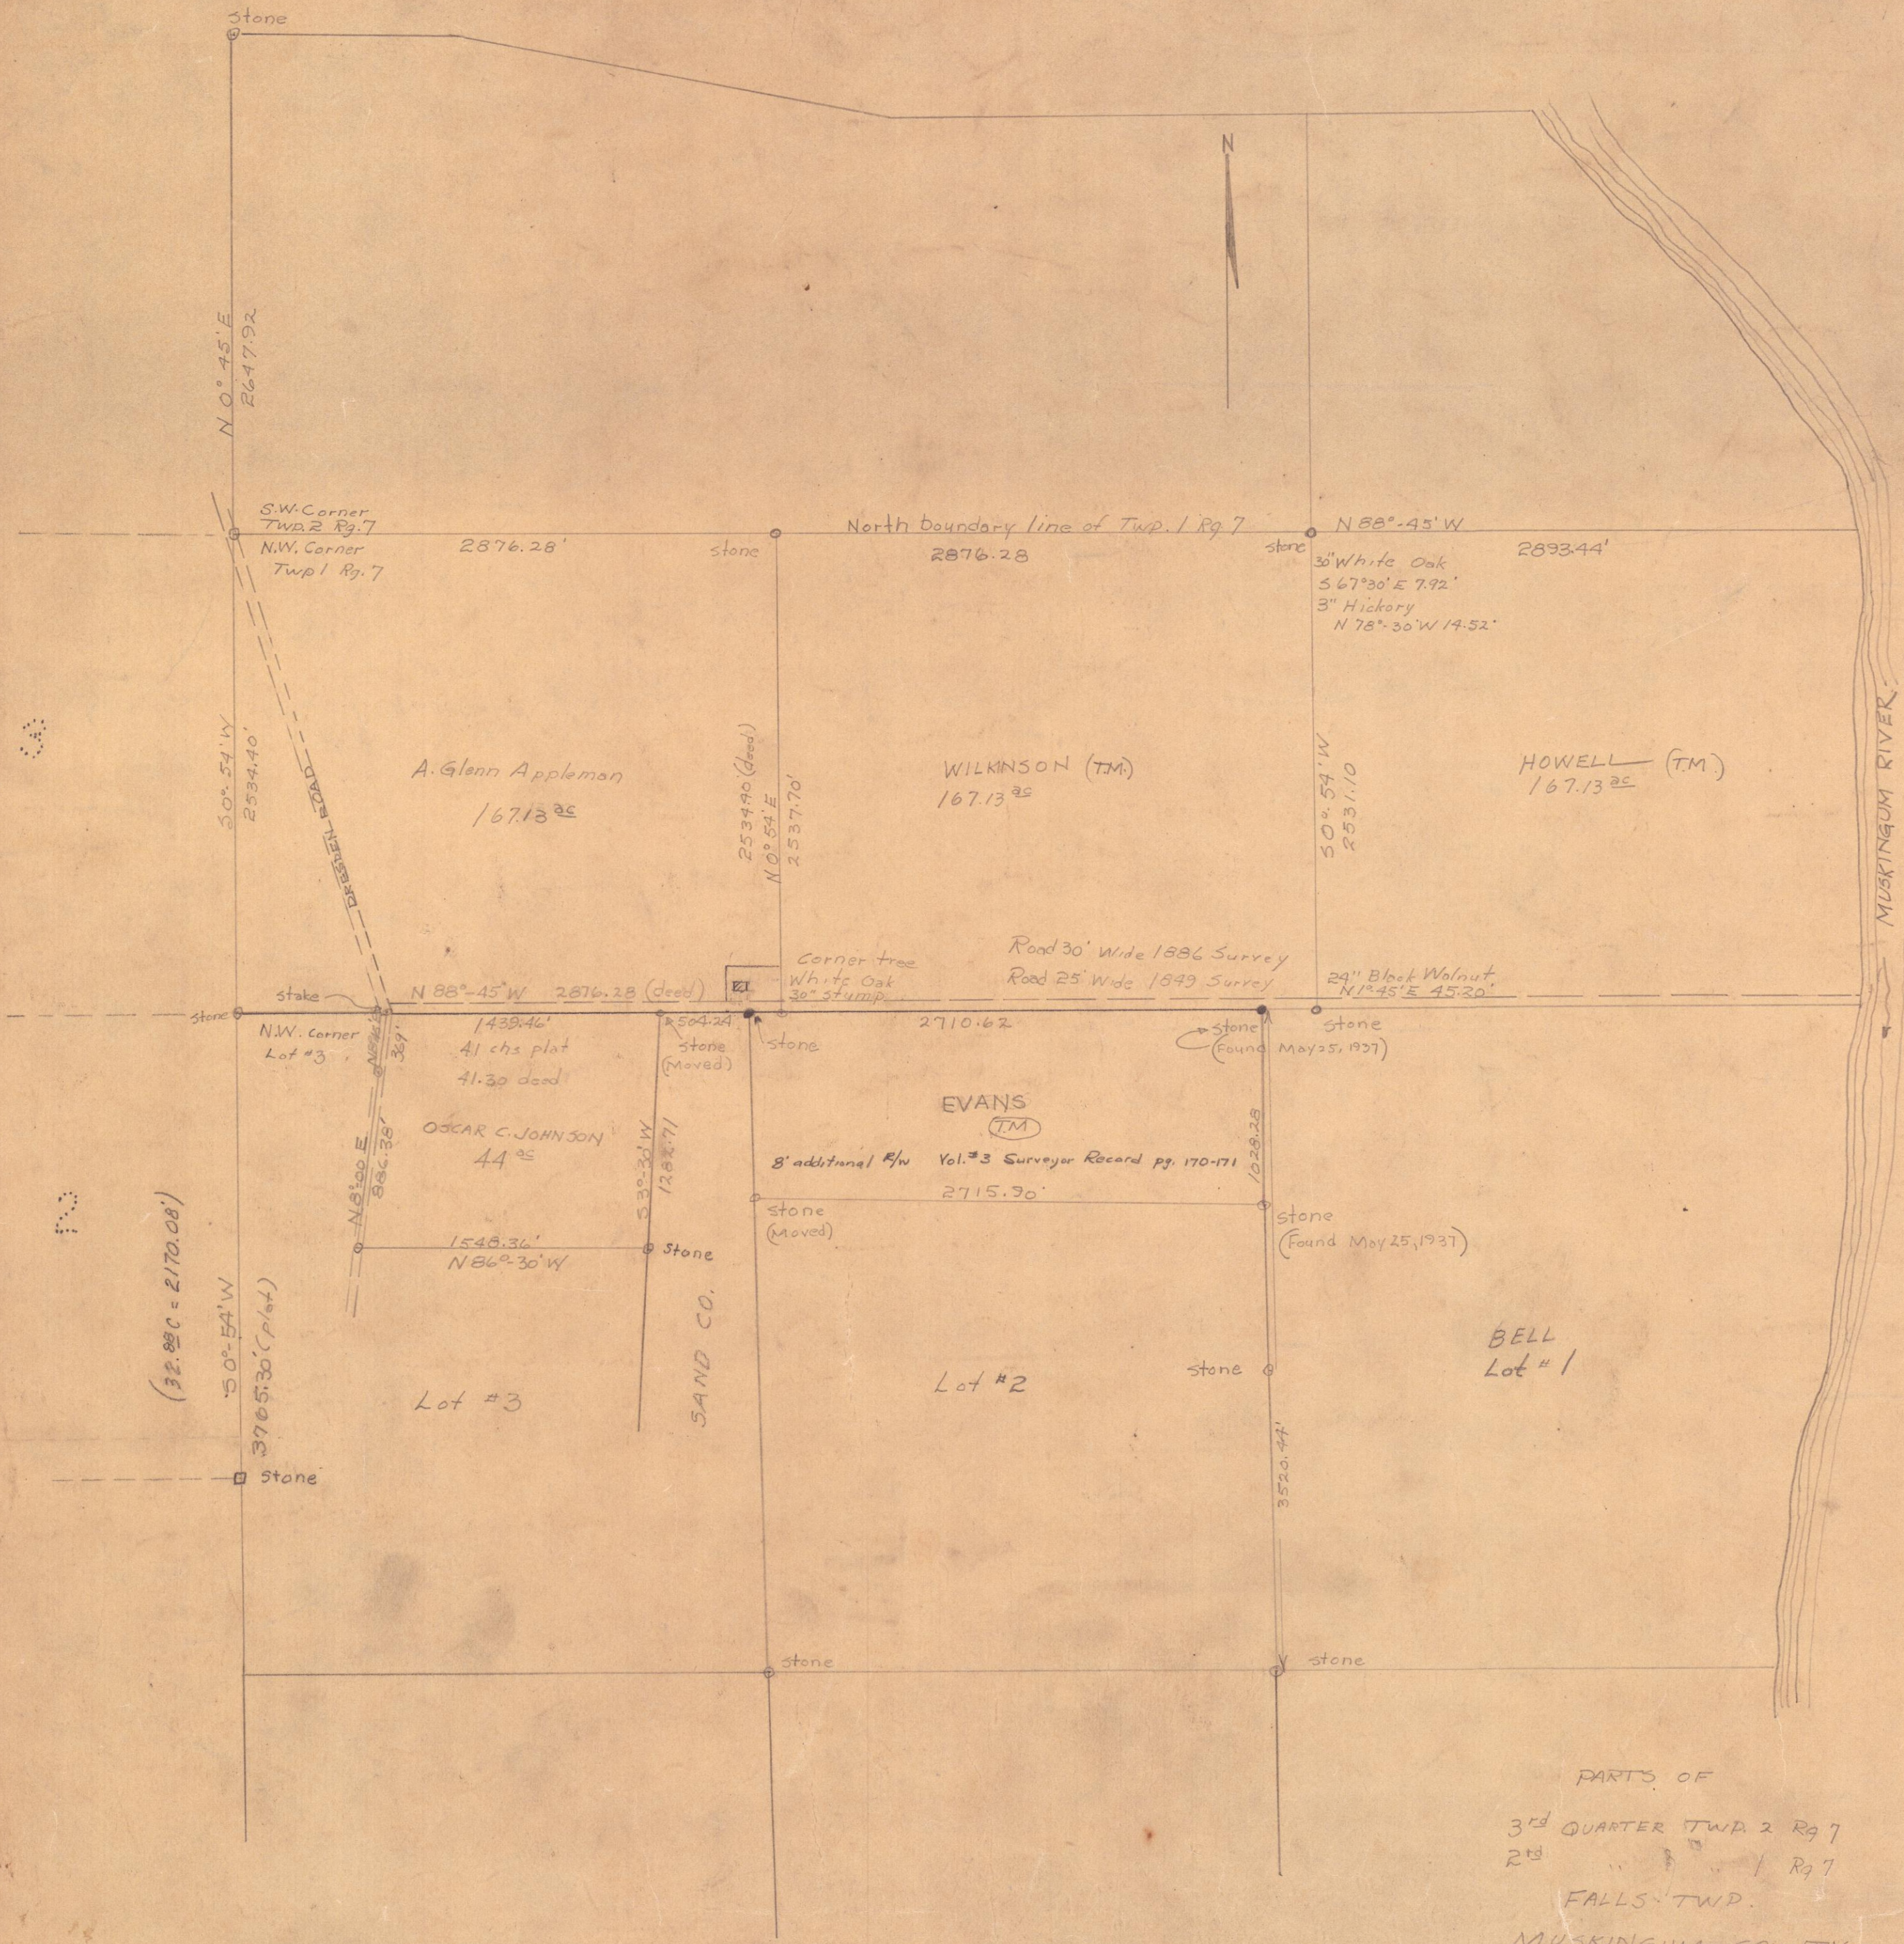

PARTS OF
3rd QUARTER TWP 2 R9 7
2nd " " " 1 R9 7
FALLS TWP.
MUSKINGUM COUNTY

