
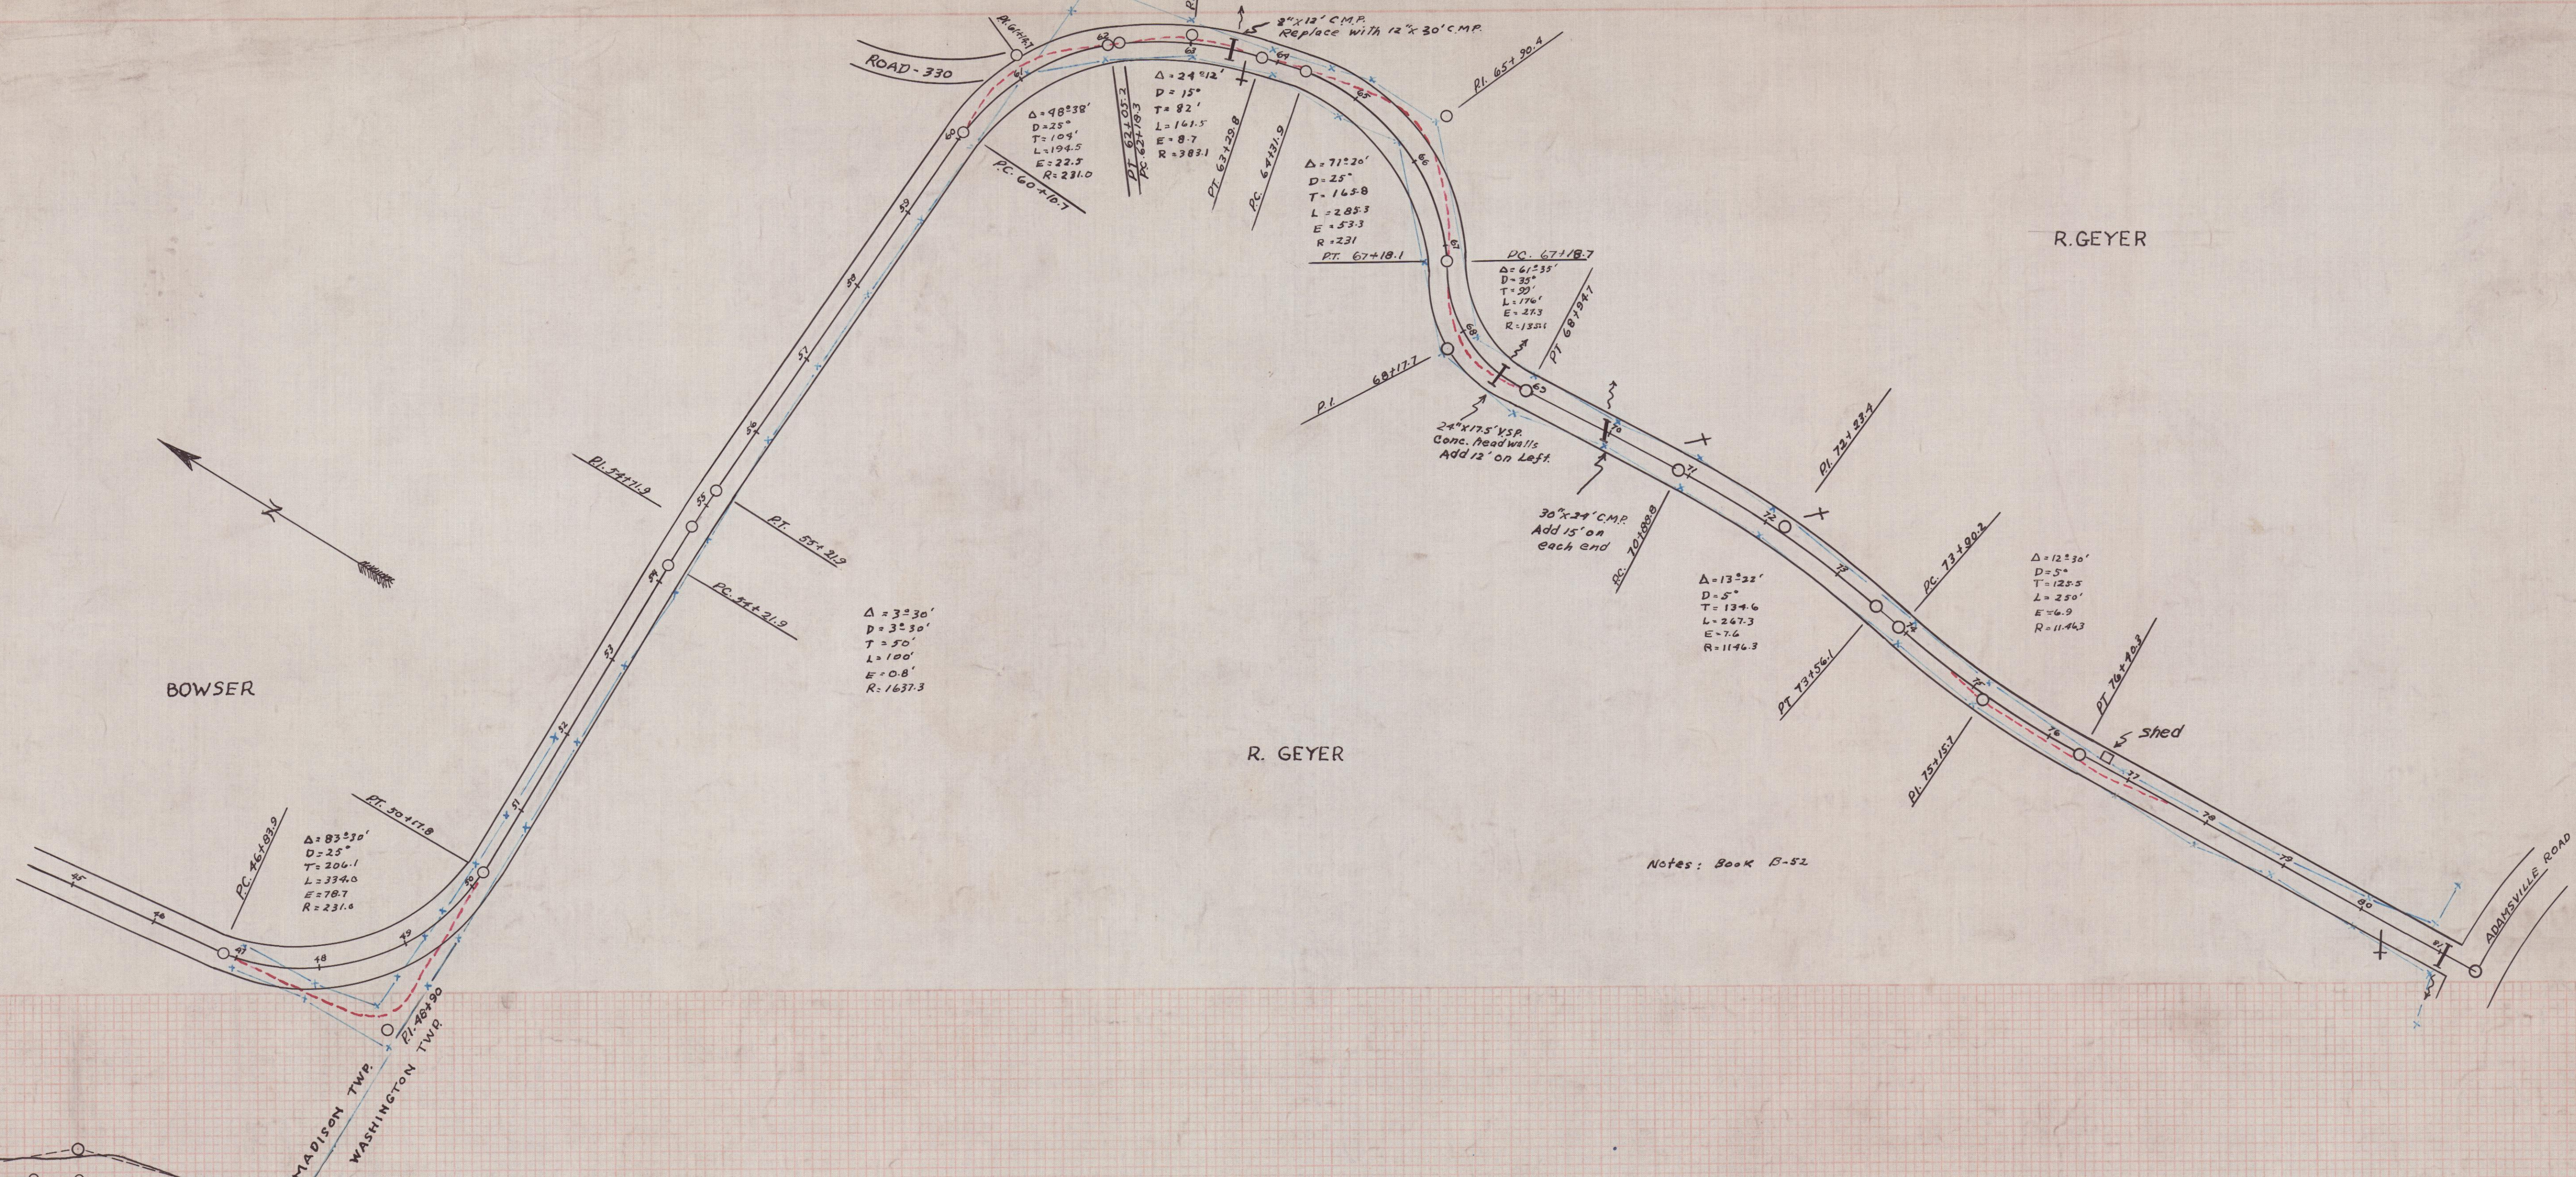


FINAL	DATE	BY
SURVEY		
REVISION		
DATE		
BY		

ORIGINAL	DATE	BY
SURVEY		
REVISION		
DATE		
BY		

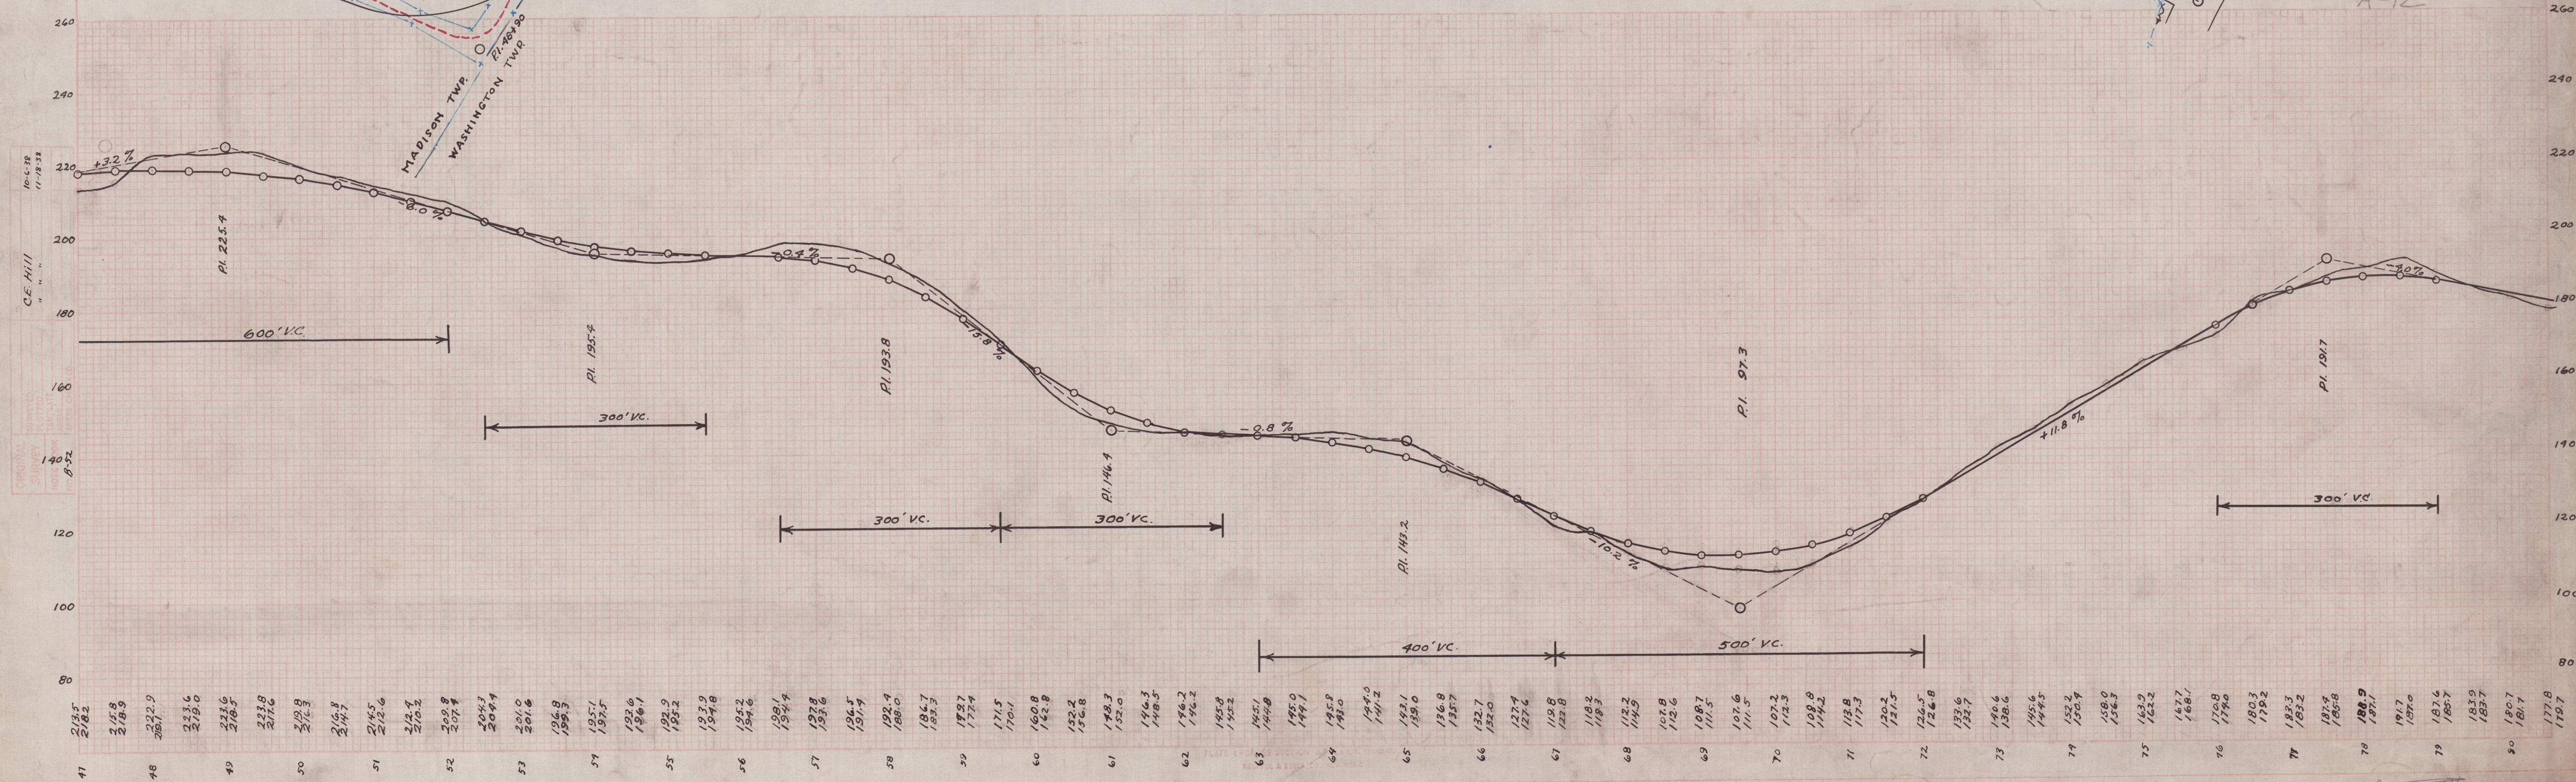

T 330 + 331

(4-12)

County Rd. 154
Madison & Wash.
A-12