


Seeding	End	Sq.
	Width	Yds.
0	14	75
16		61
21		64
25		71
26		96
43		100
29		

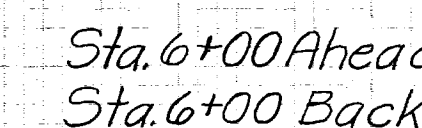

Station	End Area		Volume	
	Cut	Fill	Cut	Fill
1	0 11	0 2		
			9	13
	0	14		
			0	23
	0	27		
			0	38
	0	55		
			0	50
	0	53		
			0	59
	0	74		
			0	70
	0	77		

Q-12 Soc Sec	NAME	PLANT	55 83
2	Q-10		

**MUSKINGUM COUNTY
COUNTY ROAD NO. 8**

	3/23/62	AS CONSTRUCTED	H.F. K.
REVISION	DATE	DESCRIPTION	BY
U. S. ARMY ENGINEER DISTRICT, HUNTINGTON CORPS OF ENGINEERS HUNTINGTON, W. VA.			
DRAWN BY: <i>D.C.</i>		LICKING RIVER DILLON RESERVOIR PROJECT	
TRACED BY:		RELOCATION OF MUSKINGUM COUNTY ROAD NO. 8	
CHECKED BY: <i>F.H.S.</i>		MC-8-4 & MT-408-1 MC-8-1 & MC-408-1	
SUBMITTED BY: <i>Elmer S. Barrett</i>		ELMER S. BARRETT ASSOCIATES	
RECOMMENDED: <i>James P. ...</i>		APPROVED: <i>Steven Malevich</i> DATE: NOVEMBER 1959	
CHIEF ENG. DIV.		COL. C.E., DISTRICT ENGINEER	
ELMER S. BARRETT ASSOCIATES CONSULTING ENGINEERS CHILLICOTHE, OHIO		SCALE: 1" = 10' DRAWING NUMBER 0 2 7f-UD 14-68/ SHEET 55 OF 83	

(APPROACH RT. & STA. 54+27.60) STA. 4+50 To STA. 6+00