


End Area		Volume	
Cut	Fill	Cut	Fill
418	0		
		1023	0
687	0		
		1025	15
420	170		
		1275	6
505	330		
		707	8
00	0	296	

MUSKINGUM COUNTY
TOWNSHIP ROAD NO.409

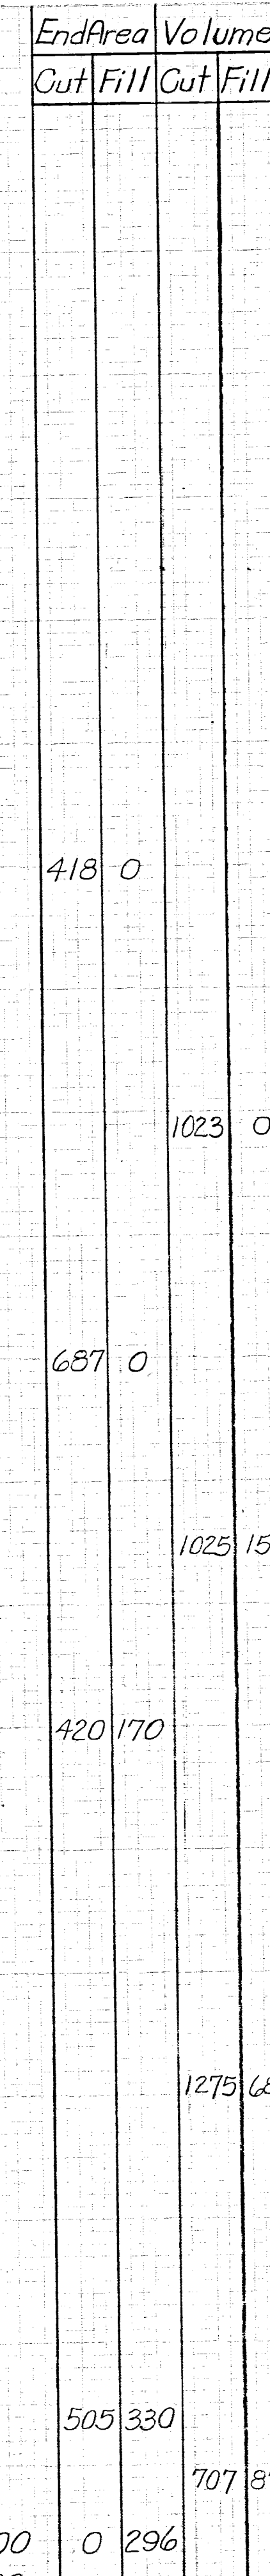

WORK AS CONSTRUCTED CROSS SECTIONS STA. 52+75.58 TO STA. 54+50